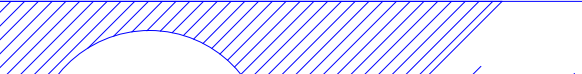

 <div>Indus Systems, Inc. 2352, Main Street, Concord MA 01742 Tel: 978-461-0555 www.indus-systems.com</div>	Drawing Title NINTH FLOOR PLAN ARCHITECTURAL		Project Title AS-BUILT Drawings		Date 10-27-2010		 <div>VAMC, WILKES BARRE</div>		 <div>VA Department of Veterans Affairs</div>	
					Approved:		Building Number 01		Checked	Drawn				
Revisions		Date	Professional Seal		Approved:		Location VAMC WILKES BARRE PENNSYLVANIA		Drawing No.					