
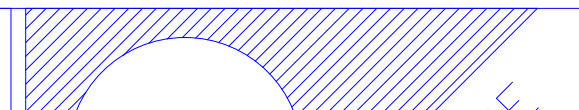



				<div><div>Indus Systems, Inc. 2352, Main Street, Concord MA 01742 Tel: 978-461-0555 www.indus-systems.com</div></div>	Drawing Title TENTH FLOOR PLAN ARCHITECTURAL		Project Title AS-BUILT Drawings		Date 10-27-2010		<div><div>VAMC, WILKES BARRE</div></div>	<div><div>Department of Veterans Affairs</div></div>
					Approved:		Building Number 01		Checked	Drawn		
Revisions		Date	Professional Seal		Approved:		Location VAMC, WILKES BARRE PENNSYLVANIA		Drawing No.			