

Indus Systems, Inc.  
2352, Main Street, Concord MA 01742  
Tel: 978-461-0555  
www.indus-systems.com

Drawing Title

ELEVENTH FLOOR PLAN  
ARCHITECTURAL

Project Title

AS-BUILT Drawings

Date

10-27-2010

Project No.


Drawing No.

Building Number  
01

Checked

Drawn

Location  
VAMC, WILKES BARRE  
PENNSYLVANIA

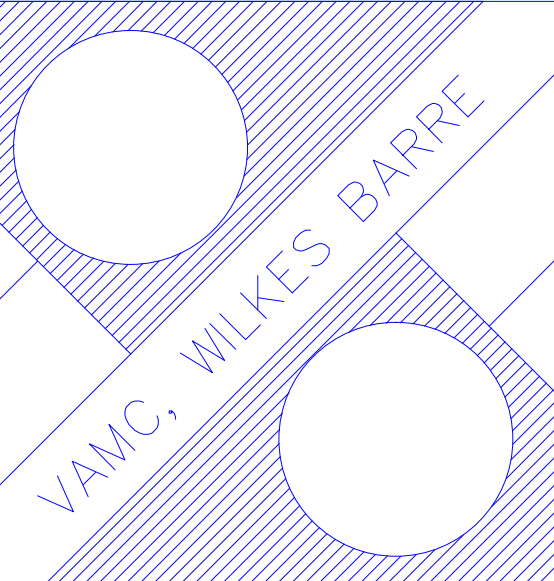

VA Department of Veterans Affairs