

A

B

C

D

E

F

1

A

B

C

D

E

F

2

Three inches = one foot

One and one half inches = one foot

One inch = one foot


Three quarters inch = one foot

One half inch = one foot


Three eighths inch = one foot

One quarter inch = one foot

One eighth inch = one foot

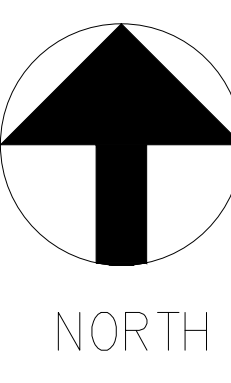

NORTH

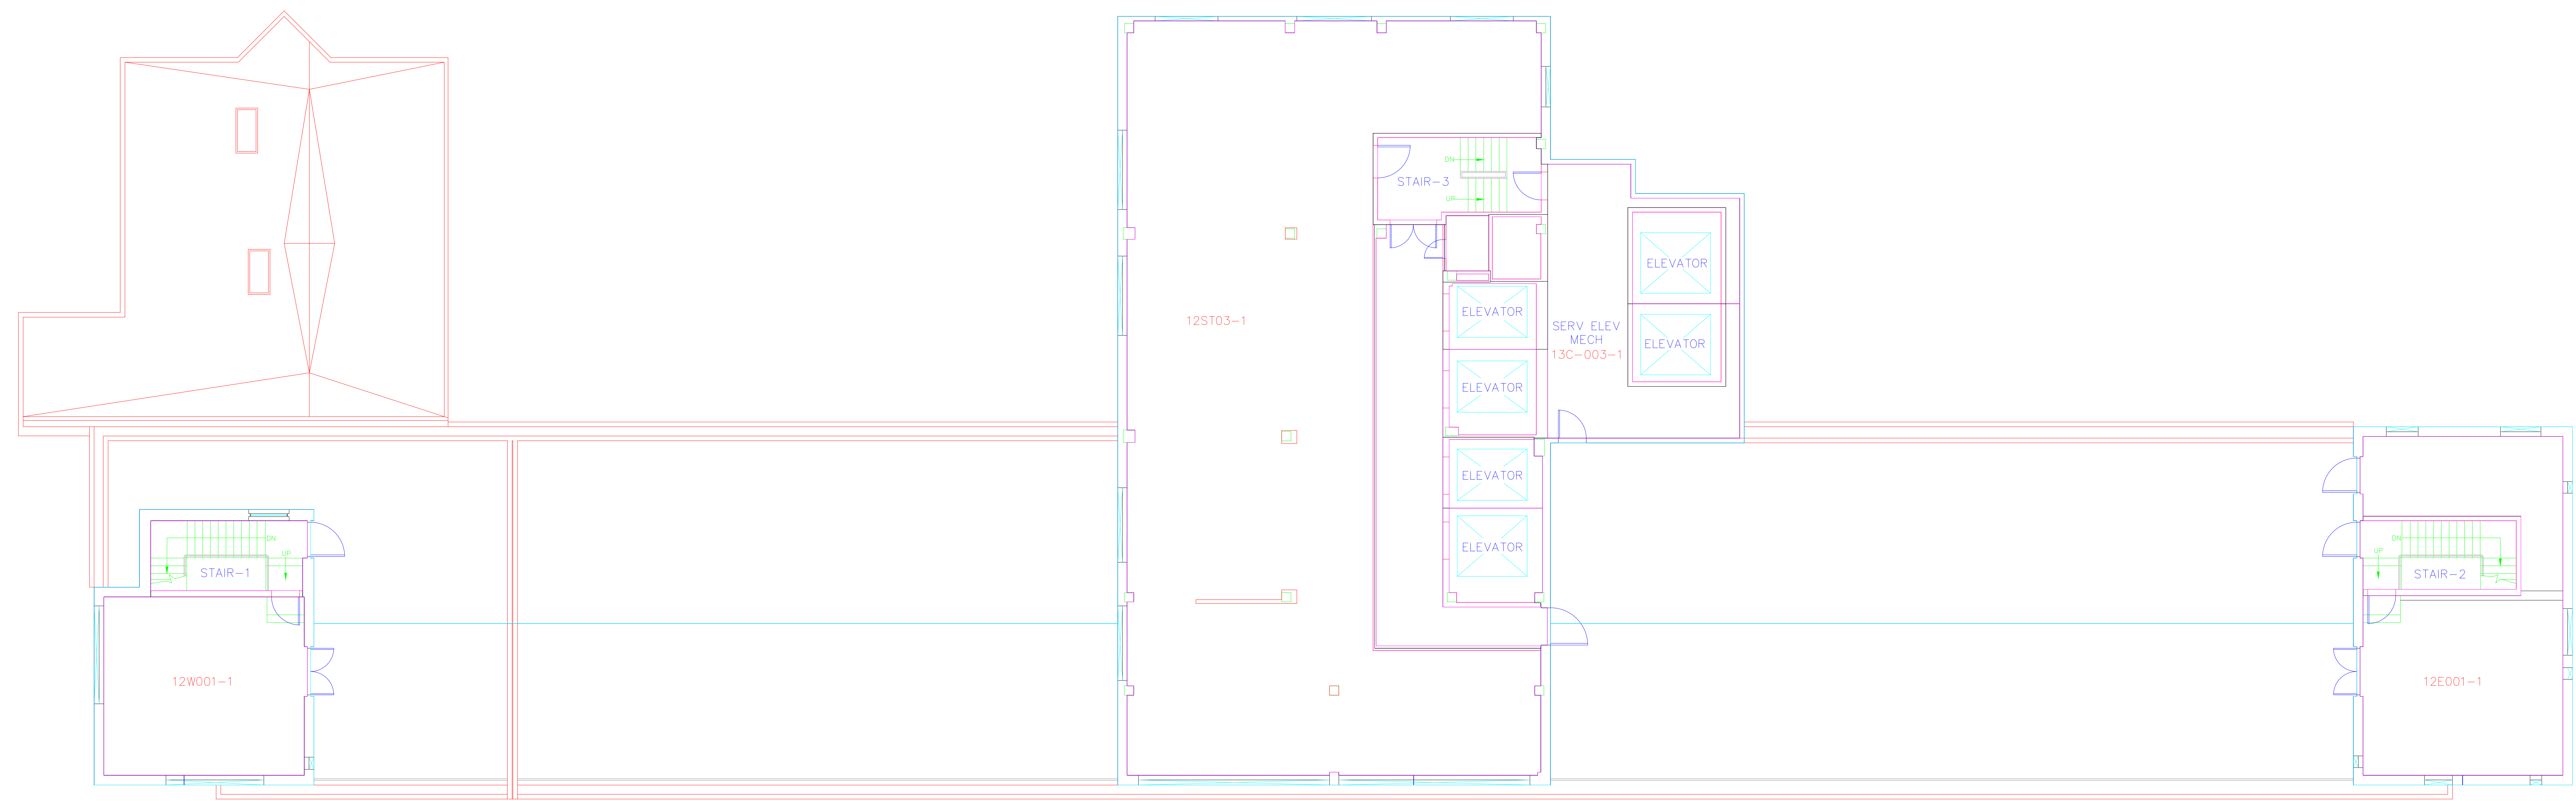

				<div><div><div>i</div></div><div>Indus Systems, Inc. 2352, Main Street, Concord MA 01742 Tel: 978-461-0555 www.indus-systems.com</div></div>	Drawing Title TWELFTH FLOOR PLAN ARCHITECTURAL		Project Title AS-BUILT Drawings		Date 10-25-2010	Project No.	Drawing No.	<div>VAMC, WILKES BARRE</div>	<div>VA Department of Veterans Affairs</div>
					Approved:		Building Number 01	Checked	Drawn				
Revisions		Date			Approved:		Location VAMC, WILKES BARRE PENNSYLVANIA						