


MEDICAL RESEARCH AND DEVELOPMENT SERVICE 218
ANIMAL RESEARCH AREA

BUILDING KEY

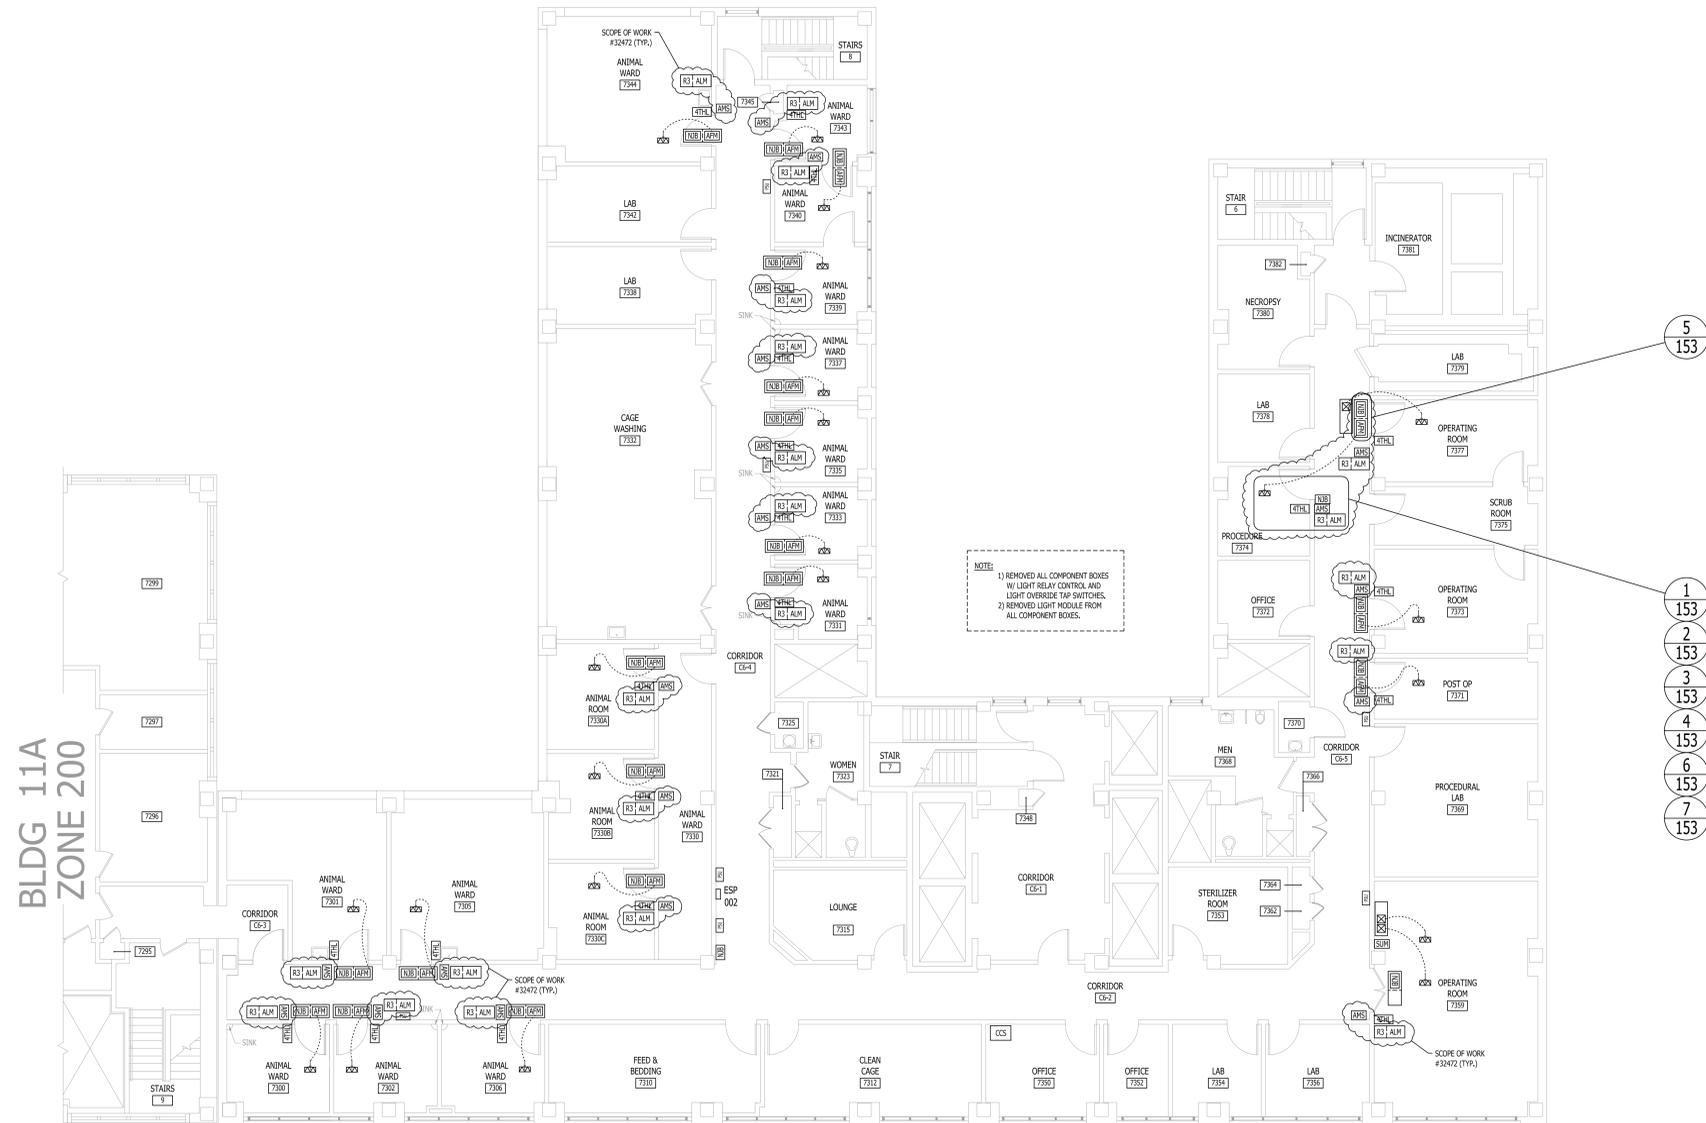

BLDG 11A
ZONE 200

NOTE:
1) REMOVED ALL COMPONENT BOXES
W/ LIGHT RELAY CONTROL AND
LIGHT OVERRIDE TIP SWITCHES.
2) REMOVED LIGHT MODULE FROM
ALL COMPONENT BOXES.

- 5
153
- 1
153
- 2
153
- 3
153
- 4
153
- 6
153
- 7
153

	COMPONENT BOX W/ AIR FLOW TRANSDUCER
	ADVANCED LIGHT MODULE W/LIGHT RELAYS FOR LIGHT CONTROL
	ALM LIGHT OVERRIDE MEMBRANE SWITCH
	ANALOG SUMMING PROCESSOR (MOUNTED ABOVE CEILING)
	COMPONENT BOX W/(2) AIR FLOW TRANSDUCERS
	AIR FLOW SENSOR TUBING
	COMPONENT BOX W/NETWORK CARD AND AIR FLOW MODULE
	AIR FLOW INSERT IN DUCTWORK
	SENSOR MODULE 4 FOR TEMPERATURE, HUMIDITY AND LIGHT
	NETWORK JUNCTION BOX
	POWER SUPPLY UNIT
	ENVIRONMENTAL SENTRY PANEL - SURFACE MOUNTED
	CENTRAL COMPUTER STATION

LEGEND

ENVIRONMENTAL WATCHDOG (ESP) SYSTEM FOR:
JESSE BROWN V.A. MEDICAL CENTER
BUILDING 11B/7TH FLOOR/MEDICAL R&D SERVICE 278
CHICAGO, IL

REV.	JOB NO.	REVISION	DRAWN	APPROVER 1	APPROVER 2	REV.	JOB NO.	REVISION	DRAWN	APPROVER 1	APPROVER 2	REV.	JOB NO.	REVISION	DRAWN	APPROVER 1	APPROVER 2
A	153-0108	QUOTE DENTAL DRAWING RELEASE	08-04-2109	03-02-1108	08-04-2108	1	153-0108	SUBMITTAL: REMOVED (2) COMP. BOXES WITH LIGHT RELAYS (RX ALM) & REMOVED (20) LAMP FROM EXISTING COMP. BOXES A (20) LAMP. ADDED ALM & AMPS TO (2) ROOMS. ADDED AIR FLOW INSERT & SINK IN ROOM P3374. EXISTING COMP. BOX TO ADD AFM BY ROOM P3377. MOVED (11) COMPONENT BOXES FROM CORRIDOR INTO ROOM ABOVE CEILING IN CORRIDOR C6-4 & ANIMAL WARD 7390. MOVED (2) COMP. BOXES INTO ROOM P3399 FROM CORRIDOR. REVISE LEGEND. REMOVED SIZE MARK TO.	08-04-2109	03-02-1108	08-04-2109	1	153-0108		08-04-2109	03-02-1108	08-04-2109
B	153-0108	AS-BUILT: ADD SUMMING PROCESSOR, CE (W/2) AF TRANSDUCERS AND (1) PSU FOR RM 7395. REMOVE SINK FROM RM 7394. RM 7394.	08-04-2109	03-02-1108	08-04-2108	2	153-0108		08-04-2109	03-02-1108	08-04-2109	2	153-0108		08-04-2109	03-02-1108	08-04-2109
C	153-0108	AS-BUILT: RM 7395 IN CORRIDOR C6-5 OUTSIDE RM 7373. PROJECT COMPLETE.	08-11-1507	03-12-2057	08-02-1108	3	153-0108		08-11-1507	03-12-2057	08-02-1108	3	153-0108		08-11-1507	03-12-2057	08-02-1108
D	153-0108	RM AS-BUILT: MOVE EQUIPMENT FROM RM 7375 TO 7377. UPDATE LEGEND, PROJECT COMPLETE.	08-04-2109	03-02-1108	08-04-2109	4	153-0108		08-04-2109	03-02-1108	08-04-2109	4	153-0108		08-04-2109	03-02-1108	08-04-2109

PROPRIETARY DATA-INFORMATION:
When applicable, the detail views on this drawing incorporate third angle projection.
Reproduction or disclosure of data or information contained hereon without the explicit consent of Edstrom is forbidden.



PLT SCALE	1/8" = 1'-0"	E BORD	REV.
DRN BY	GJH	DATE	03-18-05
DRAWING NO.		5110-9156-107.1	