

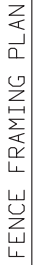 
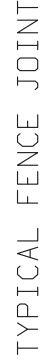



Submittal Details	CMHP
<b>Submittal Package:</b> 05 50 00 - 060.2 <b>Submittal Item:</b> EWP06-055000-056.2 <b>Specification Ref:</b> <b>Notes:</b> DNT Mental Health Courtyard <b>Wire Wall Shop Drawings</b>       	<div style="display: flex; justify-content: space-between;"> <div>           A. No Exceptions            B. Approved as noted            C. Revise &amp; Resubmit            D. Rejected            E. Submitted for Informational Purposes Only         </div> <div style="text-align: center;"> <input checked="" type="checkbox"/>  <input type="checkbox"/>  <input type="checkbox"/>  <input type="checkbox"/>  <input type="checkbox"/> </div> </div> <p>This review is for general conformance with Plans and Specifications only. Any deviations from same not clearly noted by the Preparer have not been reviewed. Review shall not constitute a complete check of detailed dimensions or count or serve to relieve the Preparer of contractual responsibility for any error or deviation from contract requirements.</p> <p>By <u>Caitlin Weber</u> Date <u>03/18/2015</u></p>
<b>StudioNOVA</b>	<b>Department of Veterans Affairs</b>
<b>Submittal Review</b> <input type="checkbox"/> APPROVED <input type="checkbox"/> APPROVED AS NOTED No resubmission necessary <input type="checkbox"/> PARTIALLY APPROVED AS NOTED Revise and resubmit as noted <input type="checkbox"/> NOT APPROVED Revise and resubmit as noted <input type="checkbox"/> NO ACTION REQUIRED For information only <input type="checkbox"/> REVIEWED ONLY FOR:    Refer to Division 1 - General Requirements in the project Specifications for explanation of the review response By: <u>Steve Kopf</u> Date: <u>April 2, 2015</u> Submittal No: <u>05 50 00 - 060.2 DNT</u> <u>MENTAL HEALTH COURTYARD WIRE</u> <u>WALL SHOP DRAWING</u>  <div style="text-align: right;">studio <b>NOVA</b></div>	

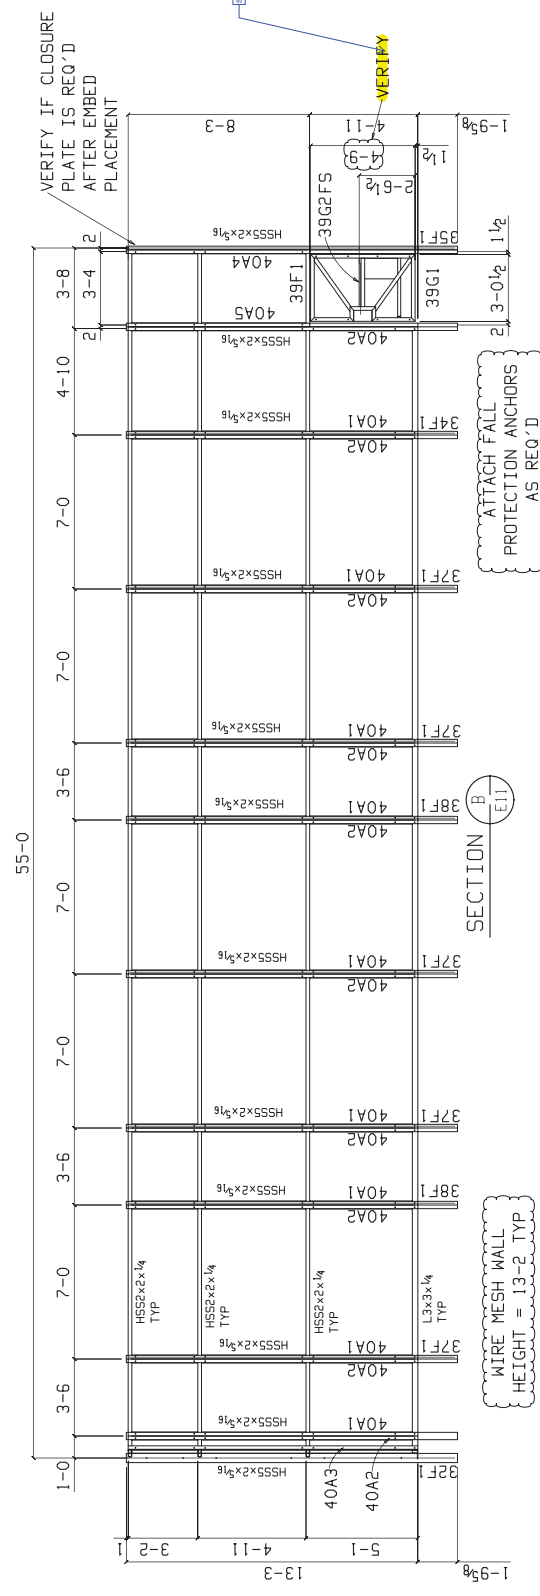


GENERAL NOTES			
1. MATERIAL: ASTM A36-PLATES, SHAPES AND BARS ASTM A500-STEEL TUBING 2. WELDS: ELECTRODES E70XX 3. PAINT: GALV. AND PAINT SEMI GLOSS BLACK EPOXY PAINT TO MATCH WIRE MESH			
OSIYO METALS, L.L.C.			
800 NORTH DAWGWOOD AVE.		PH. (910) 558-0173	
BROKEN ARROW, OK. 74012		FAX: (918) 558-1170	
SUCHS REPLACEMENT MEDICAL CENTER			
NEW ORLEANS, LOUISIANA			
STUDIO 90/VA			
PROJECT		CONTRACTOR	
LOCATION		FENCE	
ARCHITECT		SECT	
SUBJECT			
DRAWN BY			
MAH		CHECKED BY	DWG. No.
BM		DATE	SHT. E11
		7-6-2014	14-0891

DATE	REVISIONS	No.	BY
10-7-14	RE-ISSUED FOR APPROVAL	E	M&H
12-19-14	RE-ISSUED FOR APPROVAL	F	M&H
8-4-14	RE-ISSUED FOR APPROVAL	G	M&H
3-10-15	ISSUED FOR FABRICATION	0	M&H

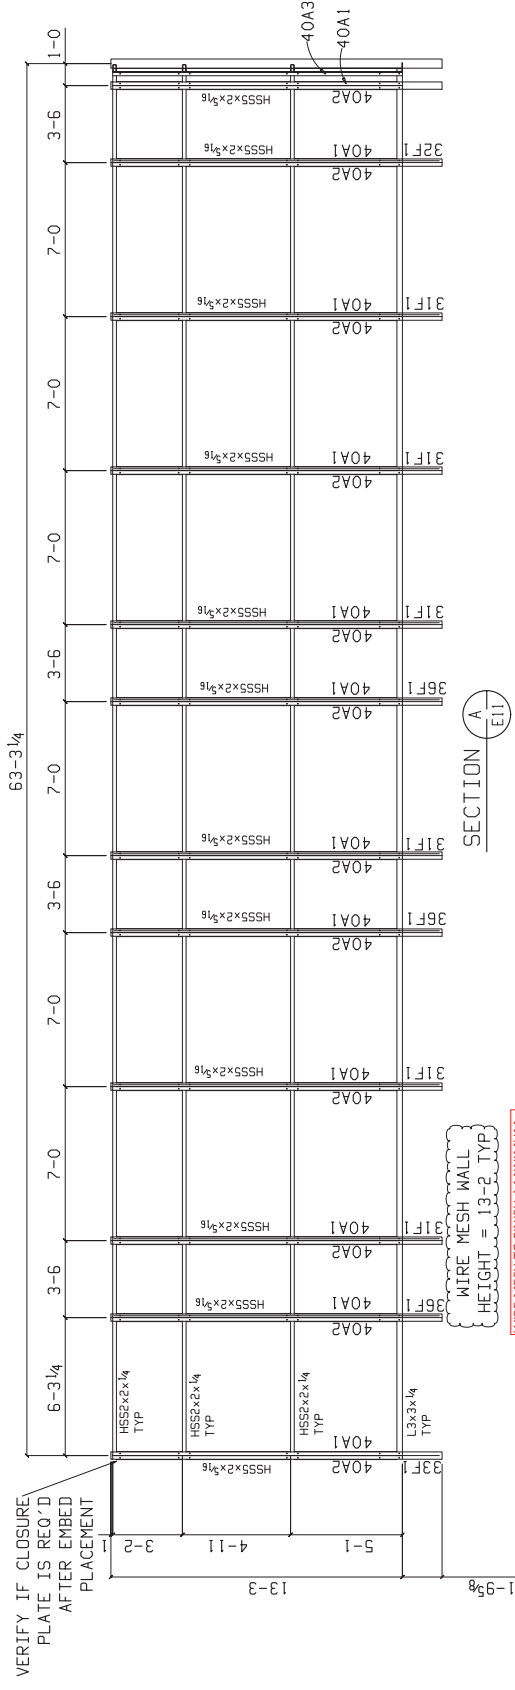


- GENERAL NOTES
1. MATERIAL-ASTM A36-PLATES, SHAPES AND BARS
  2. WELDS-ELECTRODES E70XX
  3. PAINT- GALV. AND PAINT SEMI GLOSS BLACK EPOXY PAINT TO MATCH WIRE MESH

DATE	3-10-15	BY	0	ISSUED FOR FABRICATION	M&H
DATE	8-4-14	BY	G	RE-ISSUED FOR APPROVAL	M&H
DATE	12-19-14	BY	F	RE-ISSUED FOR APPROVAL	M&H
DATE	10-7-14	BY	E	RE-ISSUED FOR APPROVAL	M&H
REVISIONS					
SUBJECT	FENCE FRAMING PLAN & SECTIONS	CHECKED BY	BM	DATE	7-16-2014
CONTRACTOR	BEC	DRAWN BY	M&H	JOB No.	14-13891
ARCHITECT	STUDIO NOVA			DWG No.	SHT E12
LOCATION	NEW ORLEANS, LOUISIANA				
PROJECT	SLVCS REPLACEMENT MEDICAL CENTER				
	1801 NORTH INDIANWOOD AVE. PH: 918/258-4717				
	BROKEN ARROW, OK 74012 FAX: 918/259-1770				
	OSIYO METALS, L.L.C.				

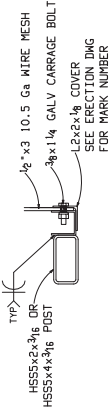

TYP WIRE MESH CONNECTION

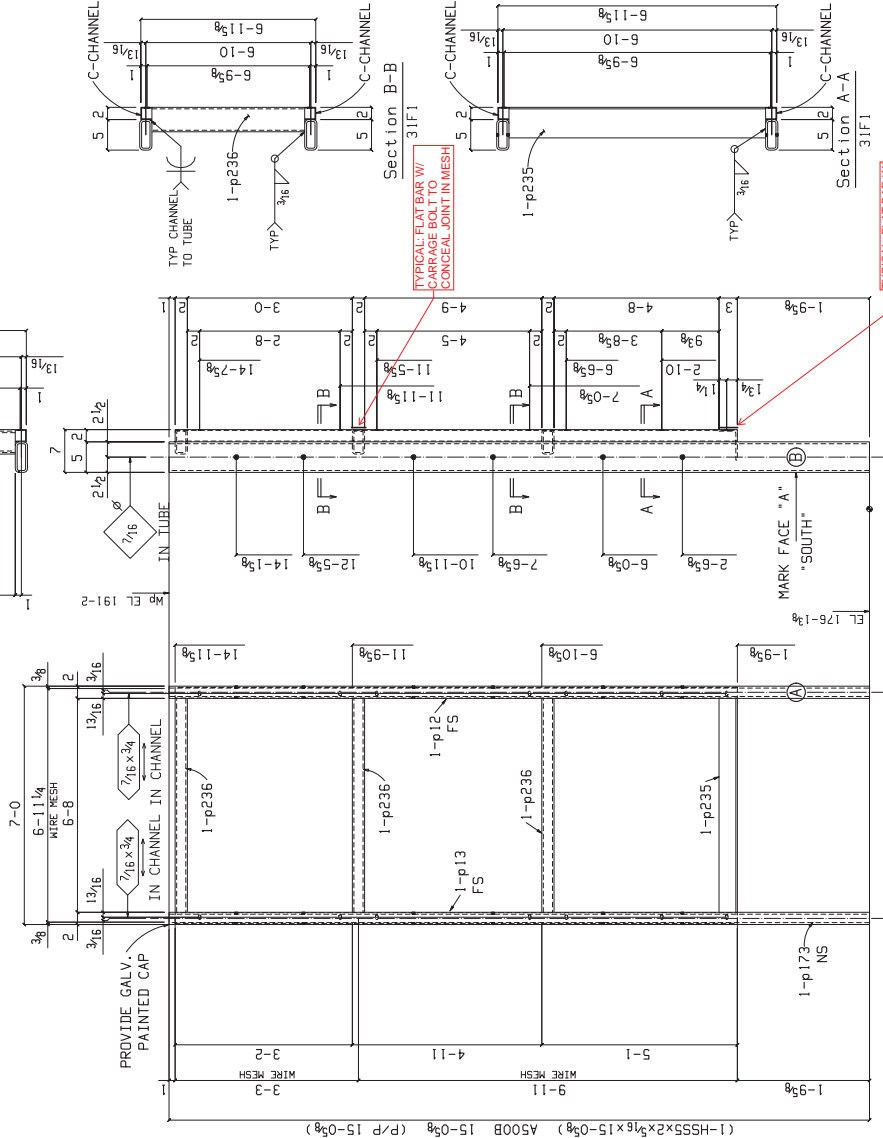

6 COLUMNS 31F1

BILL OF MATERIAL

MARK	QTY	DESCRIPTION	LENGTH	REMARKS
1	1	6' x 11 1/4' WIRE MESH	15' 0"	141' AS00B
2	1	6' x 8' WIRE MESH	15' 0"	141' AS00B
3	1	6' x 8' WIRE MESH	15' 0"	141' AS00B
GENERAL NOTES

1. MATERIAL: ASTM A36-PLATES, SHAPES AND BARS  
ASTM A500-STEEL TUBING
2. WELDS: ELECTRODES E70XX
3. PAINT: GALV. AND PAINT SEMI GLOSS BLACK EPOXY PAINT TO MATCH WIRE MESH

OSIYO METALS, L.L.C.


1801 NORTH INDIANWOOD AVE. PH: (918) 258-4717  
BROKEN ARROW, OK 74012 FAX: (918) 259-1170

PROJECT	SLVHGS REPLACEMENT MEDICAL CENTER
LOCATION	STUDIO NOVA
ARCHITECT	ISEC
CONTRACTOR	ISEC
SUBJECT	FENCE DETAILS

DATE	BY	NO.	REVISIONS
3-10-15	M&H	0	ISSUED FOR FABRICATION
6-14-14	M&H	1	RE-ISSUED FOR APPROVAL
12-19-14	M&H	2	RE-ISSUED FOR APPROVAL
10-7-14	M&H	3	RE-ISSUED FOR APPROVAL

DRAWN BY	CHECKED BY	DATE	JOB No.	DWG No.
M&H	BM	7-16-2014	14-13891	SHT. 31

BILL OF MATERIAL				
ROW	QTY	DESCRIPTION	LENGTH	REMARKS
257	1	8x16 GALV. PLATE	15'-0"	157 AS00B
258	1	8x16 GALV. PLATE	15'-0"	157 AS00B
259	1	8x16 GALV. PLATE	15'-0"	157 AS00B
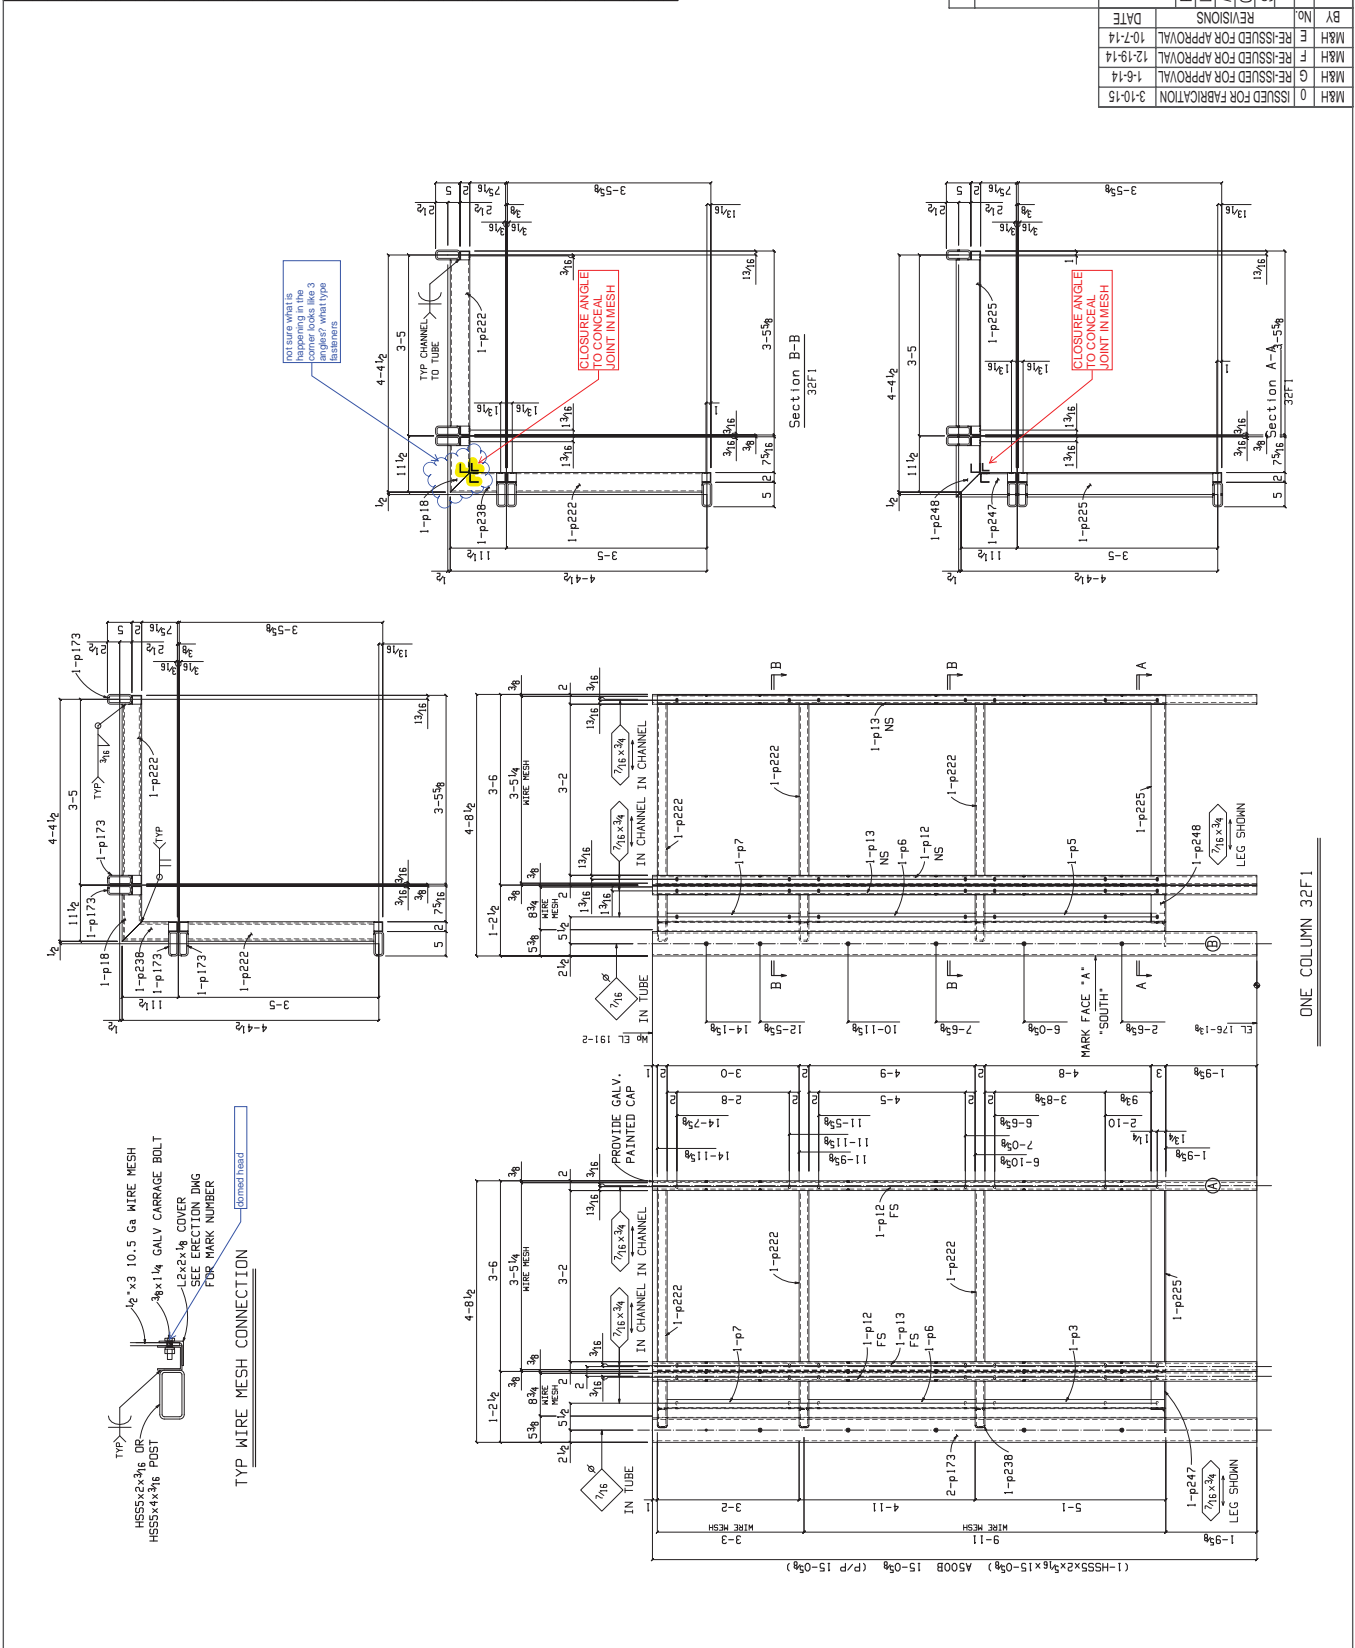


















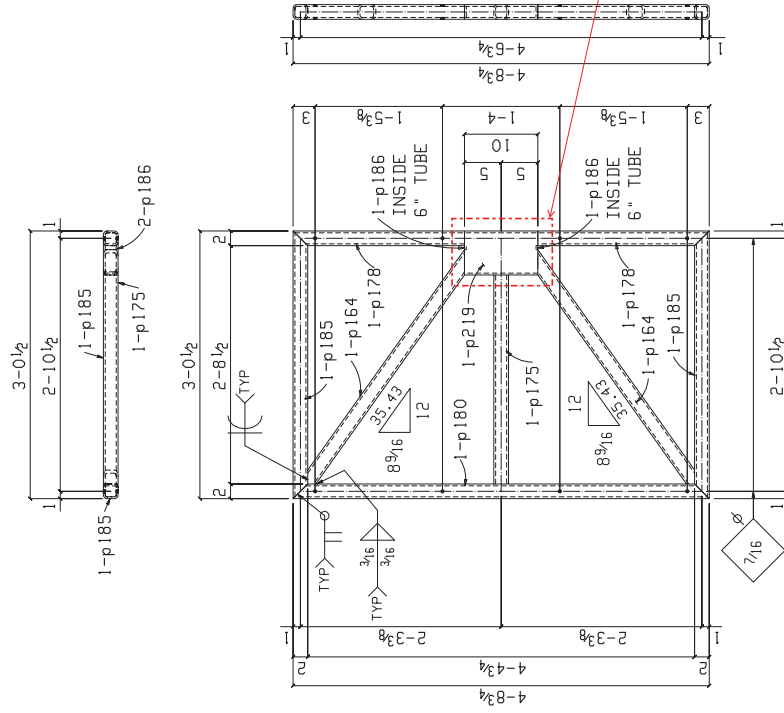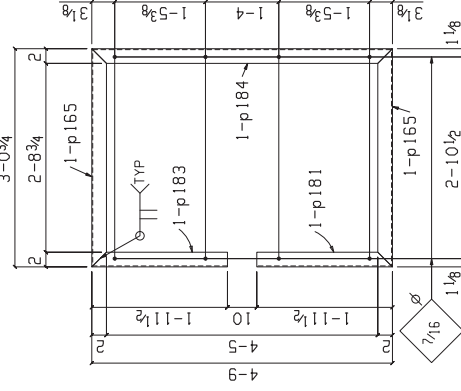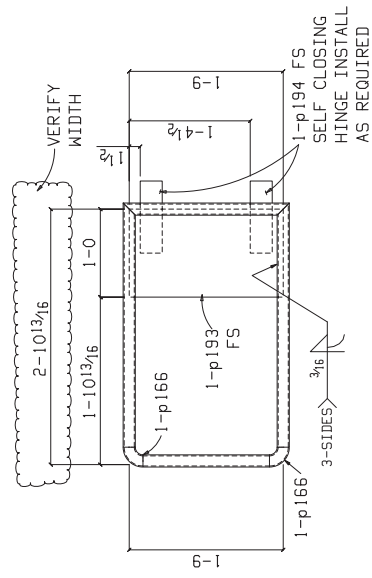

M&H	0	ISSUED FOR FABRICATION	3-10-15
M&H	G	RE-ISSUED FOR APPROVAL	1-6-14
M&H	F	RE-ISSUED FOR APPROVAL	12-19-14
M&H	E	RE-ISSUED FOR APPROVAL	10-7-14
BY	NO.	REVISIONS	DATE

M&H	0	ISSUED FOR FABRICATION	3-10-15
M&H	G	RE-ISSUED FOR APPROVAL	1-6-14
M&H	F	RE-ISSUED FOR APPROVAL	12-19-14
M&H	E	RE-ISSUED FOR APPROVAL	10-7-14
BY	NO.	REVISIONS	DATE

OSIYO METALS, L.L.C.

1801 NORTH INDIANWOOD AVE.  
BROKEN ARROW, OK 74012  
PH: (918) 258-4717  
FAX: (918) 259-1170

PROJECT	SLVHCS REPLACEMENT MEDICAL CENTER
---------	-----------------------------------

PROJECT	SLVHCS REPLACEMENT MEDICAL CENTER
---------	-----------------------------------

PROJECT	SEVICS REFACEMENT MEDICAL CENTER
LOCATION	NEW ORLEANS, LOUISIANA

LOCATION	NEW ORLEANS, LOUISIANA
ARCHITECT	STUDIO NOVA

CONTRACTOR	STUDIO NOVA
ISFC	

CONTRACTOR	ISEC
SUBJECT	FENCE DETAILS

SUBJECT	REFERENCE DETAILS

DRAWN BY	CHECKED BY	DATE	JOB NO.
----------	------------	------	---------

DRAWN BY	CHECKED BY	DATE	JOB NO.
M&H	BM	7-16-2014	14-13991

M&H	BW	7-16-2014	14-13991
-----	----	-----------	----------

## GENERAL NOTES

1. MATERIAL: ASTM A36-PLATES, SHAPES AND BARS

1. MATERIAL. ASTM A36 PLATES, SHAPES AND BARS  
ASTM A500-STEEL TUBING

2. WELDS: ELECTRODES E70XX

2. WELDS: ELECTRODES E70XX  
3. PAINT: GALV. AND PAINT SEMI GLOSS BLACK

3. PAINT: GALV. AND PAINT SEMI GLOSS BLACK  
EPOXY PAINT TO MATCH WIRE MESH

BILL OF MATERIAL				
MARK	QTY	DESCRIPTION	LENGTH	REMARKS
3561		ONE GATE		131
3562		1 HSSX-2-4	0 10	10 HSSOB
3563		1 HSSX-2-4	4 8 1/4	24 HSSOB
3564		2 HSSX-2-4	3 2 1/4	31 HSSOB
3565		2 HSSX-2-4	3 0 1/4	31 HSSOB
3566		1 HSSX-2-4	2 4 1/4	17 HSSOB
3567		1 HSSX-2-4	1 1 1/4	20 HSSOB
3568		2 PLAIN	0 1 1/4	0 HSS
3569				
3570				
3571		ONE SAFETY GATE		42
3572		1 PIPE 1/4 STD	5 0	20 HSS
3573		2 1/4 STD ELBOW	1 5	10 HSS
3574		1 PLAIN IP	0 5 1/4	4 HSS
3575		2 SLOD CLIMBING FRAME		
3576				
3577		ONE FRAME	4 5	24
3578		1 1/2x2-4	3 0 1/4	10 HSS
3579		2 1/2x2-4	1 11 1/4	3 HSS
3580		1 1/2x2-4	1 11 1/4	3 HSS

