

SUBMITTAL TRANSMITTAL

[illegible]

No exceptions taken. RJP 4/17/2018


VETERANS AFFAIRS  
MEDICAL CENTER – ERIE, PA

☐ APPROVED

☒ APPROVED AS NOTED

☐ DISAPPROVED- *REVISE and RESUBMIT*

☐ FOR INFORMATION ONLY

  
\_\_\_\_\_  
Rob Petrone  
General Engineer, COR

17. April, 2018  
\_\_\_\_\_  
Date



3125 Brandes Street  
Erie, PA 16514  
814-453-4761 Business  
814-455-2715 Fax

## SUBMITTAL COVER SHEET

Keystone Electric Division of Zenith Systems approves and submits these shop drawings and samples and thereby represents that he has determined and verified all field measurements, field construction criteria, materials, catalog numbers and similar data and that he has checked and coordinated each shop drawing and sample with the requirements of the work and of the contract documents and with work of other contractors.

Date: January 18, 2018

Project: VAMC Community Living Center Minor

Contract Number:

Keystone Electric  
Division of Zenith Systems

Project Number: 16.57033

Signature: *Jacob Post*

Specification Section: 27-52-23

Product: Nurse Call Drawings

Submittal Number: Forty (40)

Supplier: Hill Rom

Manufacturer: Navicare

Remarks: Please Review & Return

**KEYSTONE ELECTRIC  
DIVISION OF ZENITH SYSTEMS  
P.O. BOX 10245  
ERIE, PENNSYLVANIA 16514**

**APPROVED**

**BY : Jacob Post  
DATE: 1/18/2018**



X REVIEWED  
— MAKE CORRECTIONS NOTED  
— RESUBMIT FOR RECORD  
— REVISE AND RESUBMIT  
— REJECTED  
— NOT REVIEWED – RECEIVED FOR RECORD PURPOSES ONLY

Reviewing is for conformance with the design concept of the Project and compliance with the information given in the Contract Documents. Contractor is responsible for dimensions to be confirmed and correlated at the job site; for information that pertains solely to the fabrication processes or to techniques of construction and for coordination of the work of all trades.





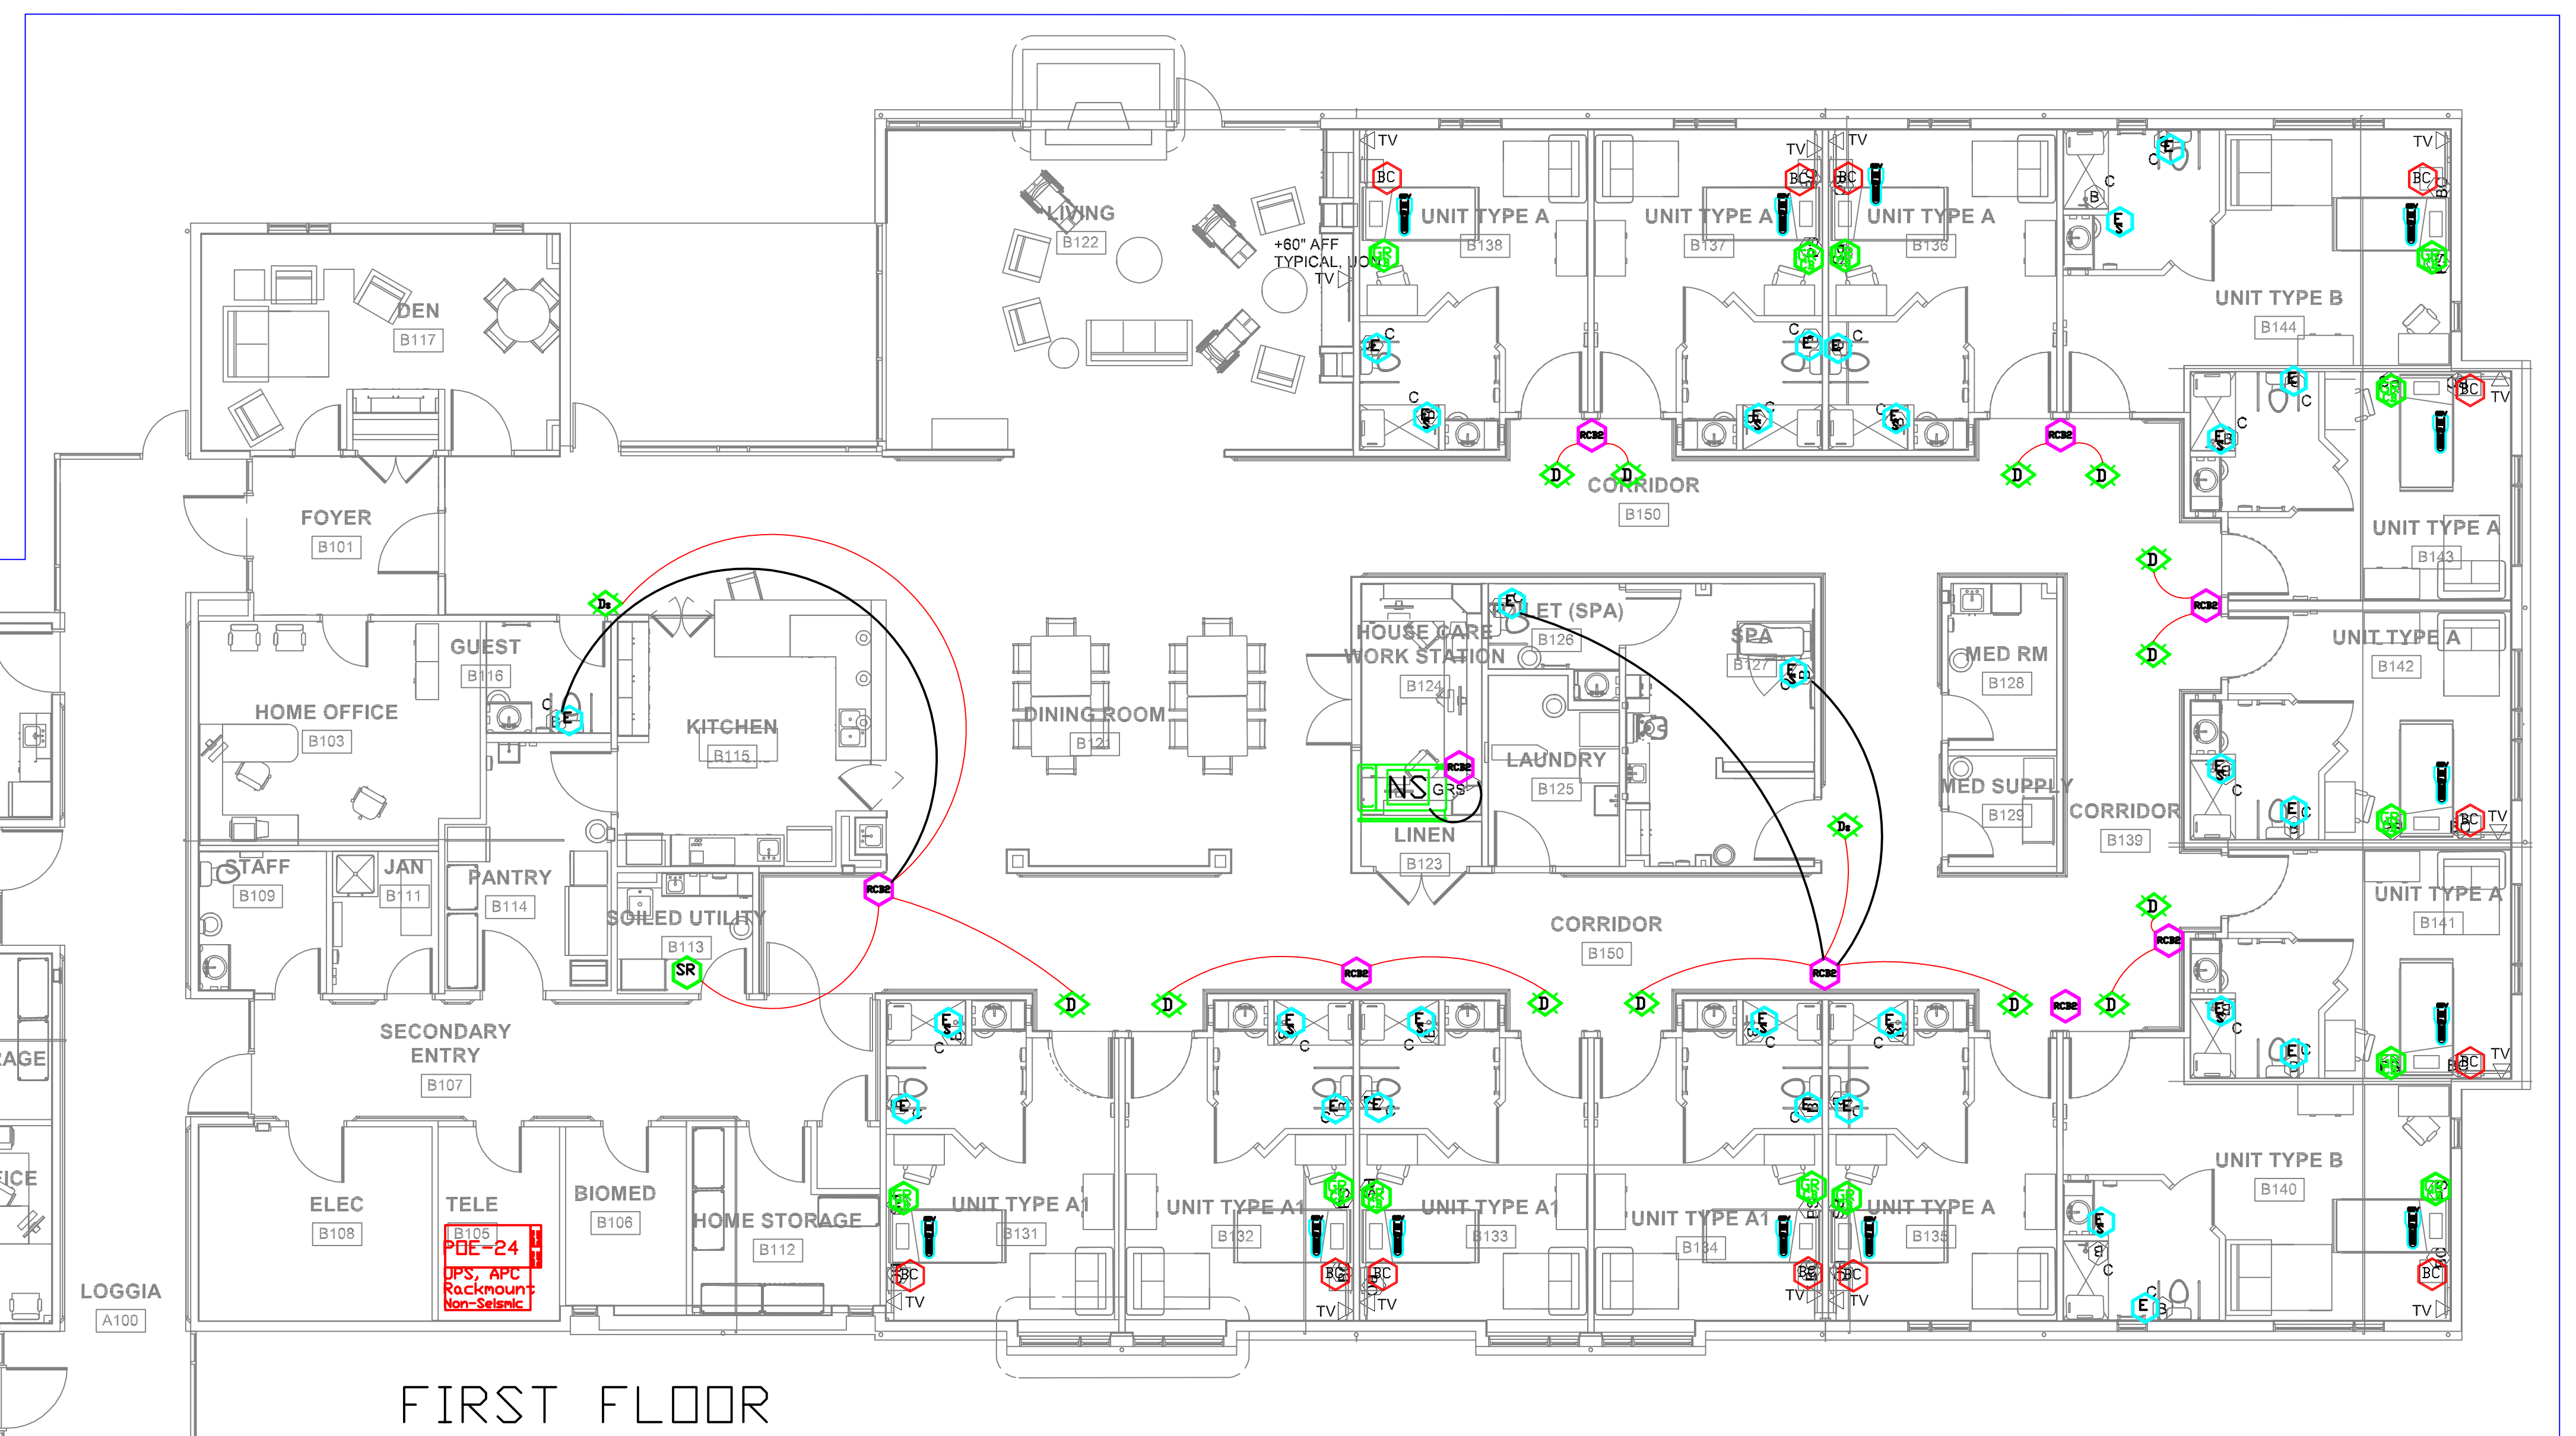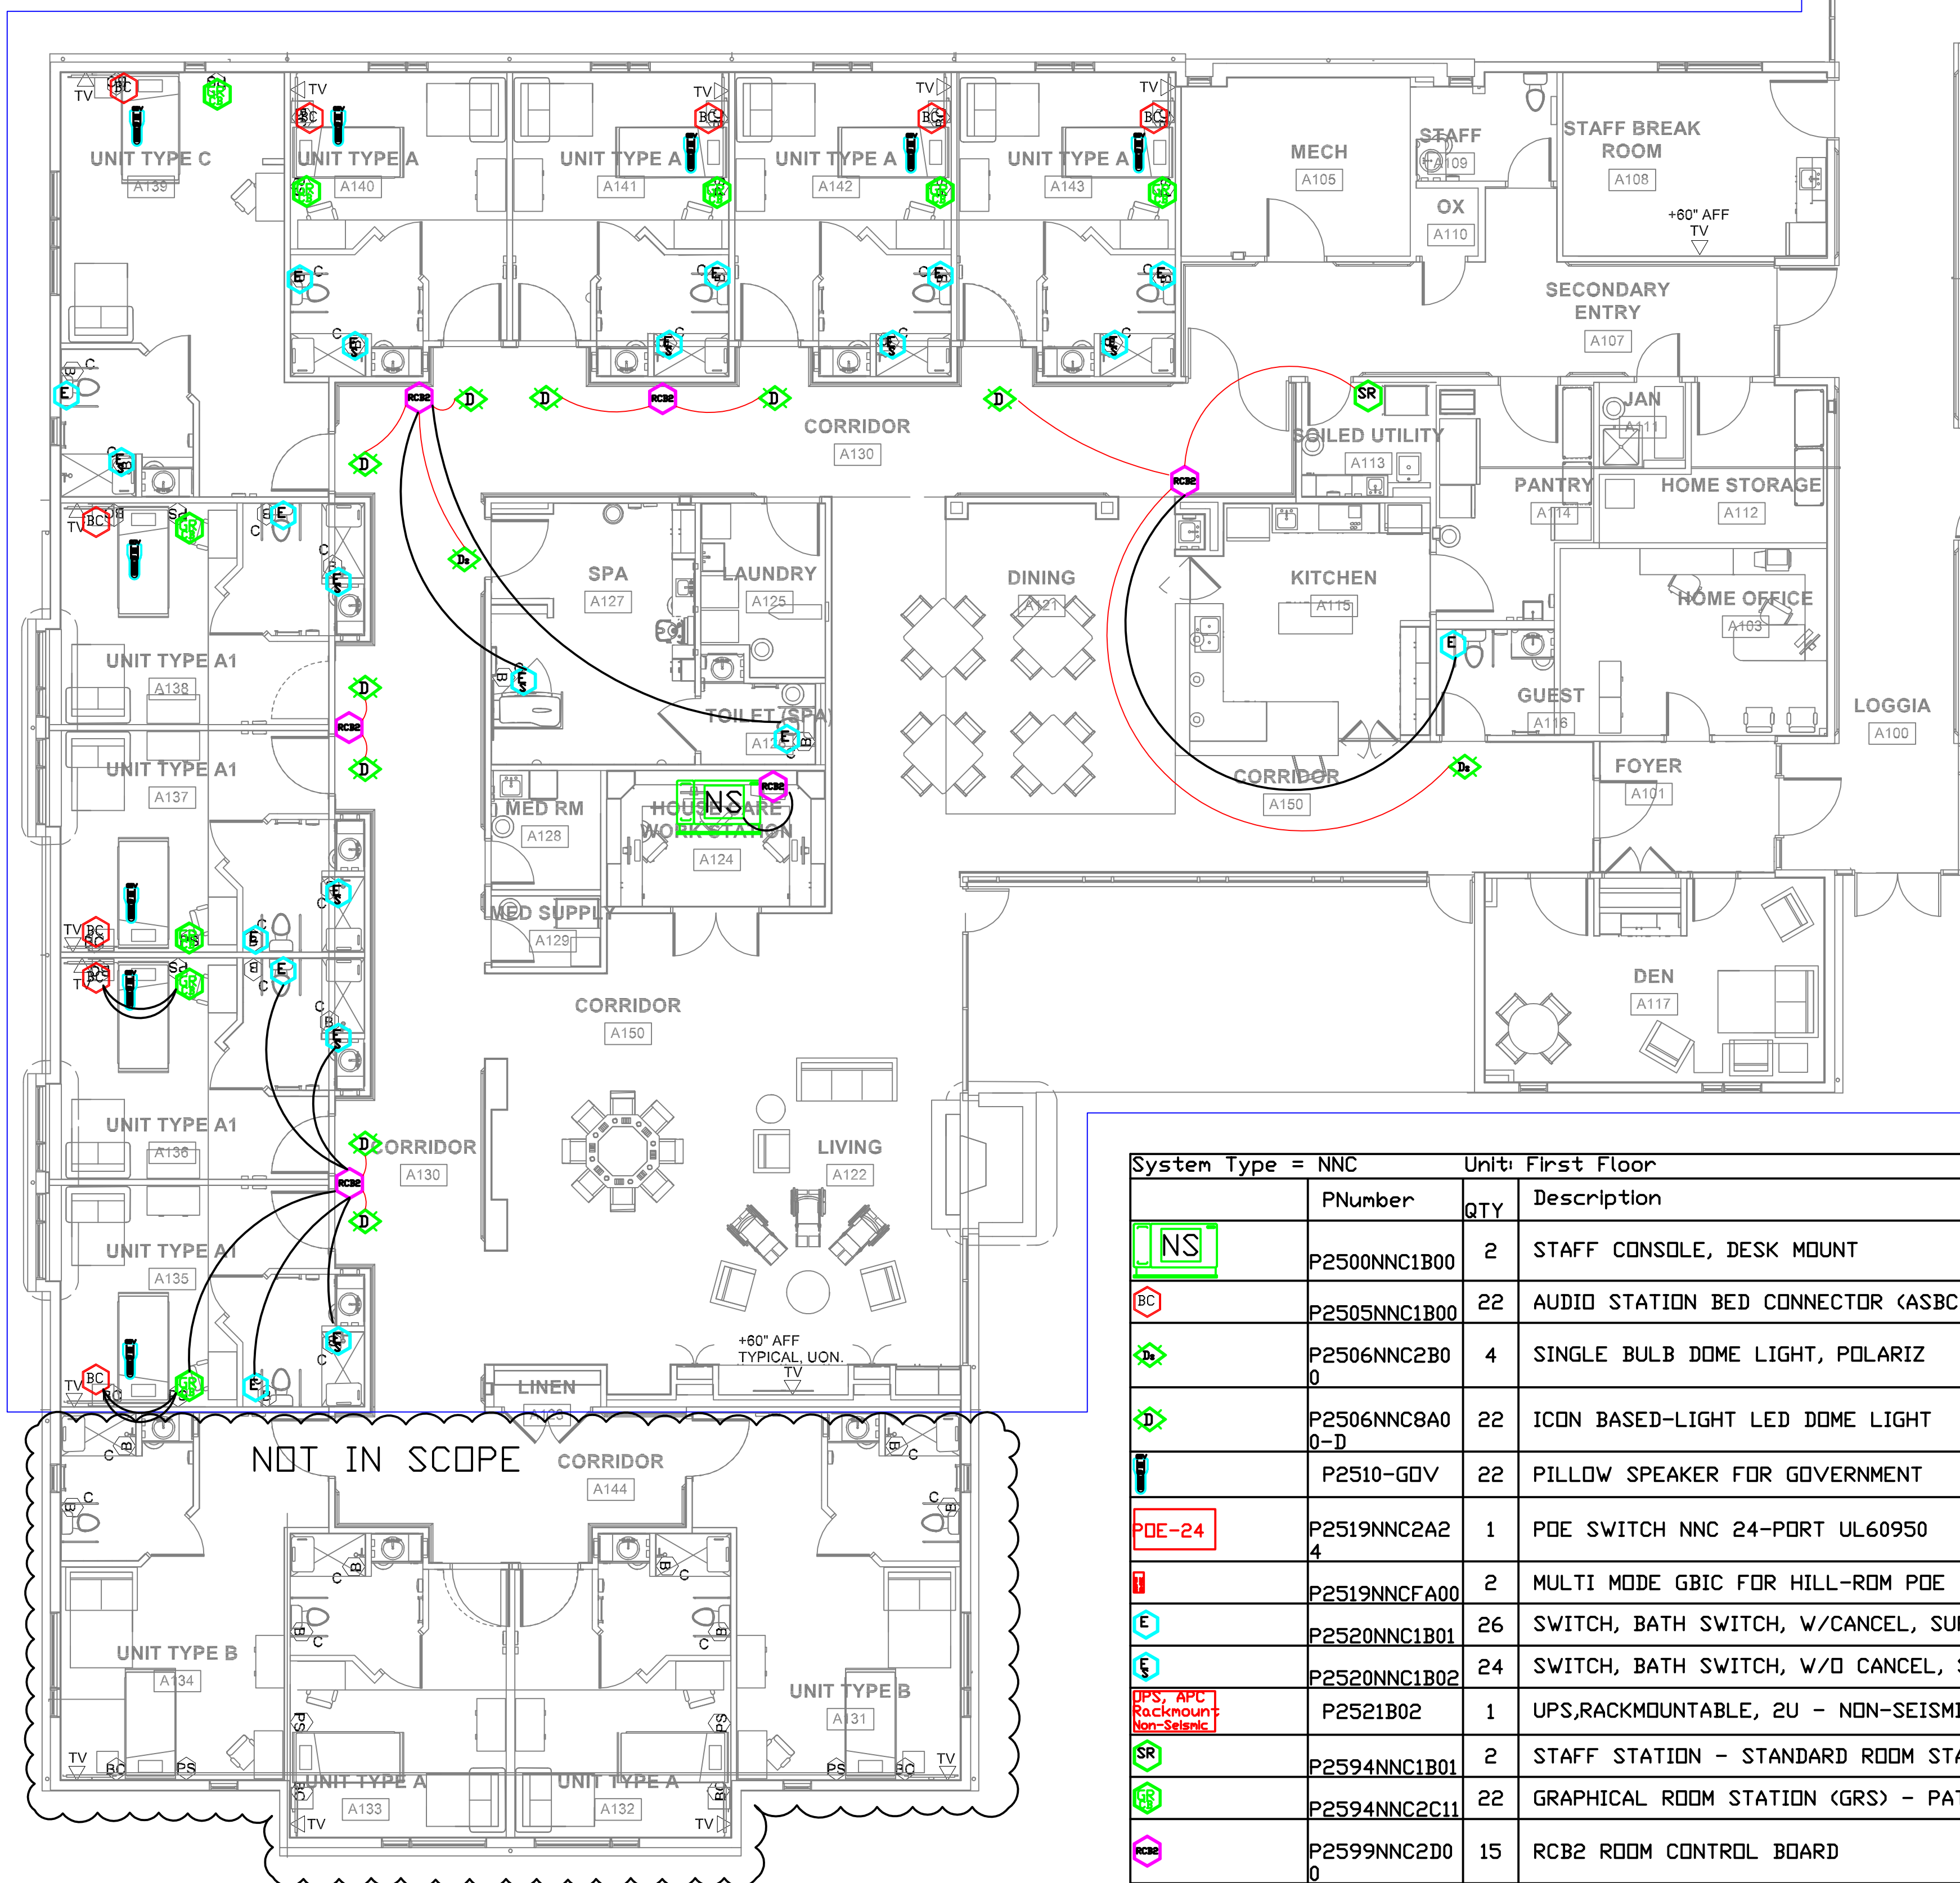


BY megbert DATE 04/13/2018


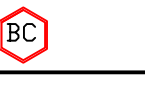



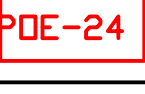



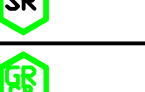


DLR Group | Westlake Reed Leskosky  
1422 Euclid Ave., Suite 300, Cleveland, Ohio 44115-1407

1. ADDED ROOM CONTROL BOARDS FOR GRS-10 NURSE CONSOLES PER NEW DESIGN RULES.
2. SOME POES FOR GRAPHICAL ANNUNCIATORS MAY NOT BE REQUIRED IF LOCATED NEARBY.
3. SOME UPSs FOR GRAPHICAL ANNUNCIATORS MAY NOT BE REQUIRED IF LOCATED NEARBY.
4. SOME GBICs FOR GRAPHICAL ANNUNCIATORS MAY NOT BE REQUIRED IF LOCATED NEARBY.



FIRST FLOOR

System Type = NNC		Unit:	Spare Parts
	PNumber	QTY	Description
	P2505NNC1B00	2	AUDIO STATION BED CONNECTOR (ASBC)
	P2506NNC8A00-D	2	ICON BASED-LIGHT LED DOME LIGHT
	P2519NNC2A24	1	PDE SWITCH NNC 24-PORT UL60950
	P2520NNC1B01	2	SWITCH, BATH SWITCH, W/CANCEL, SUPERVISED
	P2520NNC1B02	2	SWITCH, BATH SWITCH, W/O CANCEL, SUPERVISED
	P2594NNC2C11	2	GRAPHICAL ROOM STATION (GRS) - PATIENT
	P2599NNC2D0	1	RCB2 ROOM CONTROL BOARD

System Type =	Unit:	First Floor
	PNumber	QTY Description
	P2500NNC1B00	2 STAFF CONSOLE, DESK MOUNT
	P2505NNC1B00	22 AUDIO STATION BED CONNECTOR (ASBC)
	P2506NNC2B00	4 SINGLE BULB DOME LIGHT, POLARIZ
	P2506NNC8A00-D	22 ICON BASED-LIGHT LED DOME LIGHT
	P2510-GDV	22 PILLOW SPEAKER FOR GOVERNMENT
	P2519NNC2A24	1 POE SWITCH NNC 24-PORT UL60950
	P2519NNCFA00	2 MULTI MODE GBIC FOR HILL-RDM POE
	P2520NNC1B01	26 SWITCH, BATH SWITCH, W/CANCEL, SUPERVISED
	P2520NNC1B02	24 SWITCH, BATH SWITCH, W/O CANCEL, SUPERVISED
	P2521B02	1 UPS,RACKMOUNTABLE, 2U - NON-SEISMIC
	P2594NNC1B01	2 STAFF STATION - STANDARD ROOM STATION W/O CODE
	P2594NNC2C11	22 GRAPHICAL RDM STATION (GRS) - PATIENT
	P2599NNC2D00	15 RCB2 ROOM CONTROL BOARD

27 52 23  
Nurse Call Shop Drawings

# Hill-Rom

Revision Date	Revised by	Comments
Revision History		

<u>Drawing Information</u>	
COMMUNITY LIVING CENTER FIRST FLOOR	
<u>Sheet</u> <u>Number</u>	<u>Total</u> <u>Sheets</u>
1	1
<u>Drawing</u> <u>Scale</u> SCALED TO FIT	

Project Information  
FIRST FLOOR  
RTELQ2855-02  
NNC LAYOUT

**PRELIMINARY  
DRAWING ONLY  
11/22/2017  
DO NOT USE FOR  
CONSTRUCTION**

DRAWN BY: RJL  
CHECKED BY:

Customer Information

6296906

VA COMMUNITY LIVING CENTER - ERIE

135 E 38TH ST

ERIE PA 16504