
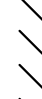
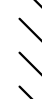


| PLUMBING FIELD STUDY KEY SYMBOLS | |
|---|---|
| <p>TYPE A – PIPE LENGTH GREATER THAN TWICE THE DIAMETER OF THE PIPE SIZE TERMINATING AT CAP, VALVE, OR FITTING.</p> <p>TYPE B – PIPE LENGTH GREATER THAN TWICE THE DIAMETER OF THE PIPES TERMINATING AT AN INFREQUENTLY USED PLUMBING FITTURE.</p> <p>TYPE C – PIPE LENGTH GREATER THAN 25 FEET TERMINATING AT A FREQUENTLY USED PLUMBING FITTURE</p> | <p>DEAD LEG TAG</p> |
|  | <p>MAKING VALVE TAG</p> |
|  | <p>NON-INSULATED PIPE REFER TO SCHEDULE</p> |

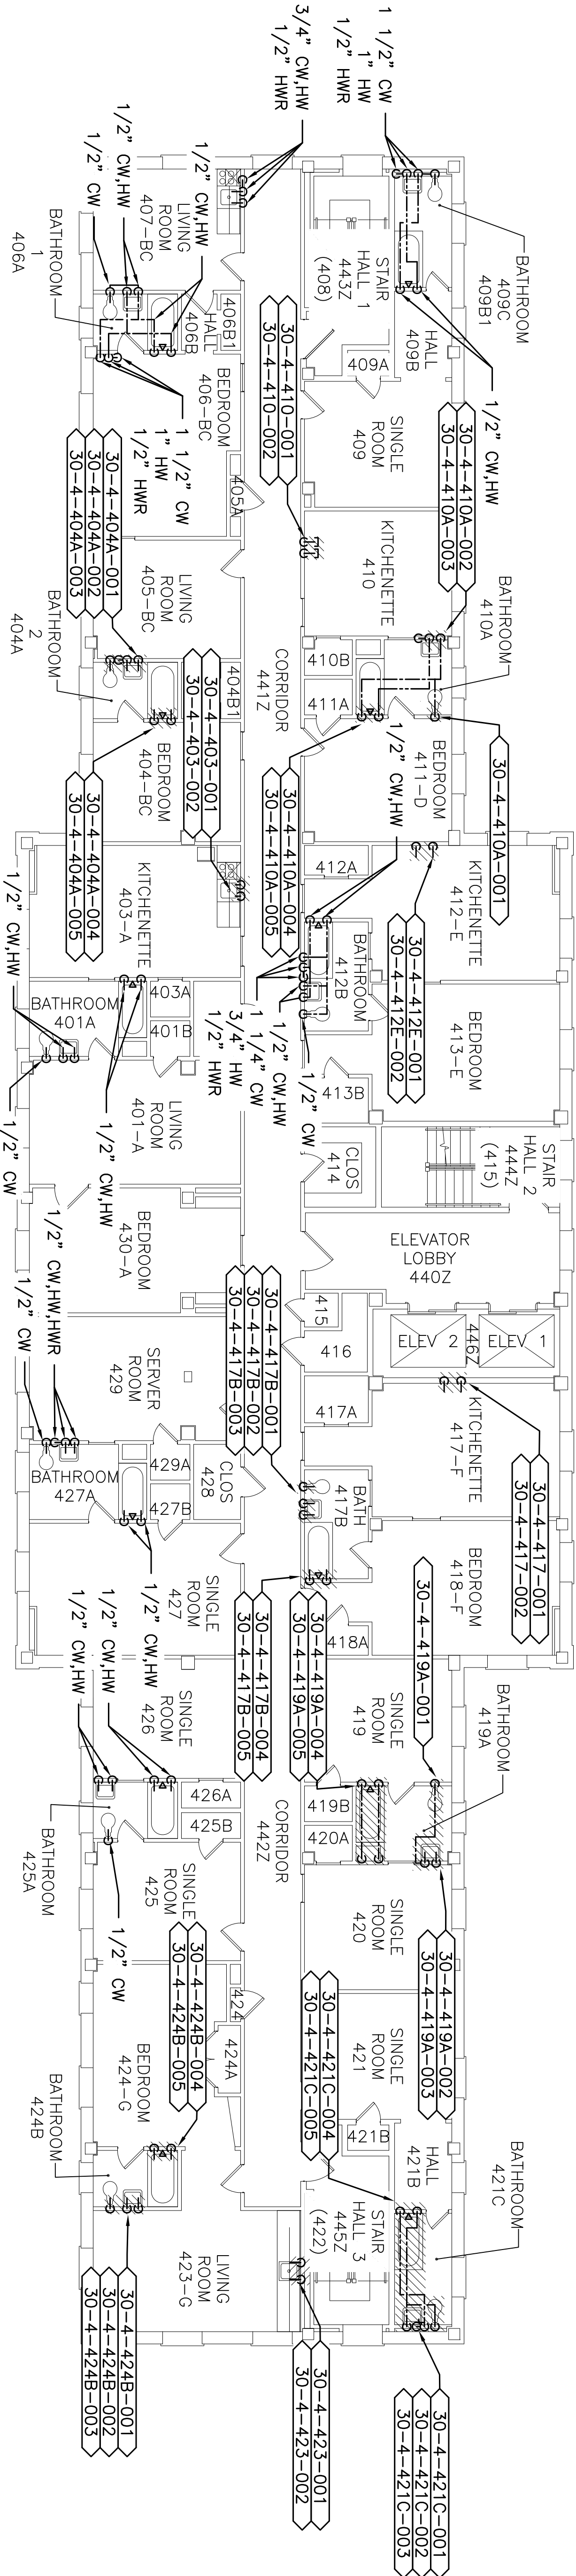

1
PL-152

BUILDING 30 FOURTH FLOOR
PLUMBING AS BUILT/DEAD LEG PLAN
SCALE: 1/8" = 1'-0"

| | |
|----------------------------------|------------|
| | |
| | |
| 100% Working Drawings Submission | 03-09-2018 |
| Revisions: | Date: |

| | |
|--------------|--|
| CONSULTANTS: | |
| | |

| | |
|----------------------|--|
| ARCHITECT/ENGINEERS: | |
| | |

| | |
|--|--------|
| | NORTH: |
| | |

[illegible]

| | | | | | |
|--|--|--|--|--|--|
| | | | | | |
|--|--|--|--|--|--|

| | |
|--|---|
| Drawing Title | Building 30 Fourth Floor Plumbing As-Built / Dead-Leg Plan |
| Approved: Facility Director - VAHVACS: | |
| Approved: John Cliffe, Facility Chief of Engineering | |

| | | | |
|--|---------|-------|--|
| Project Title | | | |
| Remove Domestic Dead-Legs at the Montrose Campus | | | |
| Location | | | |
| Montrose, New York | | | |
| Date | Checked | Drawn | |
| 03-08-2018 | MR | MF | |

| | |
|--------------------|------------|
| Project Number | 620-18-119 |
| Building(s) Number | 30 |
| Drawing Number | PL 152 |
| Sheet 74 of 77 | |

**Engineering
Service**

 Department of
Veterans Affairs

100% WORKING DRAWINGS SUBMISSION