


PLUMBING FIELD STUDY KEY SYMBOLS	
TYPE A – PIPE LENGTH GREATER THAN TWICE THE DIAMETER OF THE PIPE SIZE TERMINATING AT CAP, VALVE, OR FITTING.	
TYPE B – PIPE LENGTH GREATER THAN TWICE THE DIAMETER OF THE PIPES TERMINATING AT AN INFREQUENTLY USED PLUMBING FIXTURE.	
TYPE C – PIPE LENGTH GREATER THAN 25 FEET TERMINATING AT A FREQUENTLY USED PLUMBING FIXTURE	
XXXX-XX-XXX-XXXX	DEAD LEG TAG
XXX-XX-XXX-XXX	MIXING VALVE TAG
//////	REMEDIAE DEAD LEG
NI-0	NON-INSULATED PIPE REFER TO SCHEDULE

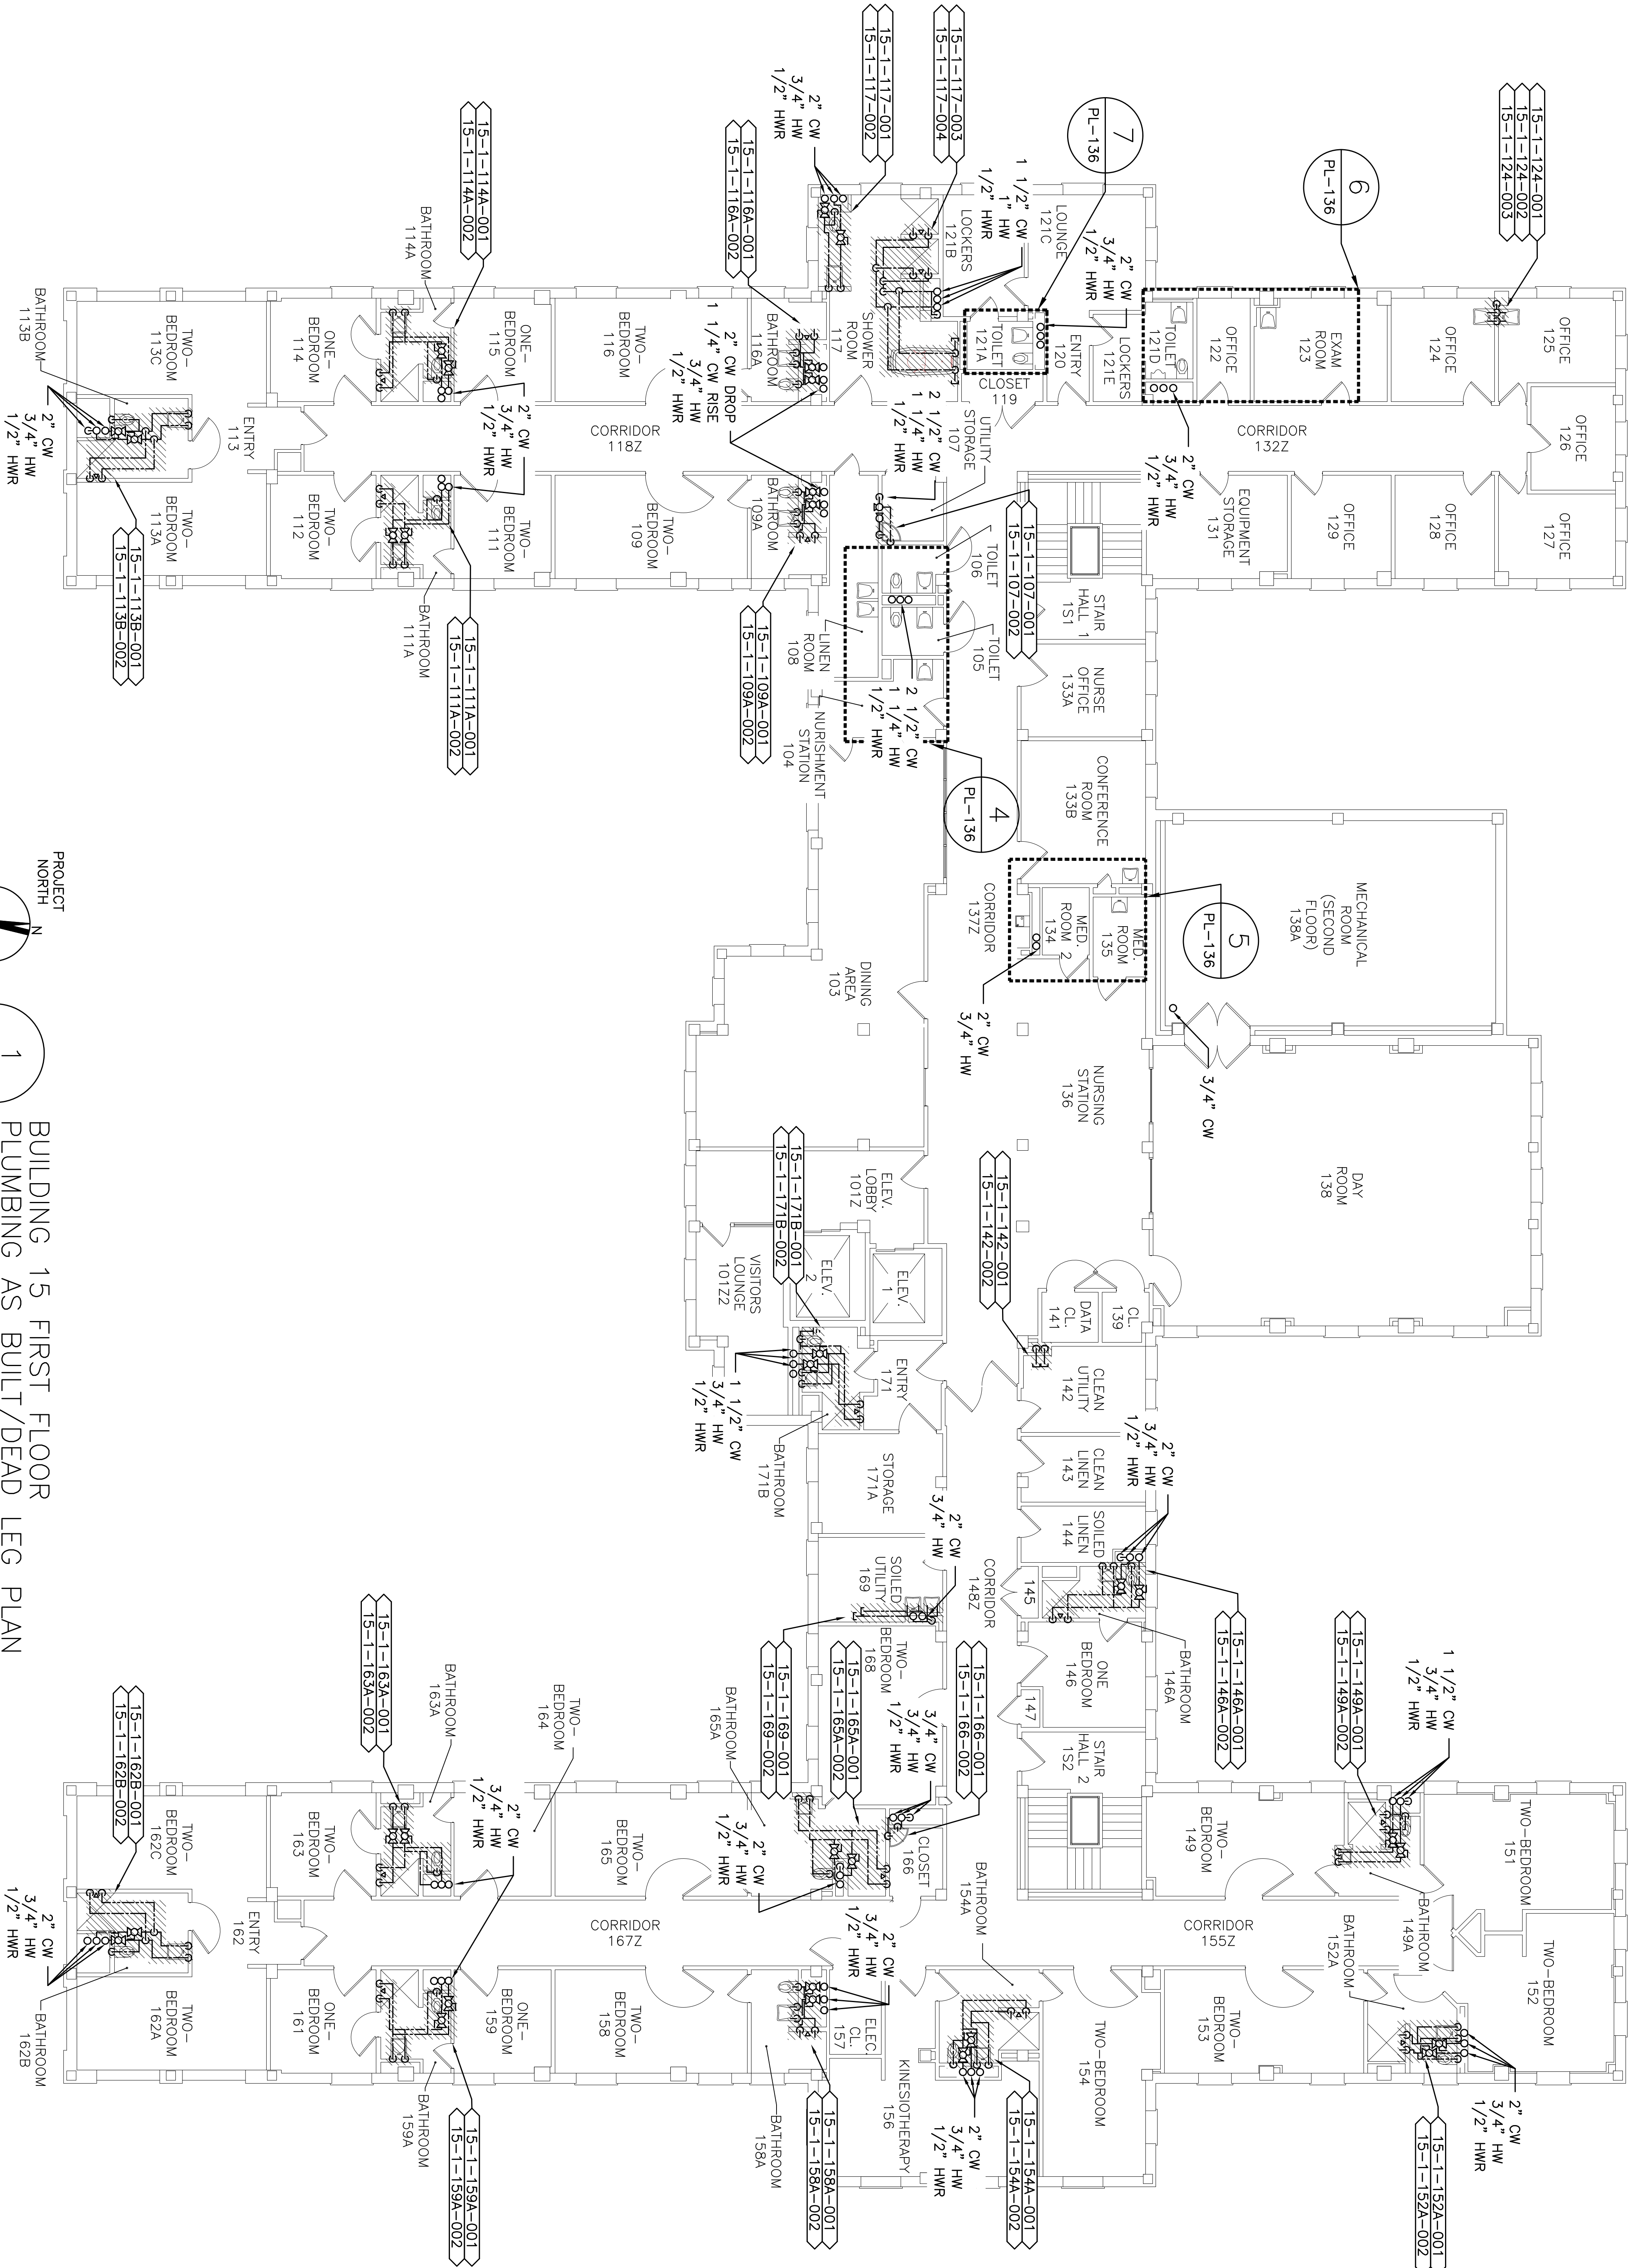

PROJECT NORTH

1

SCALE: 1/8"=1'-0"

BUILDING 15 FIRST FLOOR
PLUMBING AS BUILT/DEAD LEG PLAN

CONSULTANTS:		ARCHITECT/ENGINEERS:		NORTH:				Drawing Title		Project Title		Project Number		Engineering Service	
								Building 15 First Floor Plumbing As-Built / Dead-Leg Plan		Remove Domestic Dead-Legs at the Montrose Campus		620-18-119		Engineering Service	
								Approved: Facility Director , VA/HVGS:		Location		Montrose, New York		Buildings Number 15	
								Approved: John Cliffe, Facility Chief of Engineering		Date		Checked		Drawing Number	
										03-08-2018		MR		PL 134	
												Sheet 56 of 77			
100% Working Drawings Submission															
Revisions:															
Date:															
03-09-2018															

