

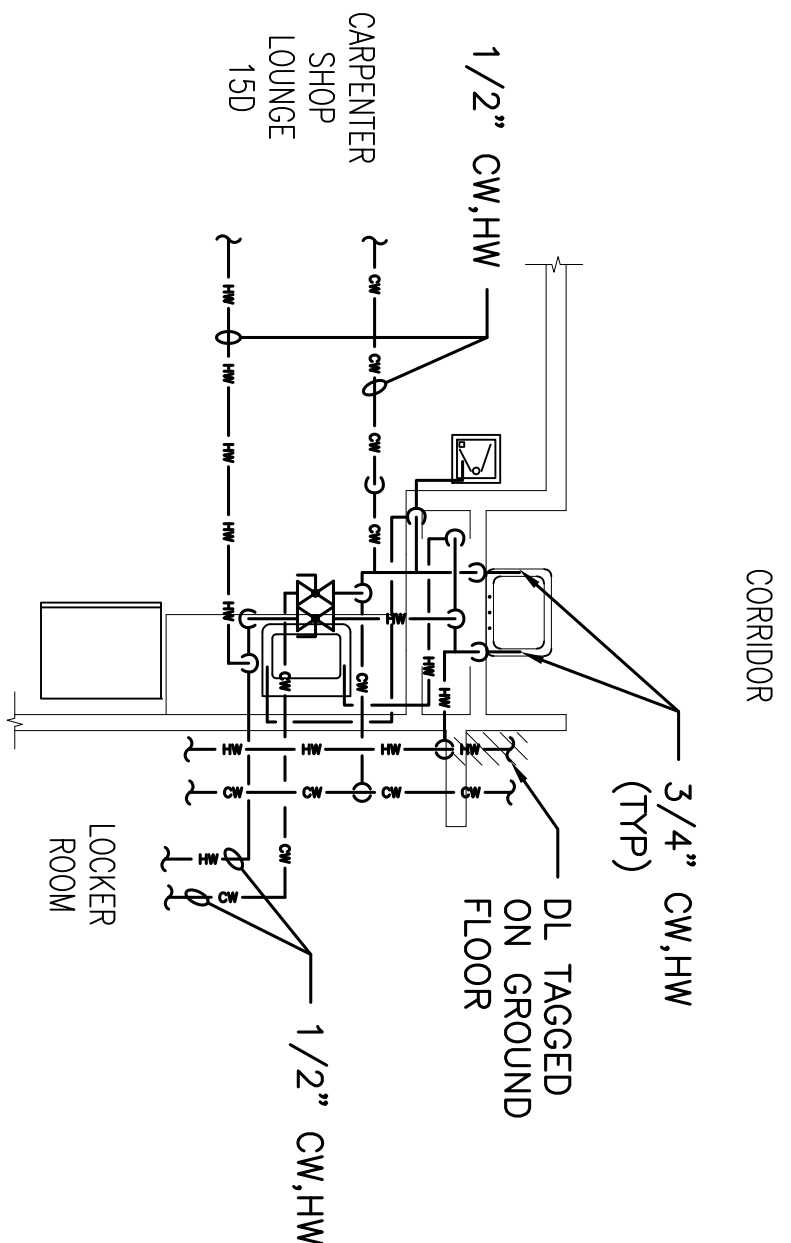



PLUMBING FIELD STUDY KEY SYMBOLS	
TYPE A – PIPE LENGTH GREATER THAN TWICE THE DIAMETER OF THE PIPE SIZE TERMINATING AT CAP, VALVE, OR FITTING.	
TYPE B – PIPE LENGTH GREATER THAN TWICE THE DIAMETER OF THE PIPES TERMINATING AT AN INFREQUENTLY USED PLUMBING FIXTURE.	
TYPE C – PIPE LENGTH GREATER THAN 25 FEET TERMINATING AT A FREQUENTLY USED PLUMBING FIXTURE	
<XXX-XX-XXX-XXX>	DEAD LEG TAG
XXX-XX-XXX-XXX	MIXING VALVE TAG
////	REMEDiate DEAD LEG
NI-0	NON-INSULATED PIPE REFER TO SCHEDULE

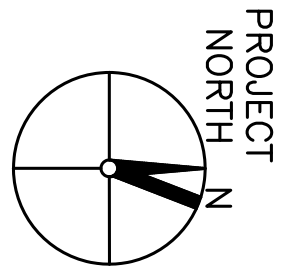

2  
BUILDING 16 GROUND FLOOR  
PIPE CHASE ENLARGED PLAN  
PL-138  
SCALE: 1/4"=1'-0"

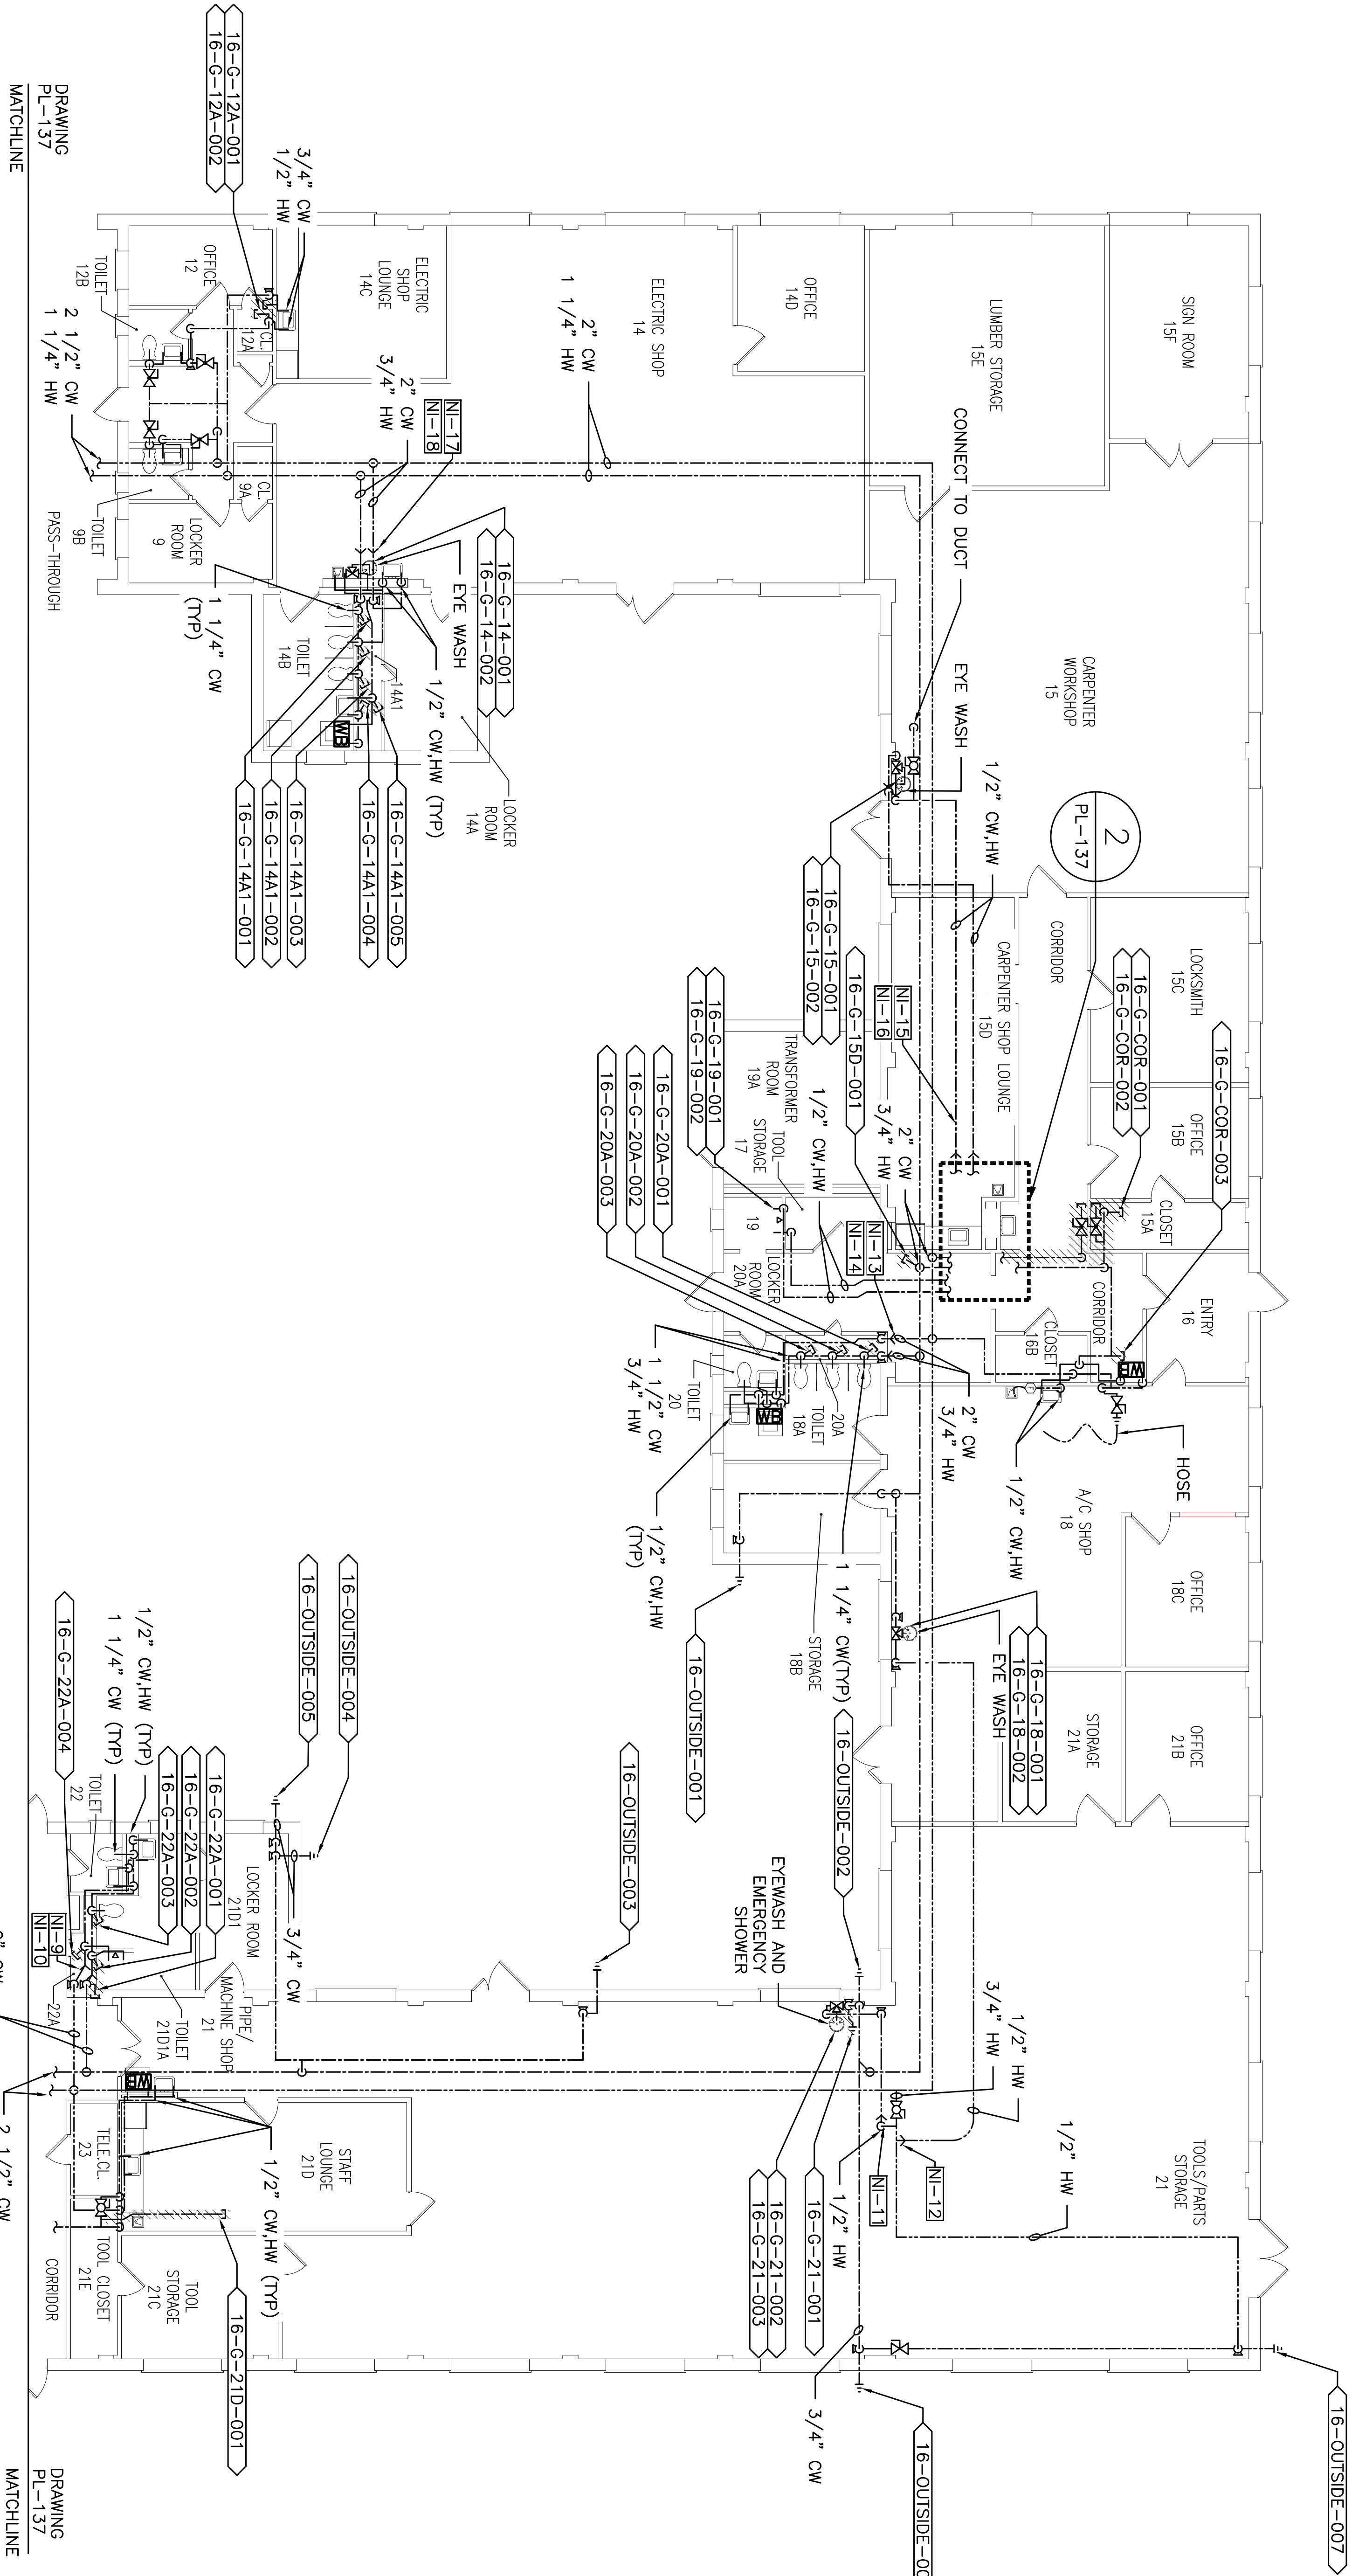

1  
BUILDING 16 GROUND FLOOR  
PLUMBING AS BUILT/DEAD LEG PLAN B  
PL-138  
SCALE: 1/8"=1'-0"

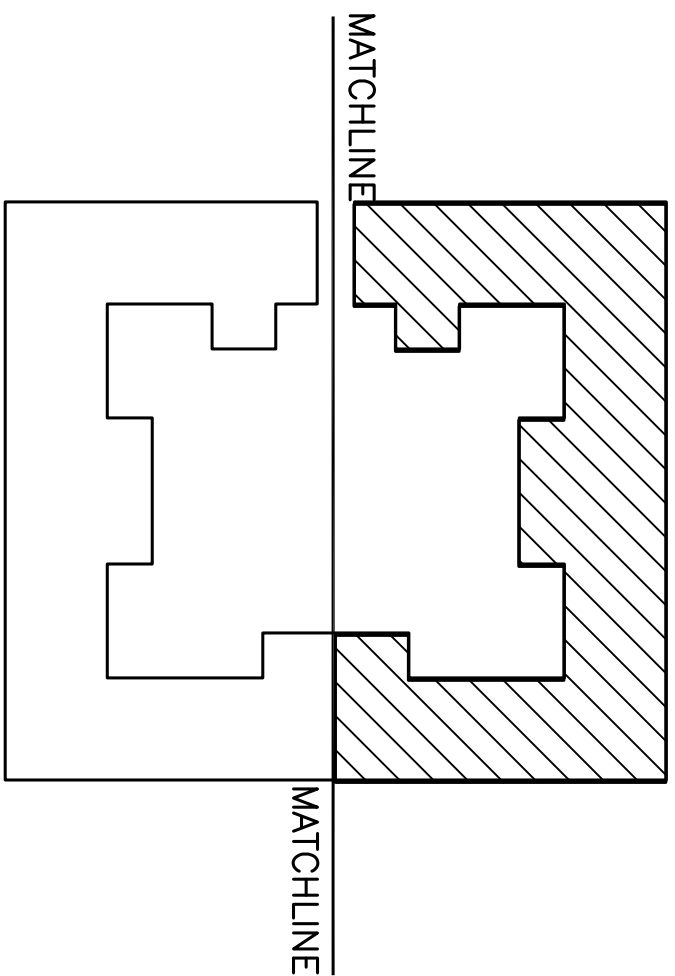

KEY PLAN

CONSULTANTS:		ARCHITECT/ENGINEERS:		NORTH:		Drawing Title		Project Title		Project Number		Engineering Service	
						Building 16 Ground Floor Plumbing As-Built / Dead-Leg Plan / Enlarged Plan		Remove Domestic Dead-Legs at the Montrose Campus		620-18-119		Engineering Service	
						Approved: Facility Director, VA/HVACS:		Location		Buildings(s) Number		Drawing Number	
						Approved: John Cliffe, Facility Chief of Engineering		Montrose, New York		16		PL 138	
						Date		03-08-2018		Checked		MR	
						Date		03-09-2018		Drawn		MF	
						100% Working Drawings Submission		Revisions:		Sheet 60 of 77			

