


PLUMBING FIELD STUDY KEY SYMBOLS	
TYPE A – PIPE LENGTH GREATER THAN TWICE THE DIAMETER OF THE PIPE SIZE TERMINATING AT CAP, VALVE, OR FITTING.	
TYPE B – PIPE LENGTH GREATER THAN TWICE THE DIAMETER OF THE PIPES TERMINATING AT AN INFREQUENTLY USED PLUMBING FIXTURE.	
TYPE C – PIPE LENGTH GREATER THAN 25 FEET TERMINATING AT A FREQUENTLY USED PLUMBING FIXTURE	
<XXX-XX-XXX-XXX>	DEAD LEG TAG
XXX-XX-XXX-XXX	MIXING VALVE TAG
//////	REMEDIATE DEAD LEG
NI-0	NON-INSULATED PIPE REFER TO SCHEDULE

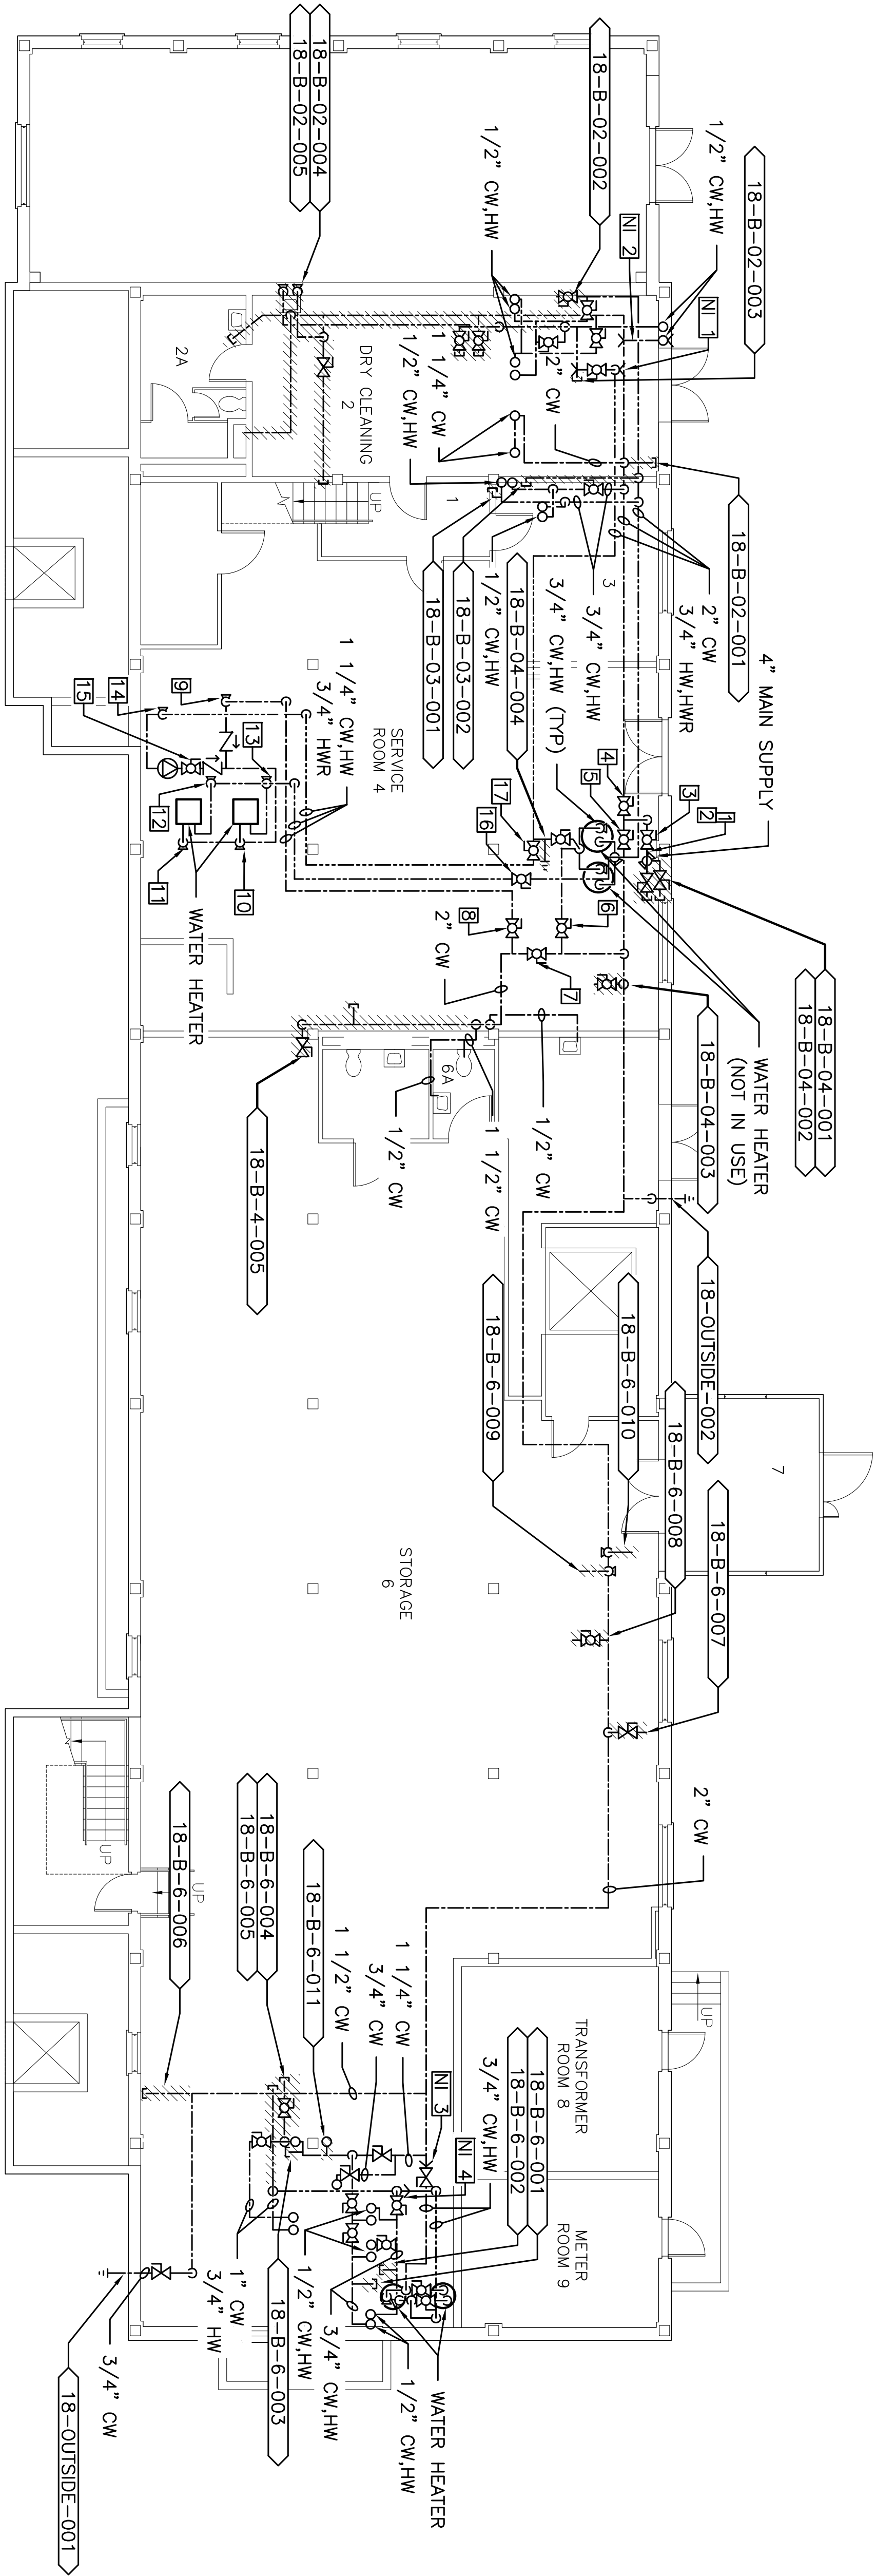


PROJECT NORTH N

1

BUILDING 18 BASEMENT FLOOR
PLUMBING AS BUILT/DEAD LEG PLAN

SCALE: 1/8"=1'-0"

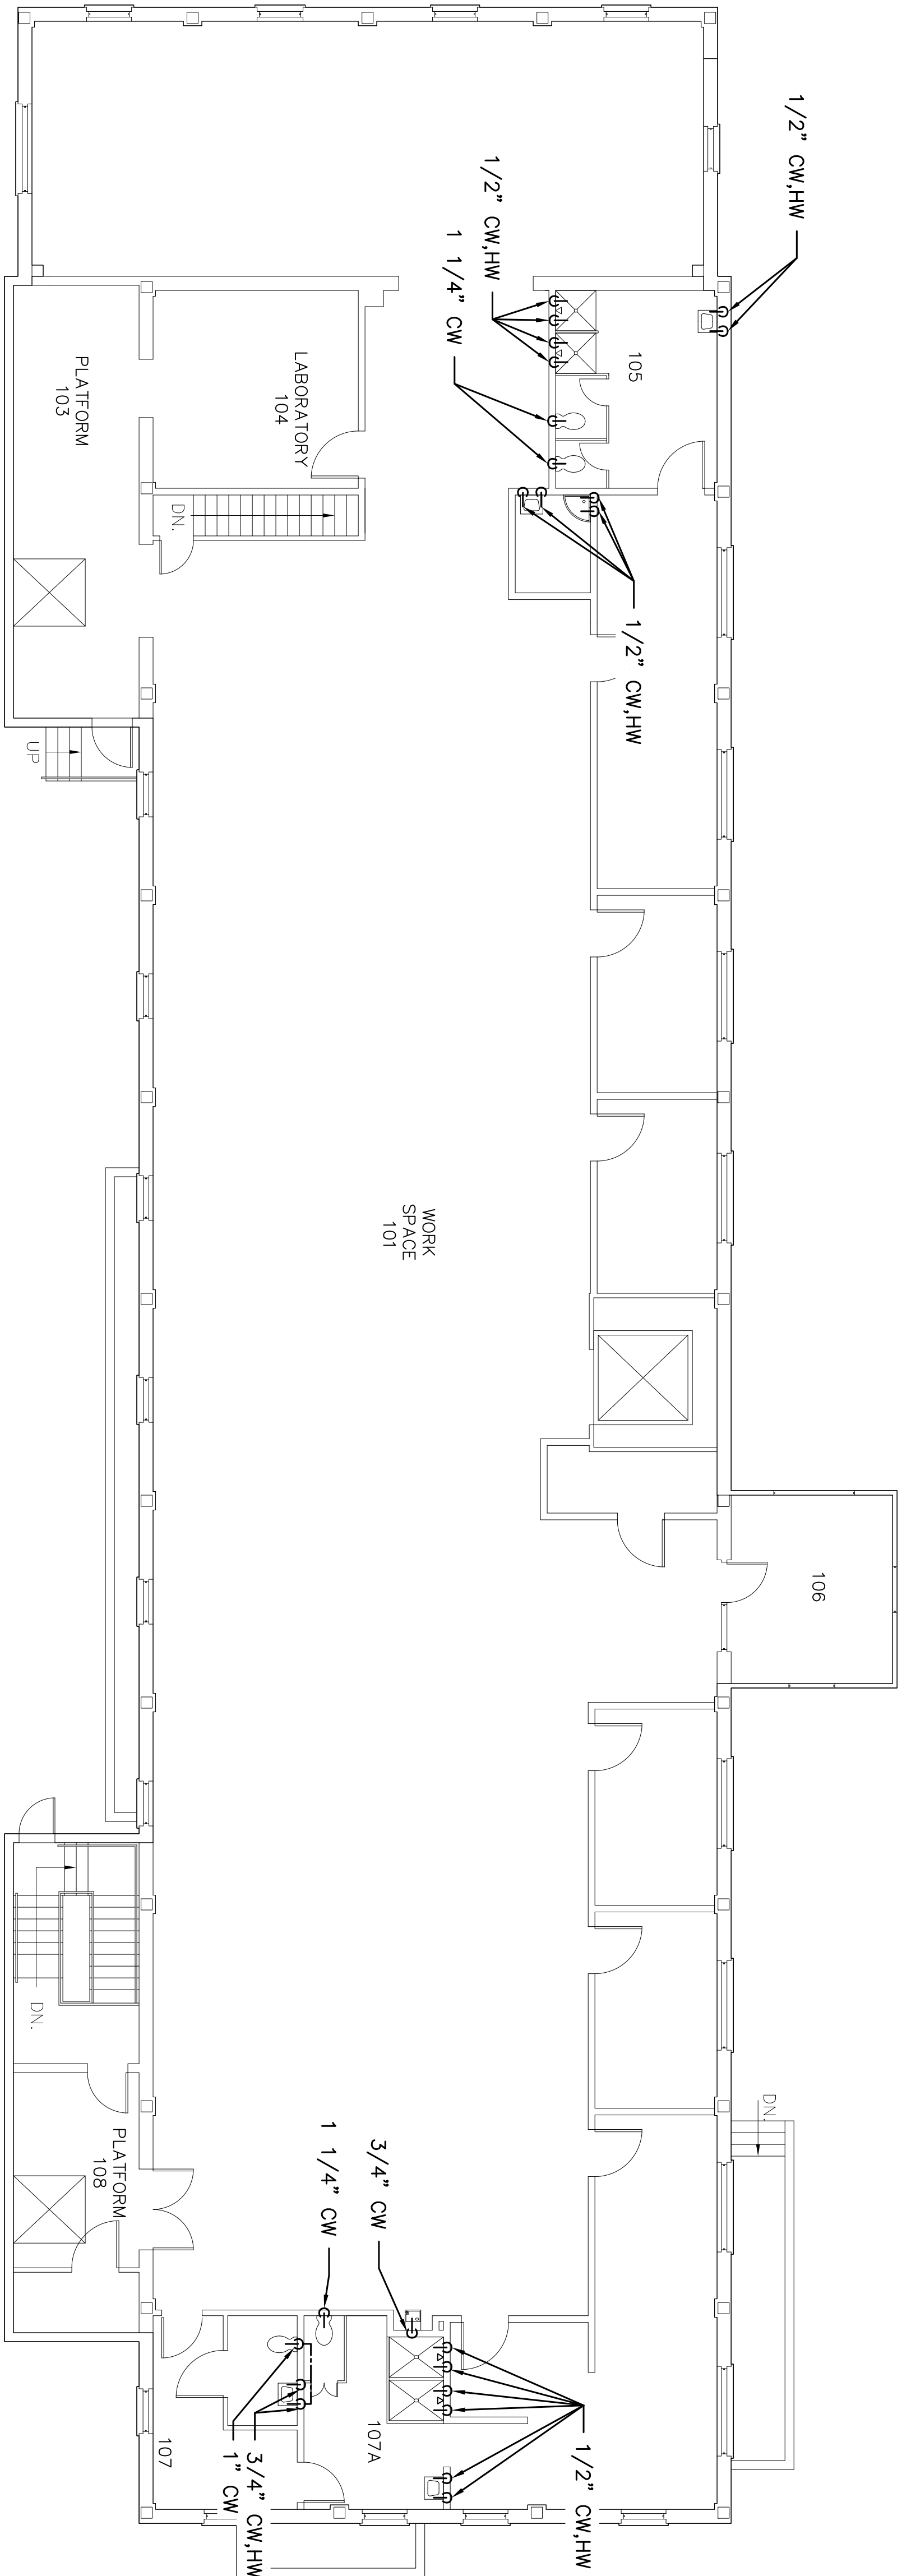

PROJECT NORTH N

2

BUILDING 18 FIRST FLOOR
PLUMBING AS BUILT/DEAD LEG PLAN

SCALE: 1/8"=1'-0"

--	--	