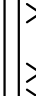
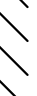

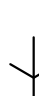
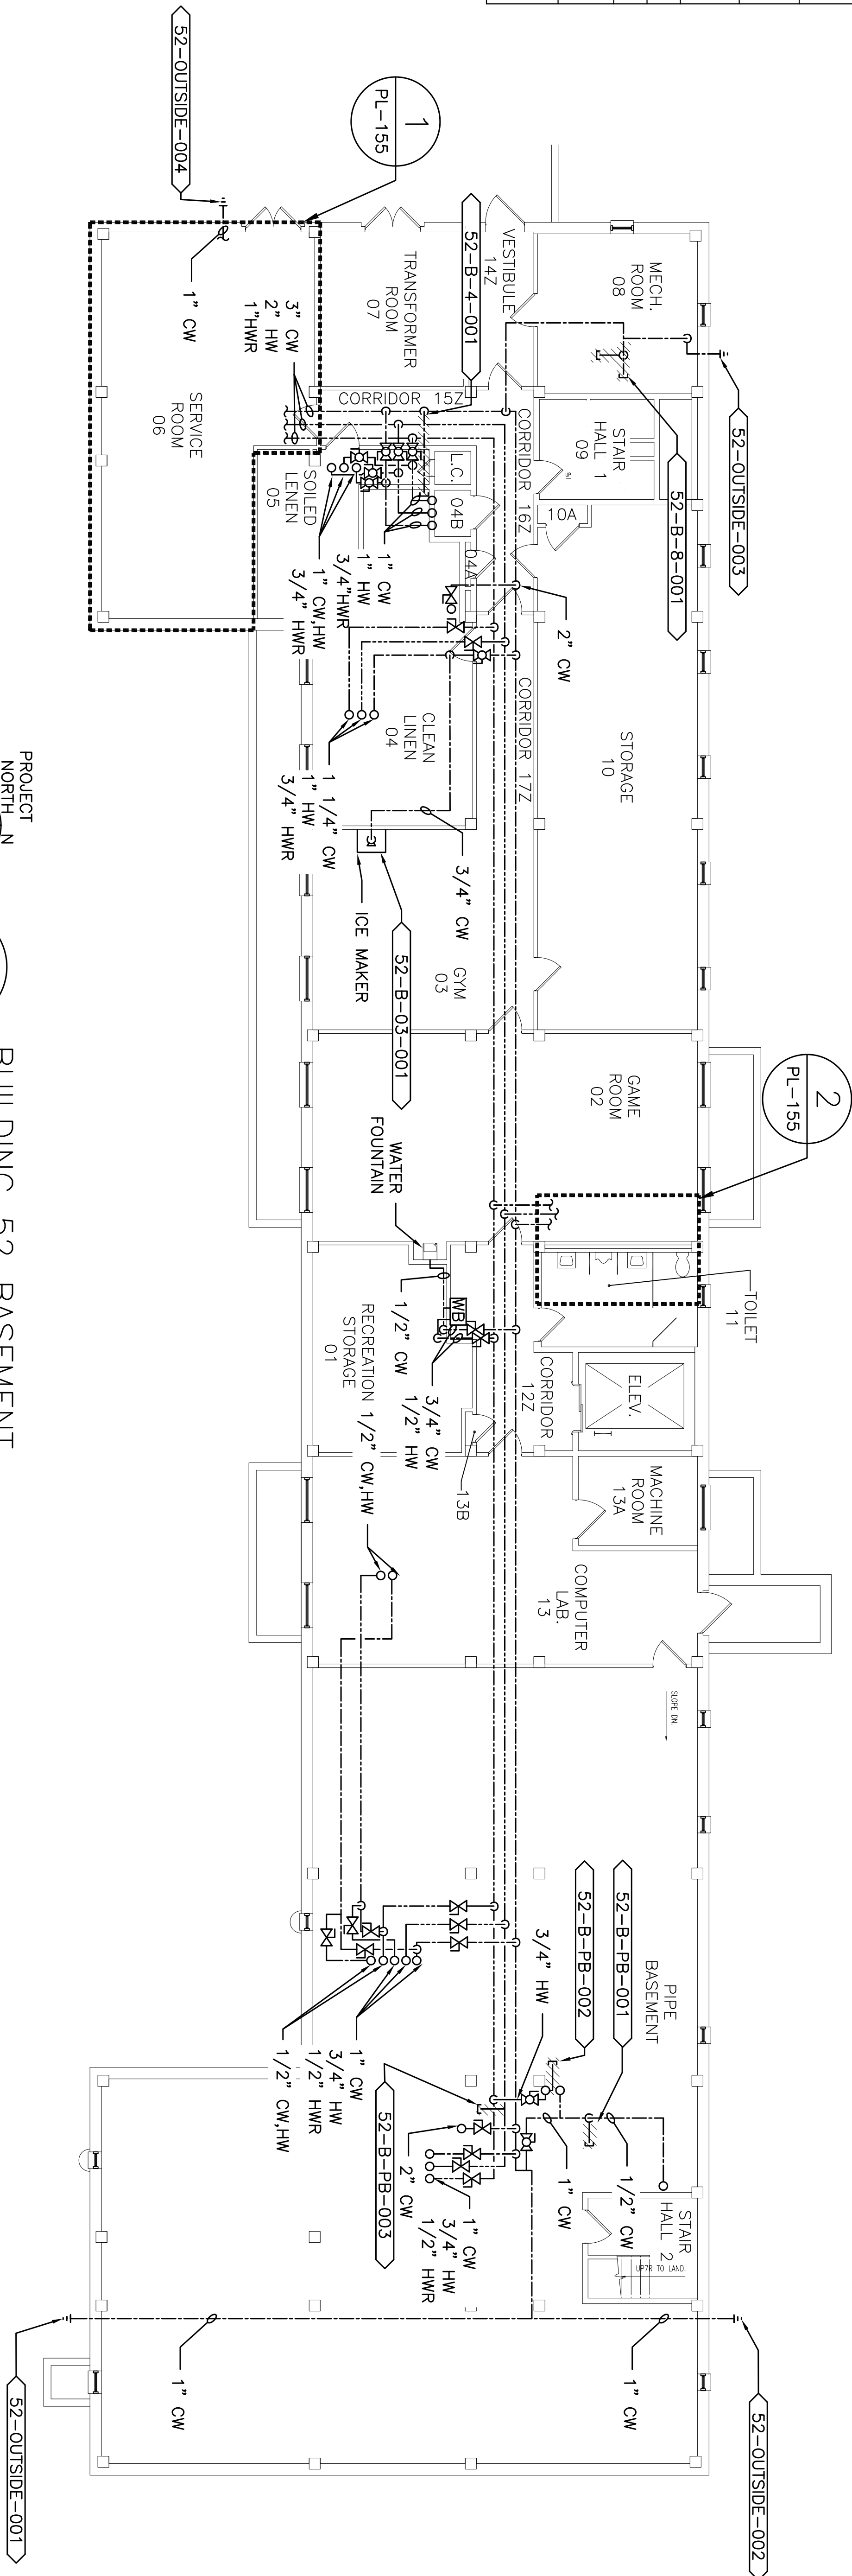


PLUMBING FIELD STUDY KEY SYMBOLS	
TYPE A – PIPE LENGTH GREATER THAN TWICE THE DIAMETER OF THE PIPE SIZE TERMINATING AT CAP, VALVE, OR FITTING.	
TYPE B – PIPE LENGTH GREATER THAN TWICE THE DIAMETER OF THE PIPES TERMINATING AT AN INFREQUENTLY USED PLUMBING FITTURE.	
TYPE C – PIPE LENGTH GREATER THAN 25 FEET TERMINATING AT A FREQUENTLY USED PLUMBING FITTURE	
	DEAD LEG TAG
	MIXING VALVE TAG
	REMEDiate DEAD LEG
	NON-INSULATED PIPE REFER TO SCHEDULE

KEYED NOTE:

① ROUTING CANNOT BE CONFIRMED
WITHOUT DEMOLITION WATER
FOUNTAIN/WATER COOLERS ARE ACTIVE

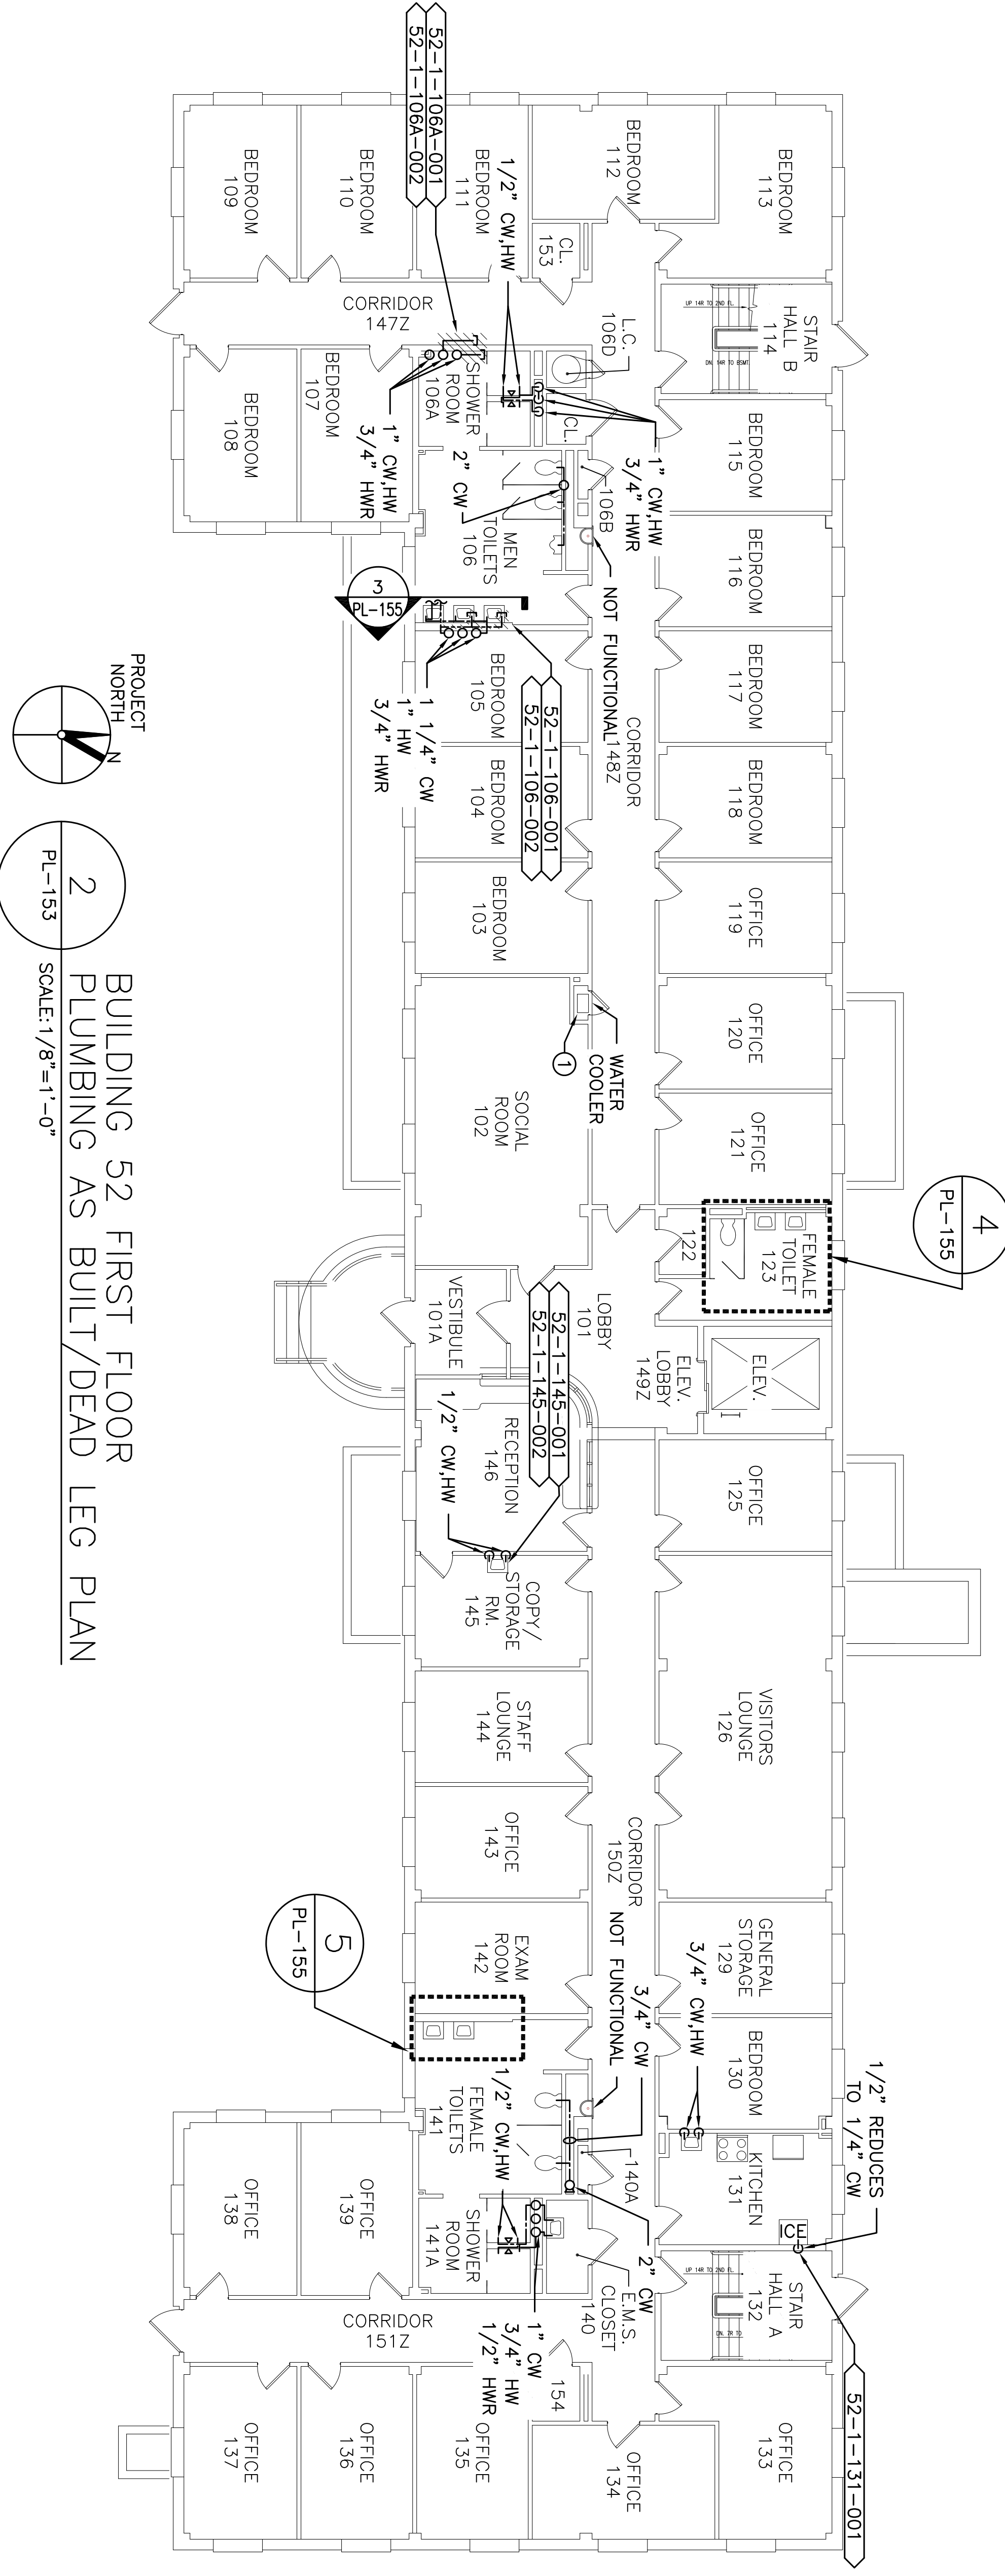


BUILDING 52 BASEMENT
PLUMBING AS BUILT/DEAD LEG PLAN



1
PL-153

SCALE: 1/8" = 1'-0"



PROJECT: NORTH
BUILDING 52 FIRST FLOOR
PLUMBING AS BUILT/DEAD LEG PLAN
SCALE: 1/8" = 1'-0"
PL-153

[illegible]