



PLUMBING FIELD STUDY KEY SYMBOLS	
TYPE A – PIPE LENGTH GREATER THAN TWICE THE DIAMETER OF THE PIPE SIZE TERMINATING AT CAP, VALVE, OR FITTING.	
TYPE B – PIPE LENGTH GREATER THAN TWICE THE DIAMETER OF THE PIPES TERMINATING AT AN INFREQUENTLY USED PLUMBING FIXTURE.	
TYPE C – PIPE LENGTH GREATER THAN 25 FEET TERMINATING AT A FREQUENTLY USED PLUMBING FIXTURE	
<XXX-XX-XXX-XXX>	DEAD LEG TAG
XXX-XX-XXX-XXX	MIXING VALVE TAG
////	REMEDiate DEAD LEG
NI-0	NON-INSULATED PIPE REFER TO SCHEDULE

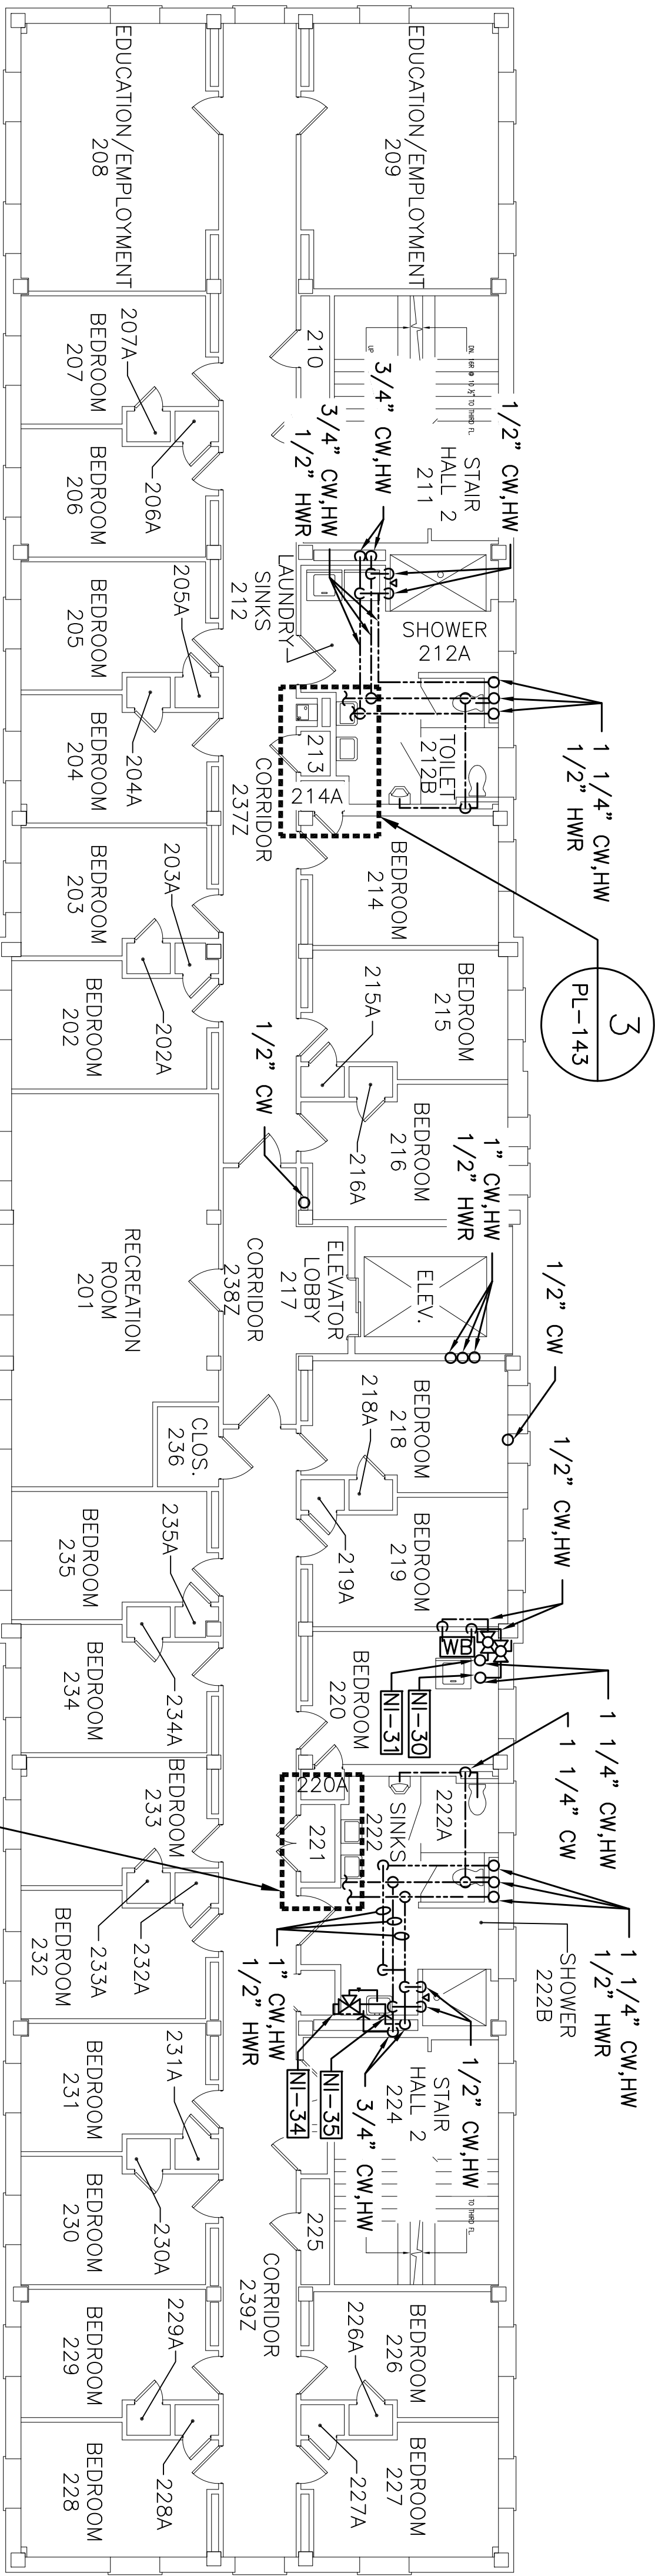

PROJECT NORTH

1 PLUMBING AS BUILT/DEAD LEG PLAN

PL-142 SCALE: 1/8"=1'-0"

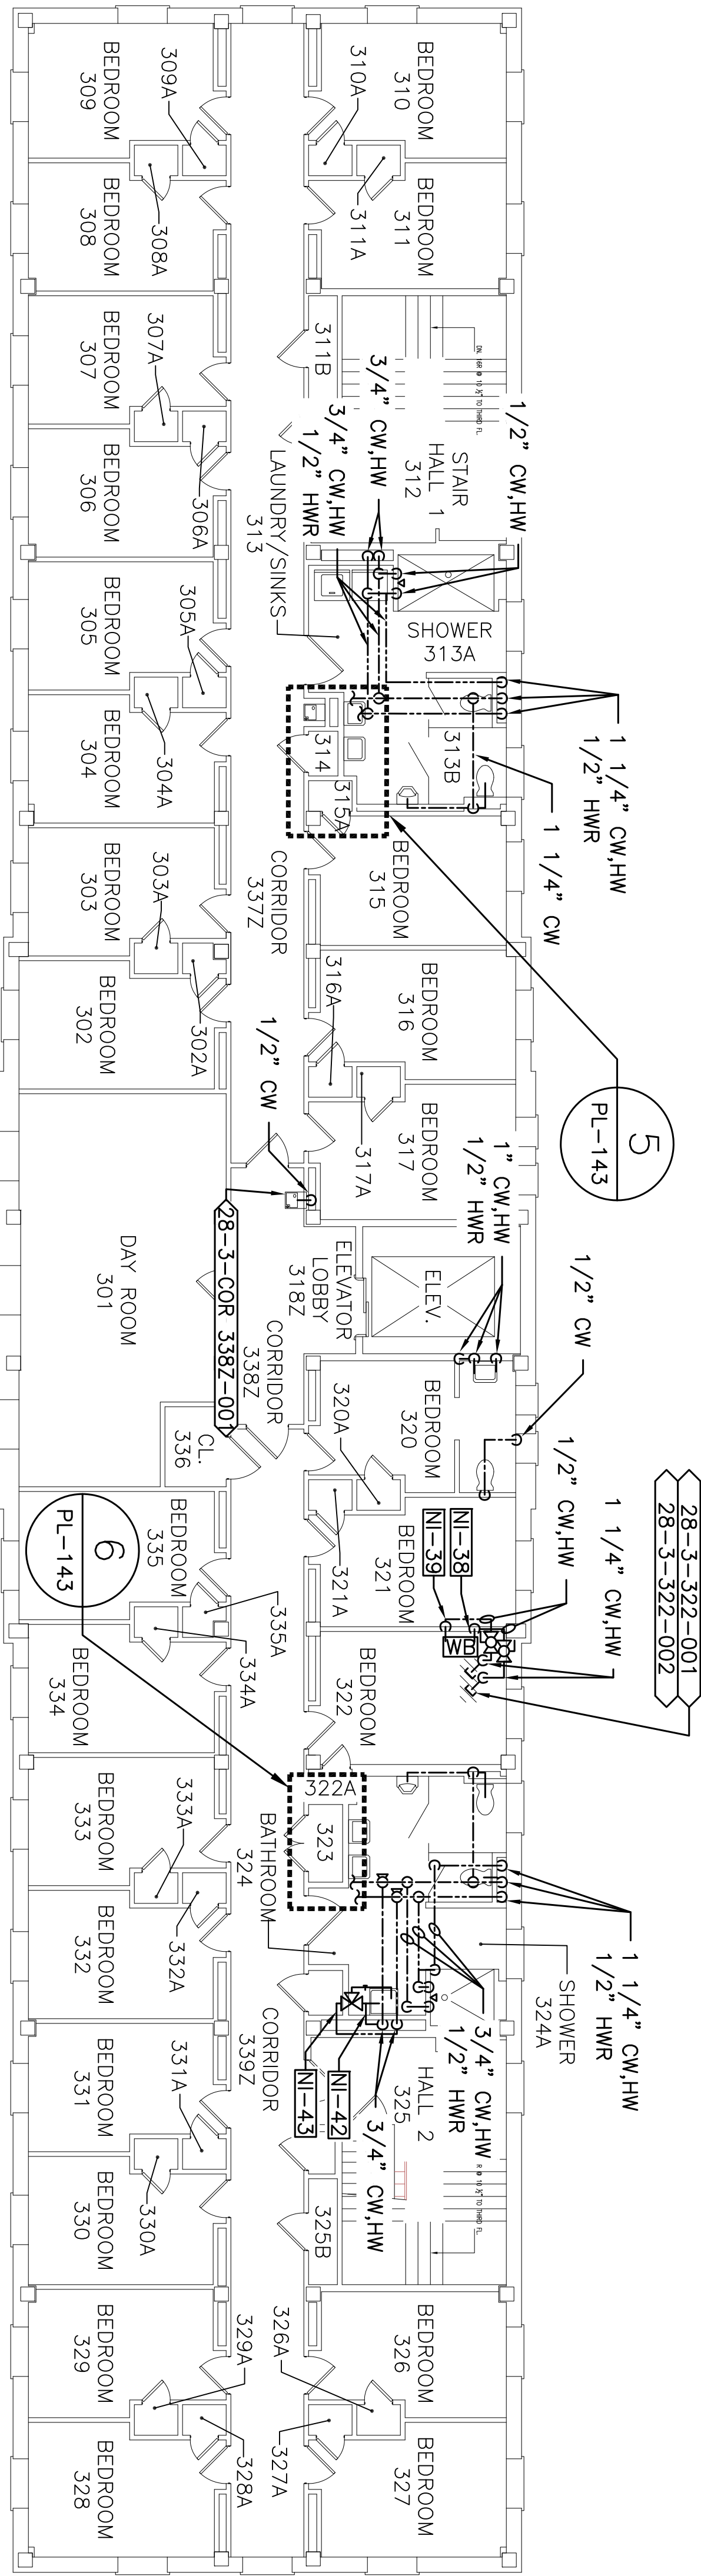

PROJECT NORTH

2 PLUMBING AS BUILT/DEAD LEG PLAN

PL-142 SCALE: 1/8"=1'-0"

CONSULTANTS:		ARCHITECT/ENGINEERS:		NORTH:		Drawing Title		Project Title		Project Number		Engineering Service	
						Building 28 Second & Third Floor Plumbing As-Built / Dead-Leg Plan		Remove Domestic Dead-Legs at the Montrose Campus		620-18-119		Engineering Service	
						Approved: Facility Director , VAH/HCS:		Location		Buildings(s) Number		Department of Veterans Affairs	
						Approved: John Cliffe, Facility Chief of Engineering		Montrose, New York		28			
						Date		Checked		Drawing Number			
						03-08-2018		MR		PL 142			
								Drawn		Sheet 64 of 77			
100% Working Drawings Submission		Revisions:		Date:									
03-09-2018													