


PLUMBING FIELD STUDY KEY SYMBOLS	
TYPE A – PIPE LENGTH GREATER THAN TWICE THE DIAMETER OF THE PIPE SIZE TERMINATING AT CAP, VALVE, OR FITTING.	
TYPE B – PIPE LENGTH GREATER THAN TWICE THE DIAMETER OF THE PIPES TERMINATING AT AN INFREQUENTLY USED PLUMBING FIXTURE.	
TYPE C – PIPE LENGTH GREATER THAN 25 FEET TERMINATING AT A FREQUENTLY USED PLUMBING FIXTURE	
<XXX-XX-XXX-XXX>	DEAD LEG TAG
XXX-XX-XXX-XXX	MIXING VALVE TAG
////	REMEDiate DEAD LEG
NI-0	NON-INSULATED PIPE REFER TO SCHEDULE

PROJECT NORTH

2 PL-135

BUILDING 15 ATTIC PLUMBING AS BUILT/DEAD LEG PLAN

SCALE:1/8"=1'-0"

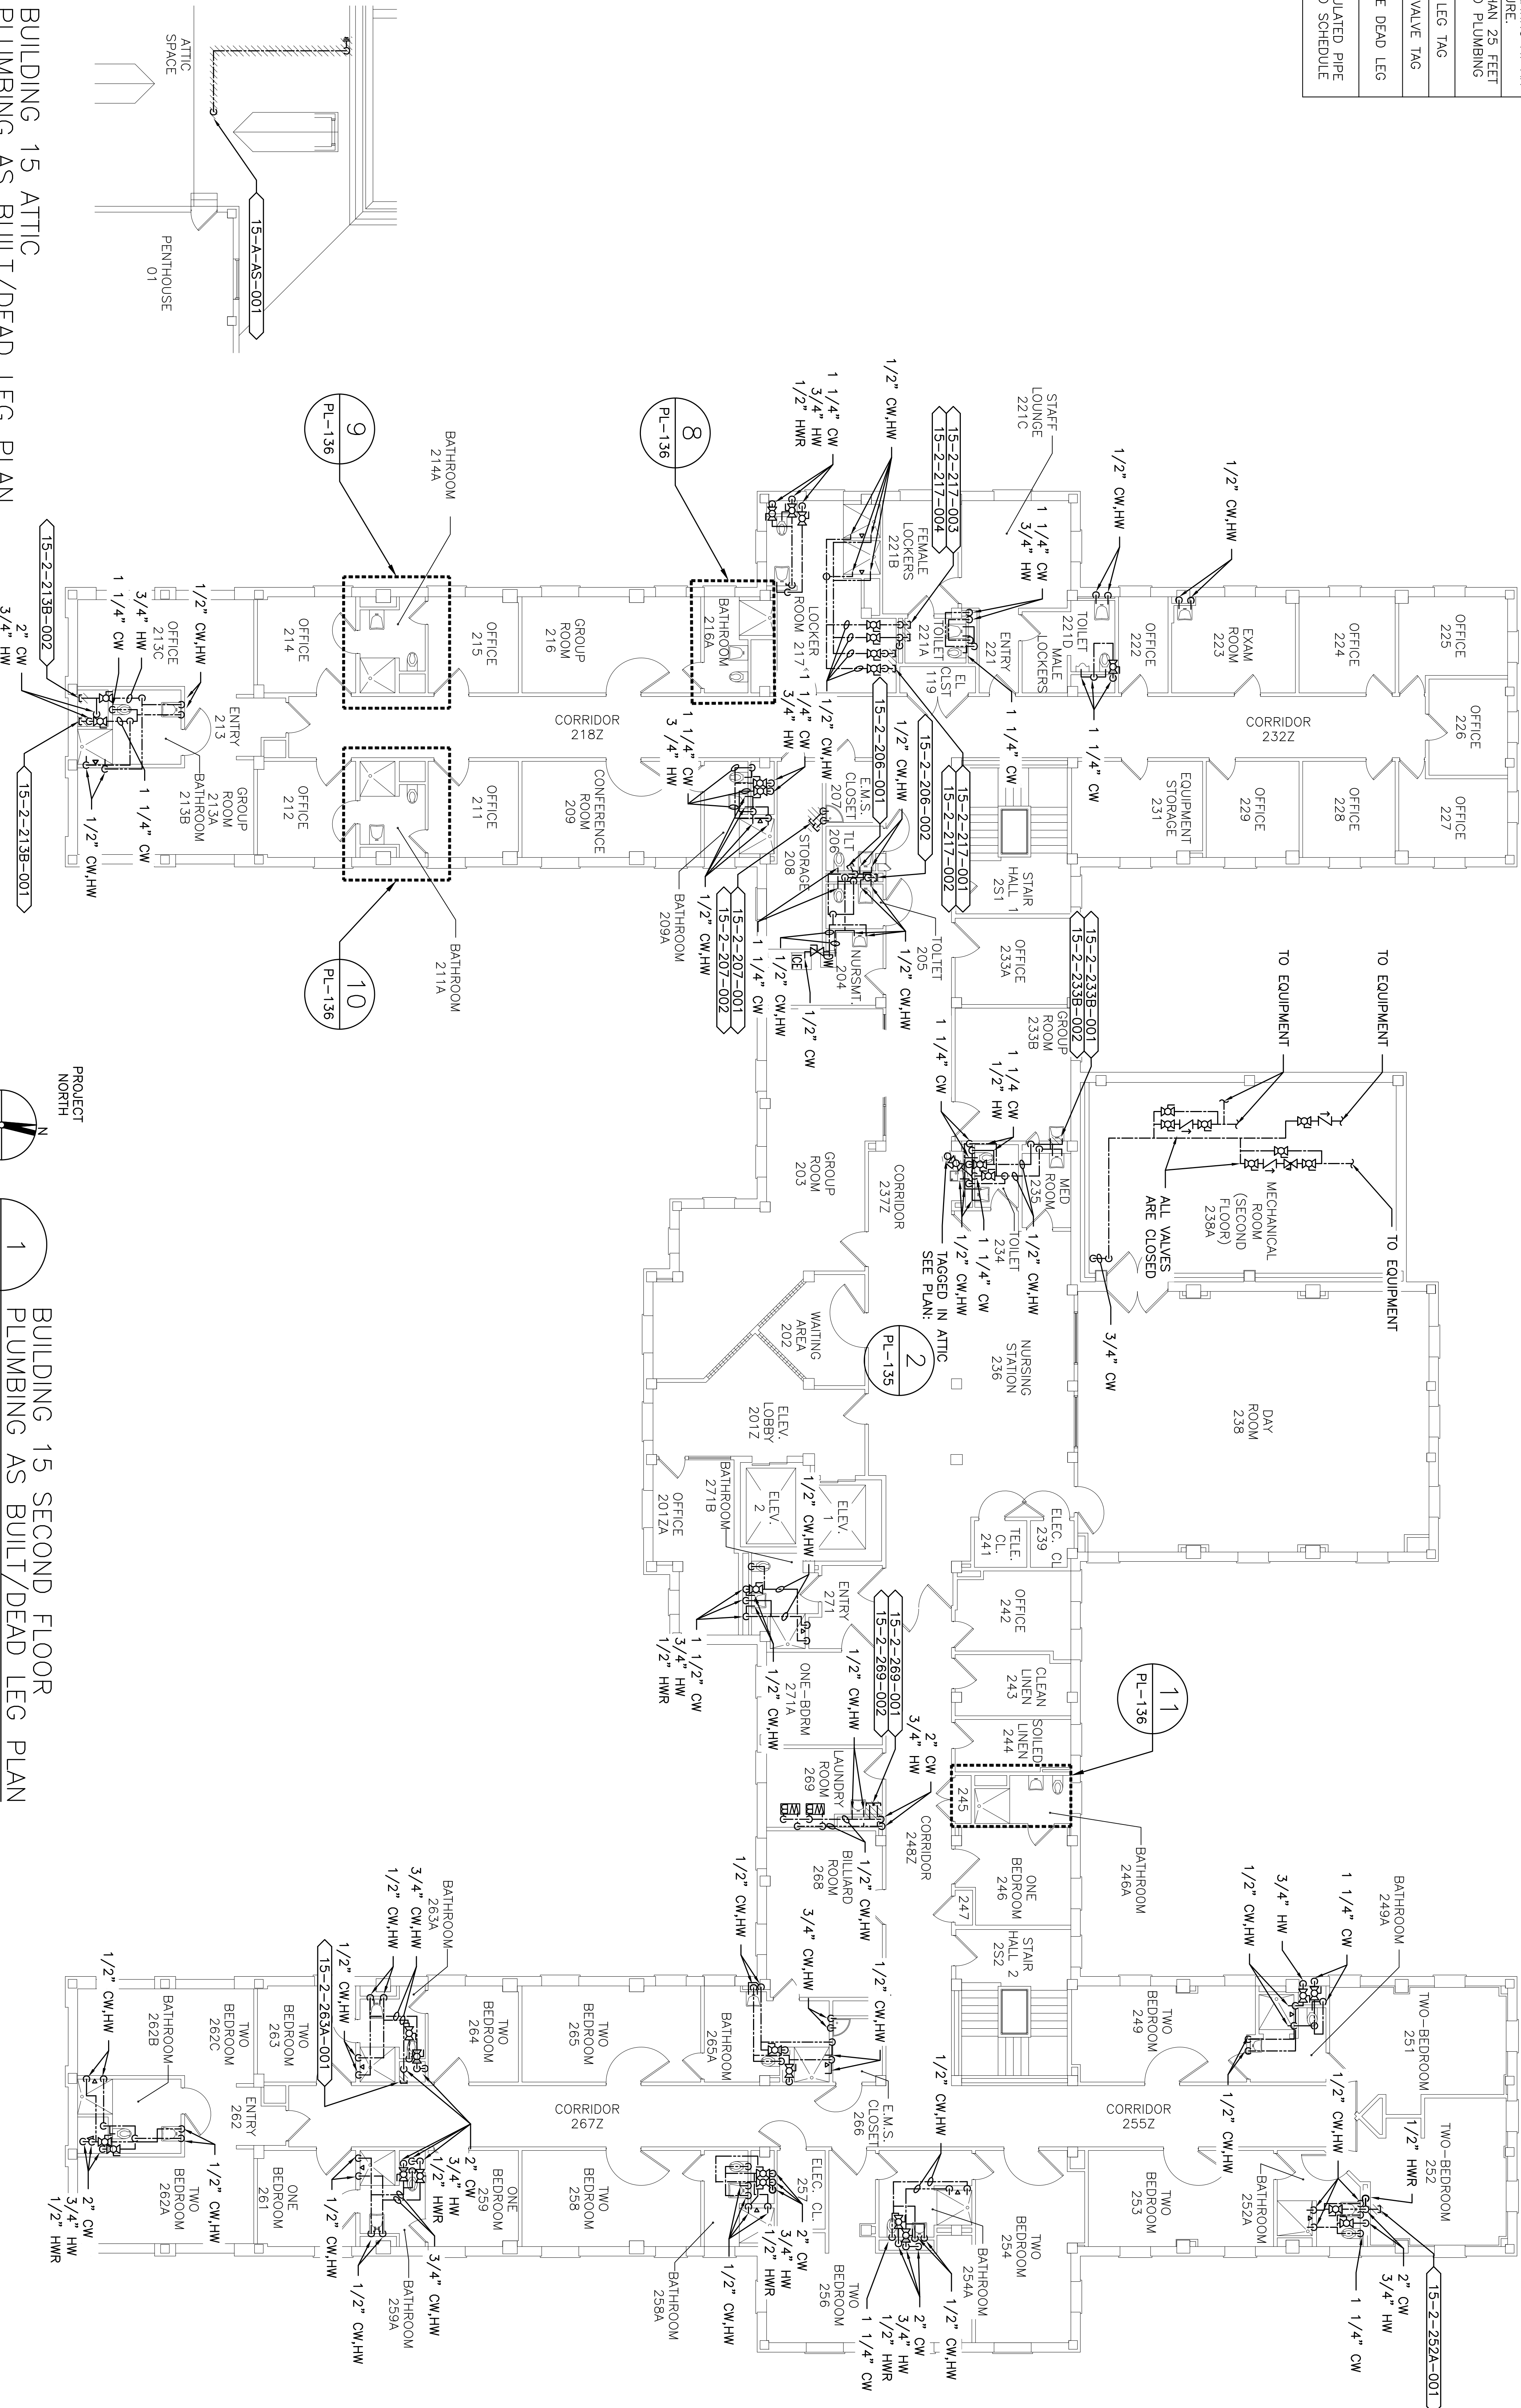

PROJECT NORTH

1 PL-135

BUILDING 15 SECOND FLOOR PLUMBING AS BUILT/DEAD LEG PLAN

SCALE:1/8"=1'-0"

CONSULTANTS:		ARCHITECT/ENGINEERS:		NORTH:		Drawing Title		Project Title		Project Number		Engineering Service	
100% Working Drawings Submission						Building 15 Second Floor & Attic Plumbing As-Built / Dead-Leg Plan		Remove Domestic Dead-Legs at the Montrose Campus		620-18-119		Engineering Service	
Revisions:						Approved: Facility Director , VA/HVGS:		Location		Buildings) Number			
								Montrose, New York		15			
										Drawing Number			
						Approved: John Cliffe, Facility Chief of Engineering		Date		Checked		Drawn	
								03-08-2018		MR		MIF	
										PL 135			
										Sheet 57 of 77			

