


PLUMBING FIELD STUDY KEY SYMBOLS	
TYPE A – PIPE LENGTH GREATER THAN TWICE THE DIAMETER OF THE PIPE SIZE TERMINATING AT CAP, VALVE, OR FITTING.	
TYPE B – PIPE LENGTH GREATER THAN TWICE THE DIAMETER OF THE PIPES TERMINATING AT AN INFREQUENTLY USED PLUMBING FIXTURE.	
TYPE C – PIPE LENGTH GREATER THAN 25 FEET TERMINATING AT A FREQUENTLY USED PLUMBING FIXTURE	
◁ XXX-XX-XXX-XXX ▷	DEAD LEG TAG
XXX-XX-XXX-XXX	MIXING VALVE TAG
//////	REMEDiate DEAD LEG
NI-0	NON-INSULATED PIPE REFER TO SCHEDULE

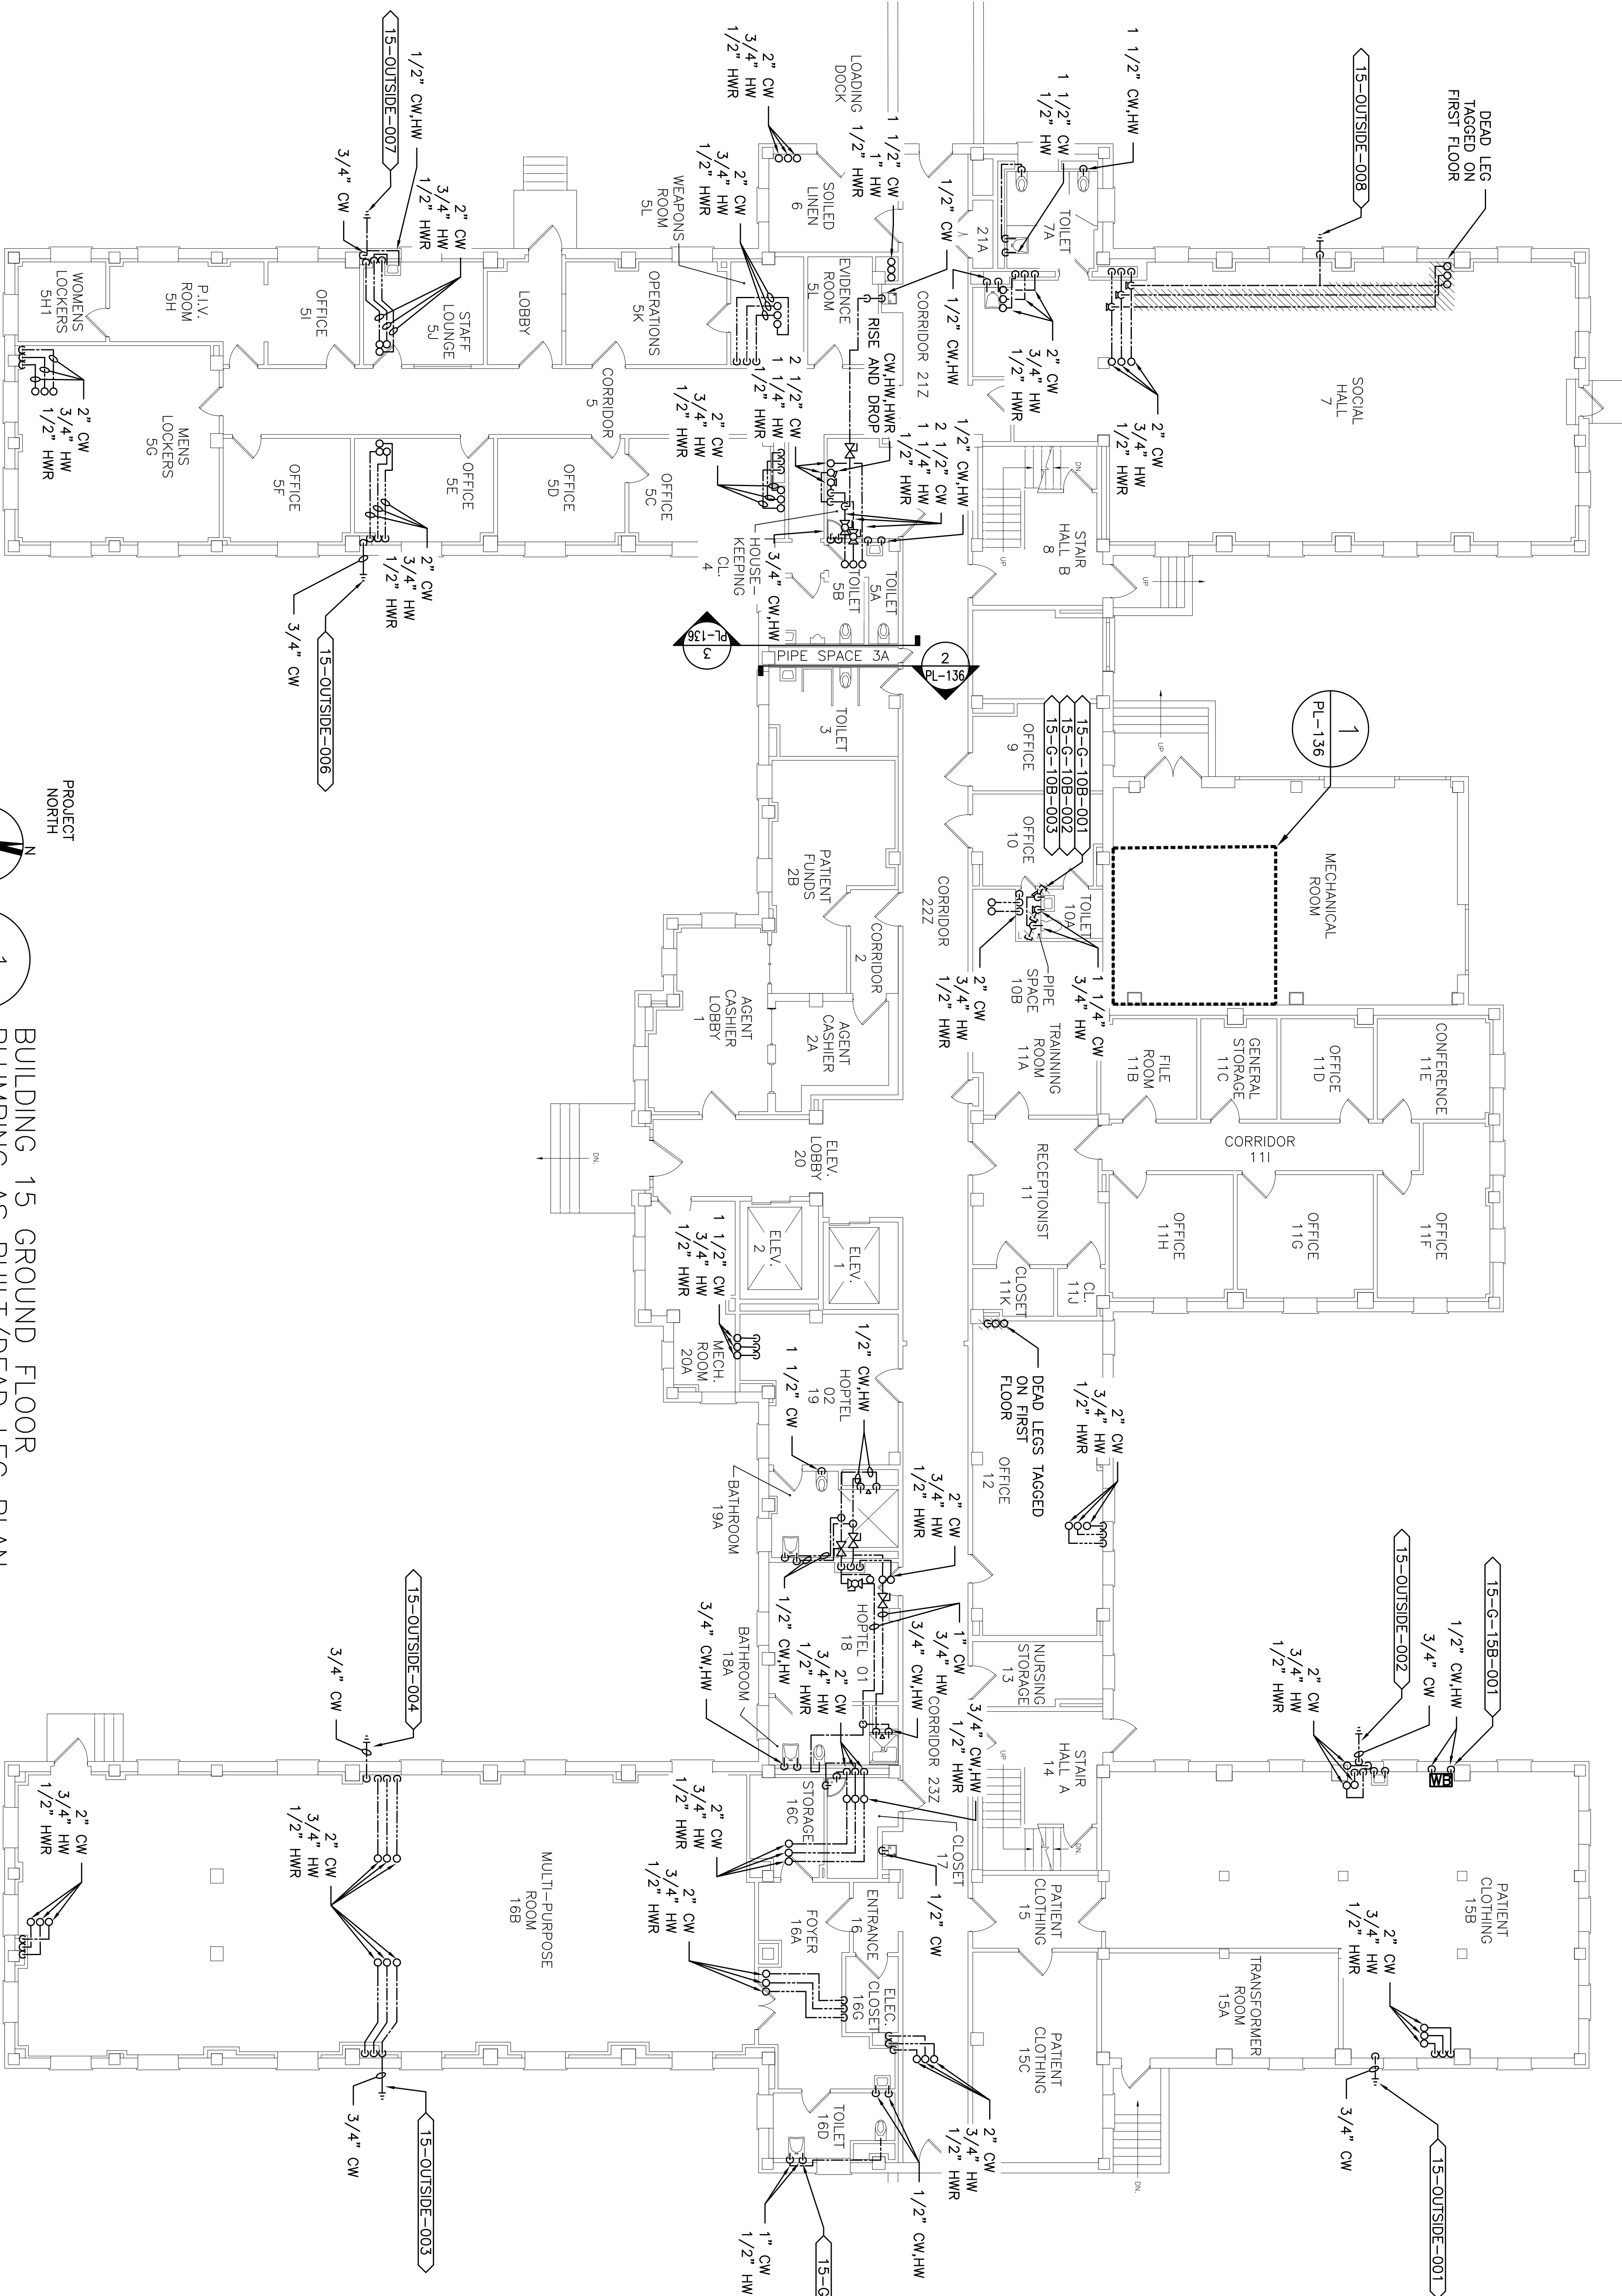

PROJECT NORTH

1

PL-133

BUILDING 15 GROUND FLOOR  
PLUMBING AS BUILT/DEAD LEG PLAN

SCALE: 1/8"=1'-0"

																																																																																																																																																																																																																																																																																																																																																																																																																																																																																																																																																																																																																																																																																																																																																																																																																																																																																																																																																																																																																																																																																																																																																																																																																																																																																																																																																																																																																					</
--	--	----