

A

B

C

D

E

F

three eighths inch = one foot
one and one half inches = one foot
one inch = one foot
three quarters inch = one foot
one half inch = one foot
three eighths inch = one foot
one quarter inch = one foot
one eighth inch = one foot

A

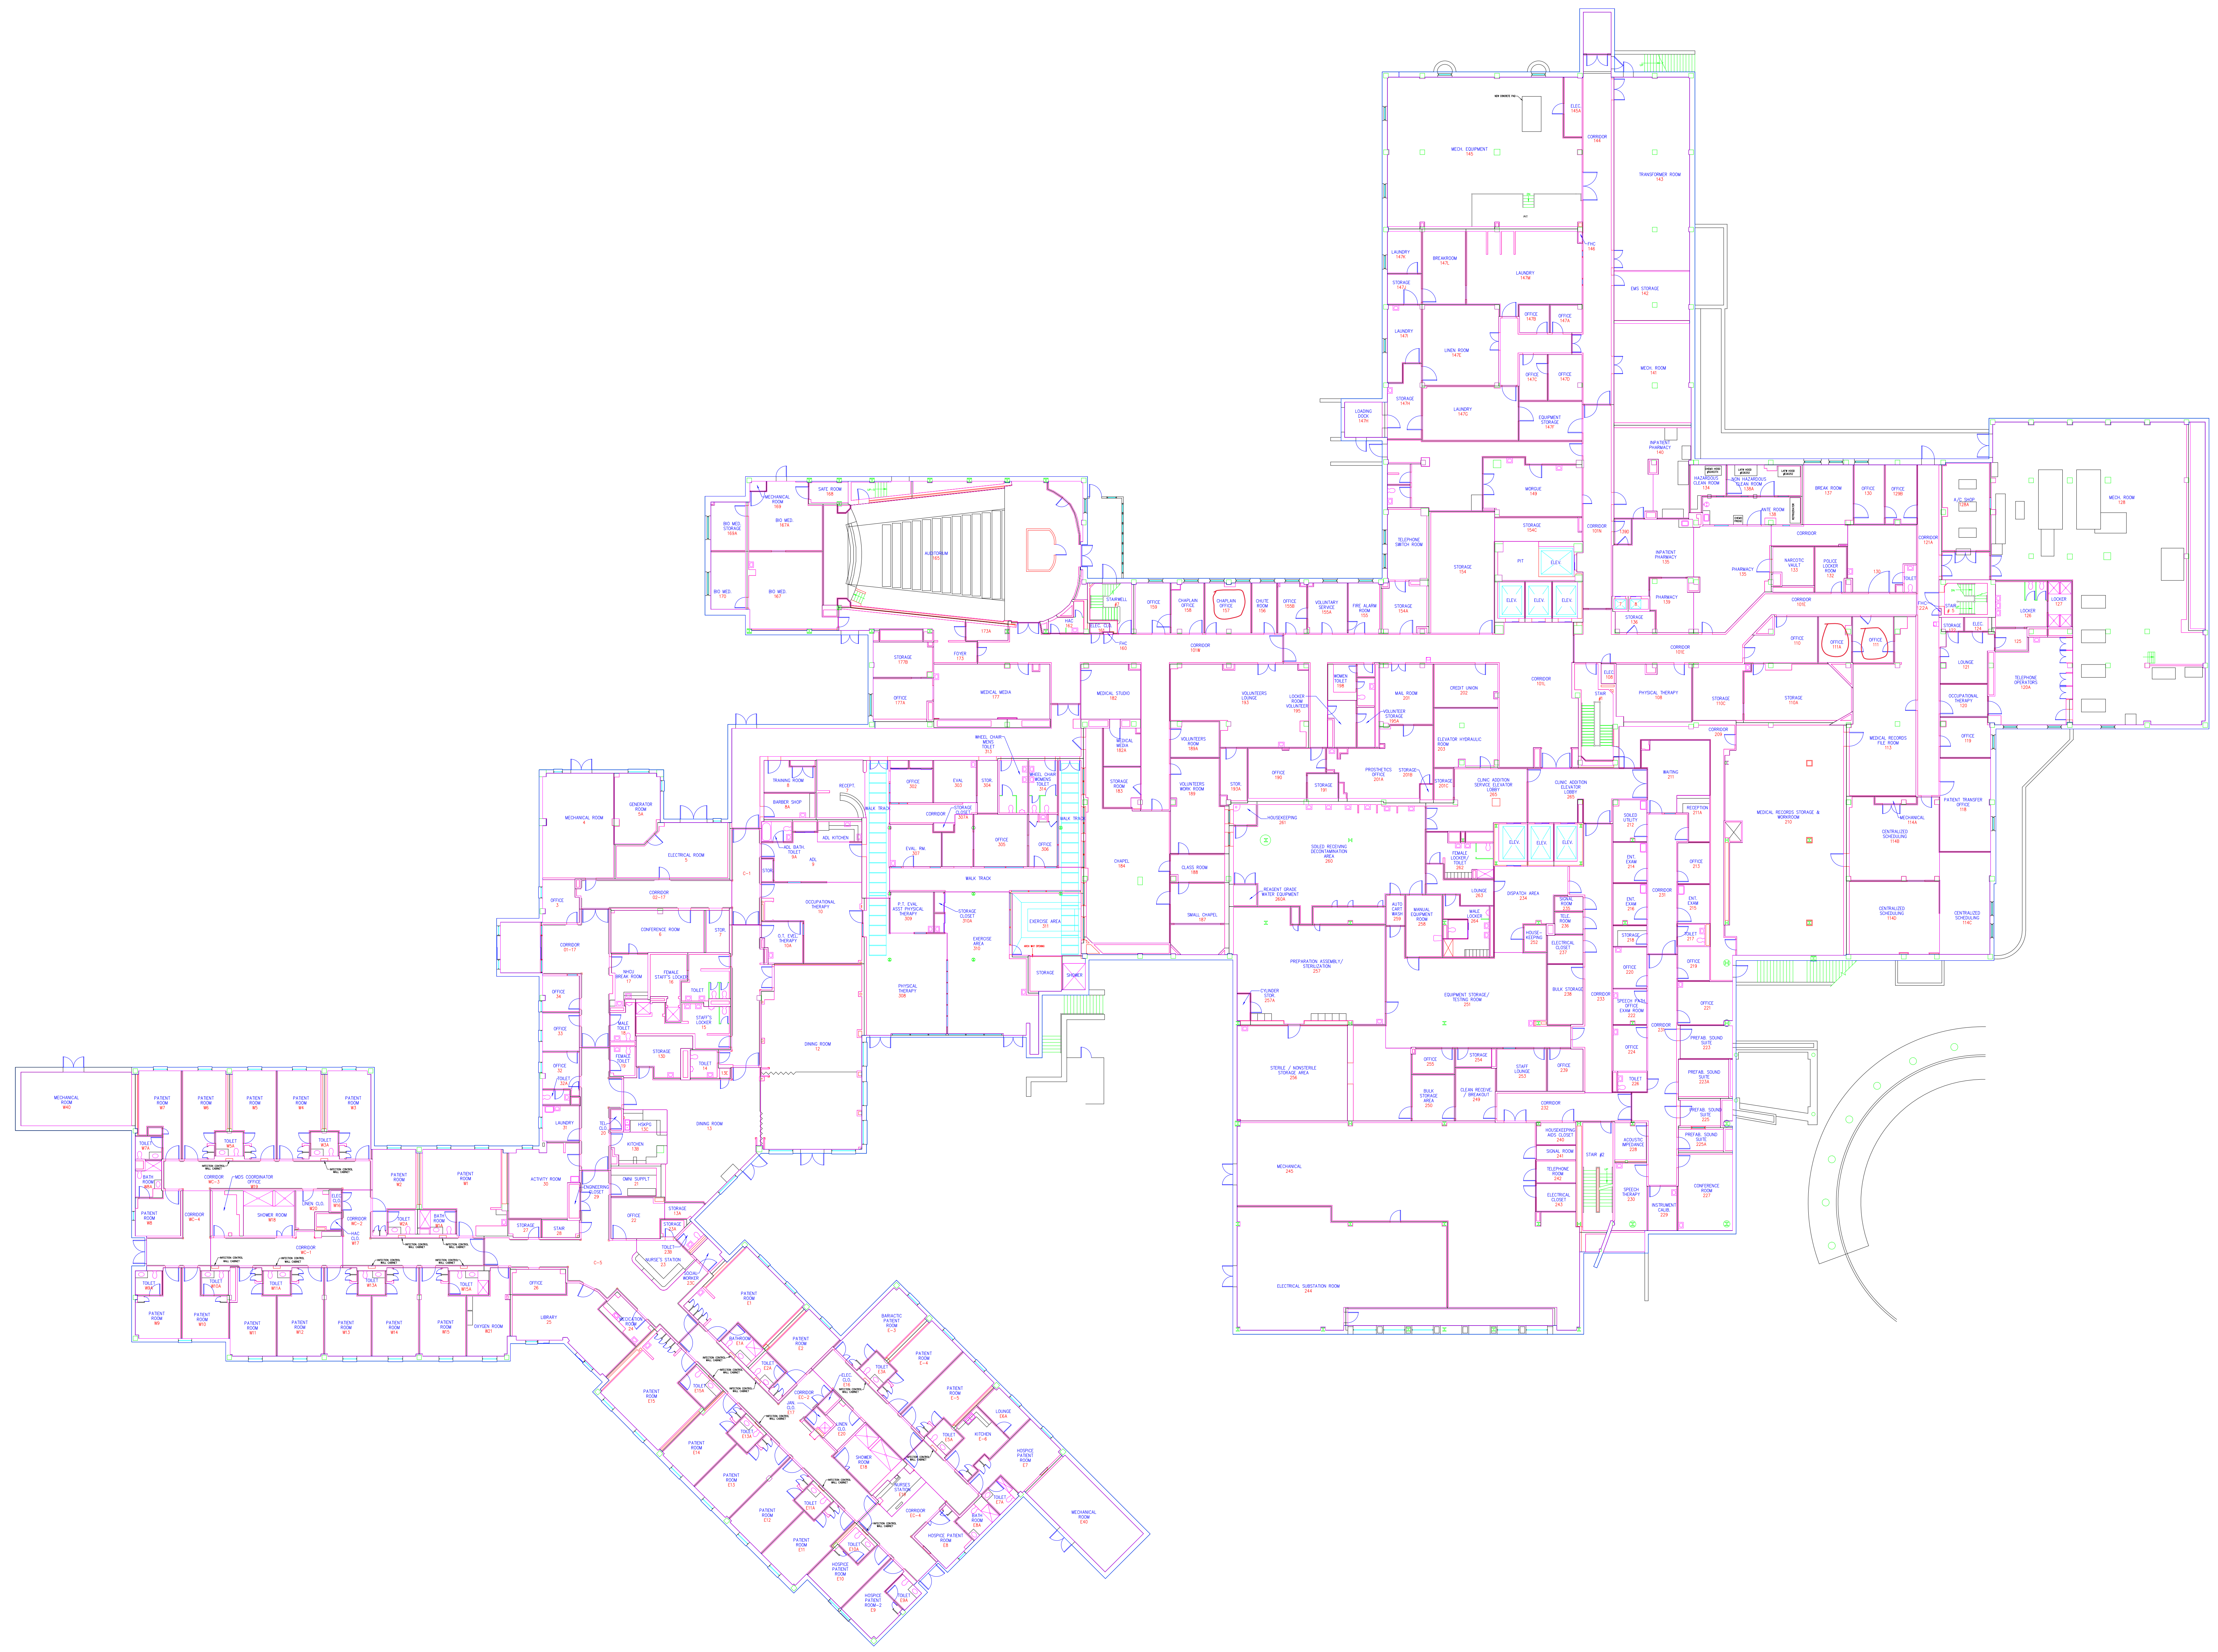
B

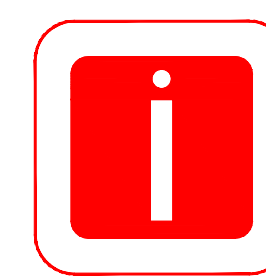
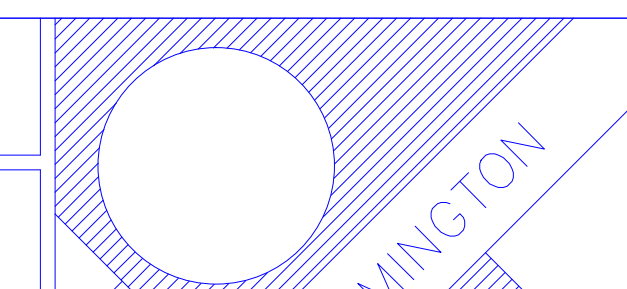
C

D

E

F



				<div><div></div><div>Indus Systems, Inc. 2352, Main Street, Concord MA 01742 Tel: 978-461-0555 www.indus-systems.com</div></div>		<div>Drawing Title GROUND FLOOR PLAN ARCHITECTURAL</div>		<div>Project Title AS-BUILT Drawings</div>		<div>Date 03-11-2013</div> <div>Project No.</div>		<div></div>		<div>VA Department of Veterans Affairs</div>	
Revisions		Date		Professional Seal		<div>Approved:</div>		<div>Building Number 01</div>		<div>Checked</div>		<div>Drawn</div>		<div>Drawing No. 460-1-G-AR</div>	
						<div>Approved:</div>		<div>Location VAMC WILMINGTON DELAWARE</div>							