


A
three inches = one foot
1
0
6
B
one and one half inches = one foot
2
0
6
C
one inch = one foot
2
0
6
D
three quarters inch = one foot
4
0
6
E
one half inch = one foot
4
0
6
F
three eighths inch = one foot
8
0
6
G
one quarter inch = one foot
16
0
6
H
one eighth inch = one foot
32
0
6

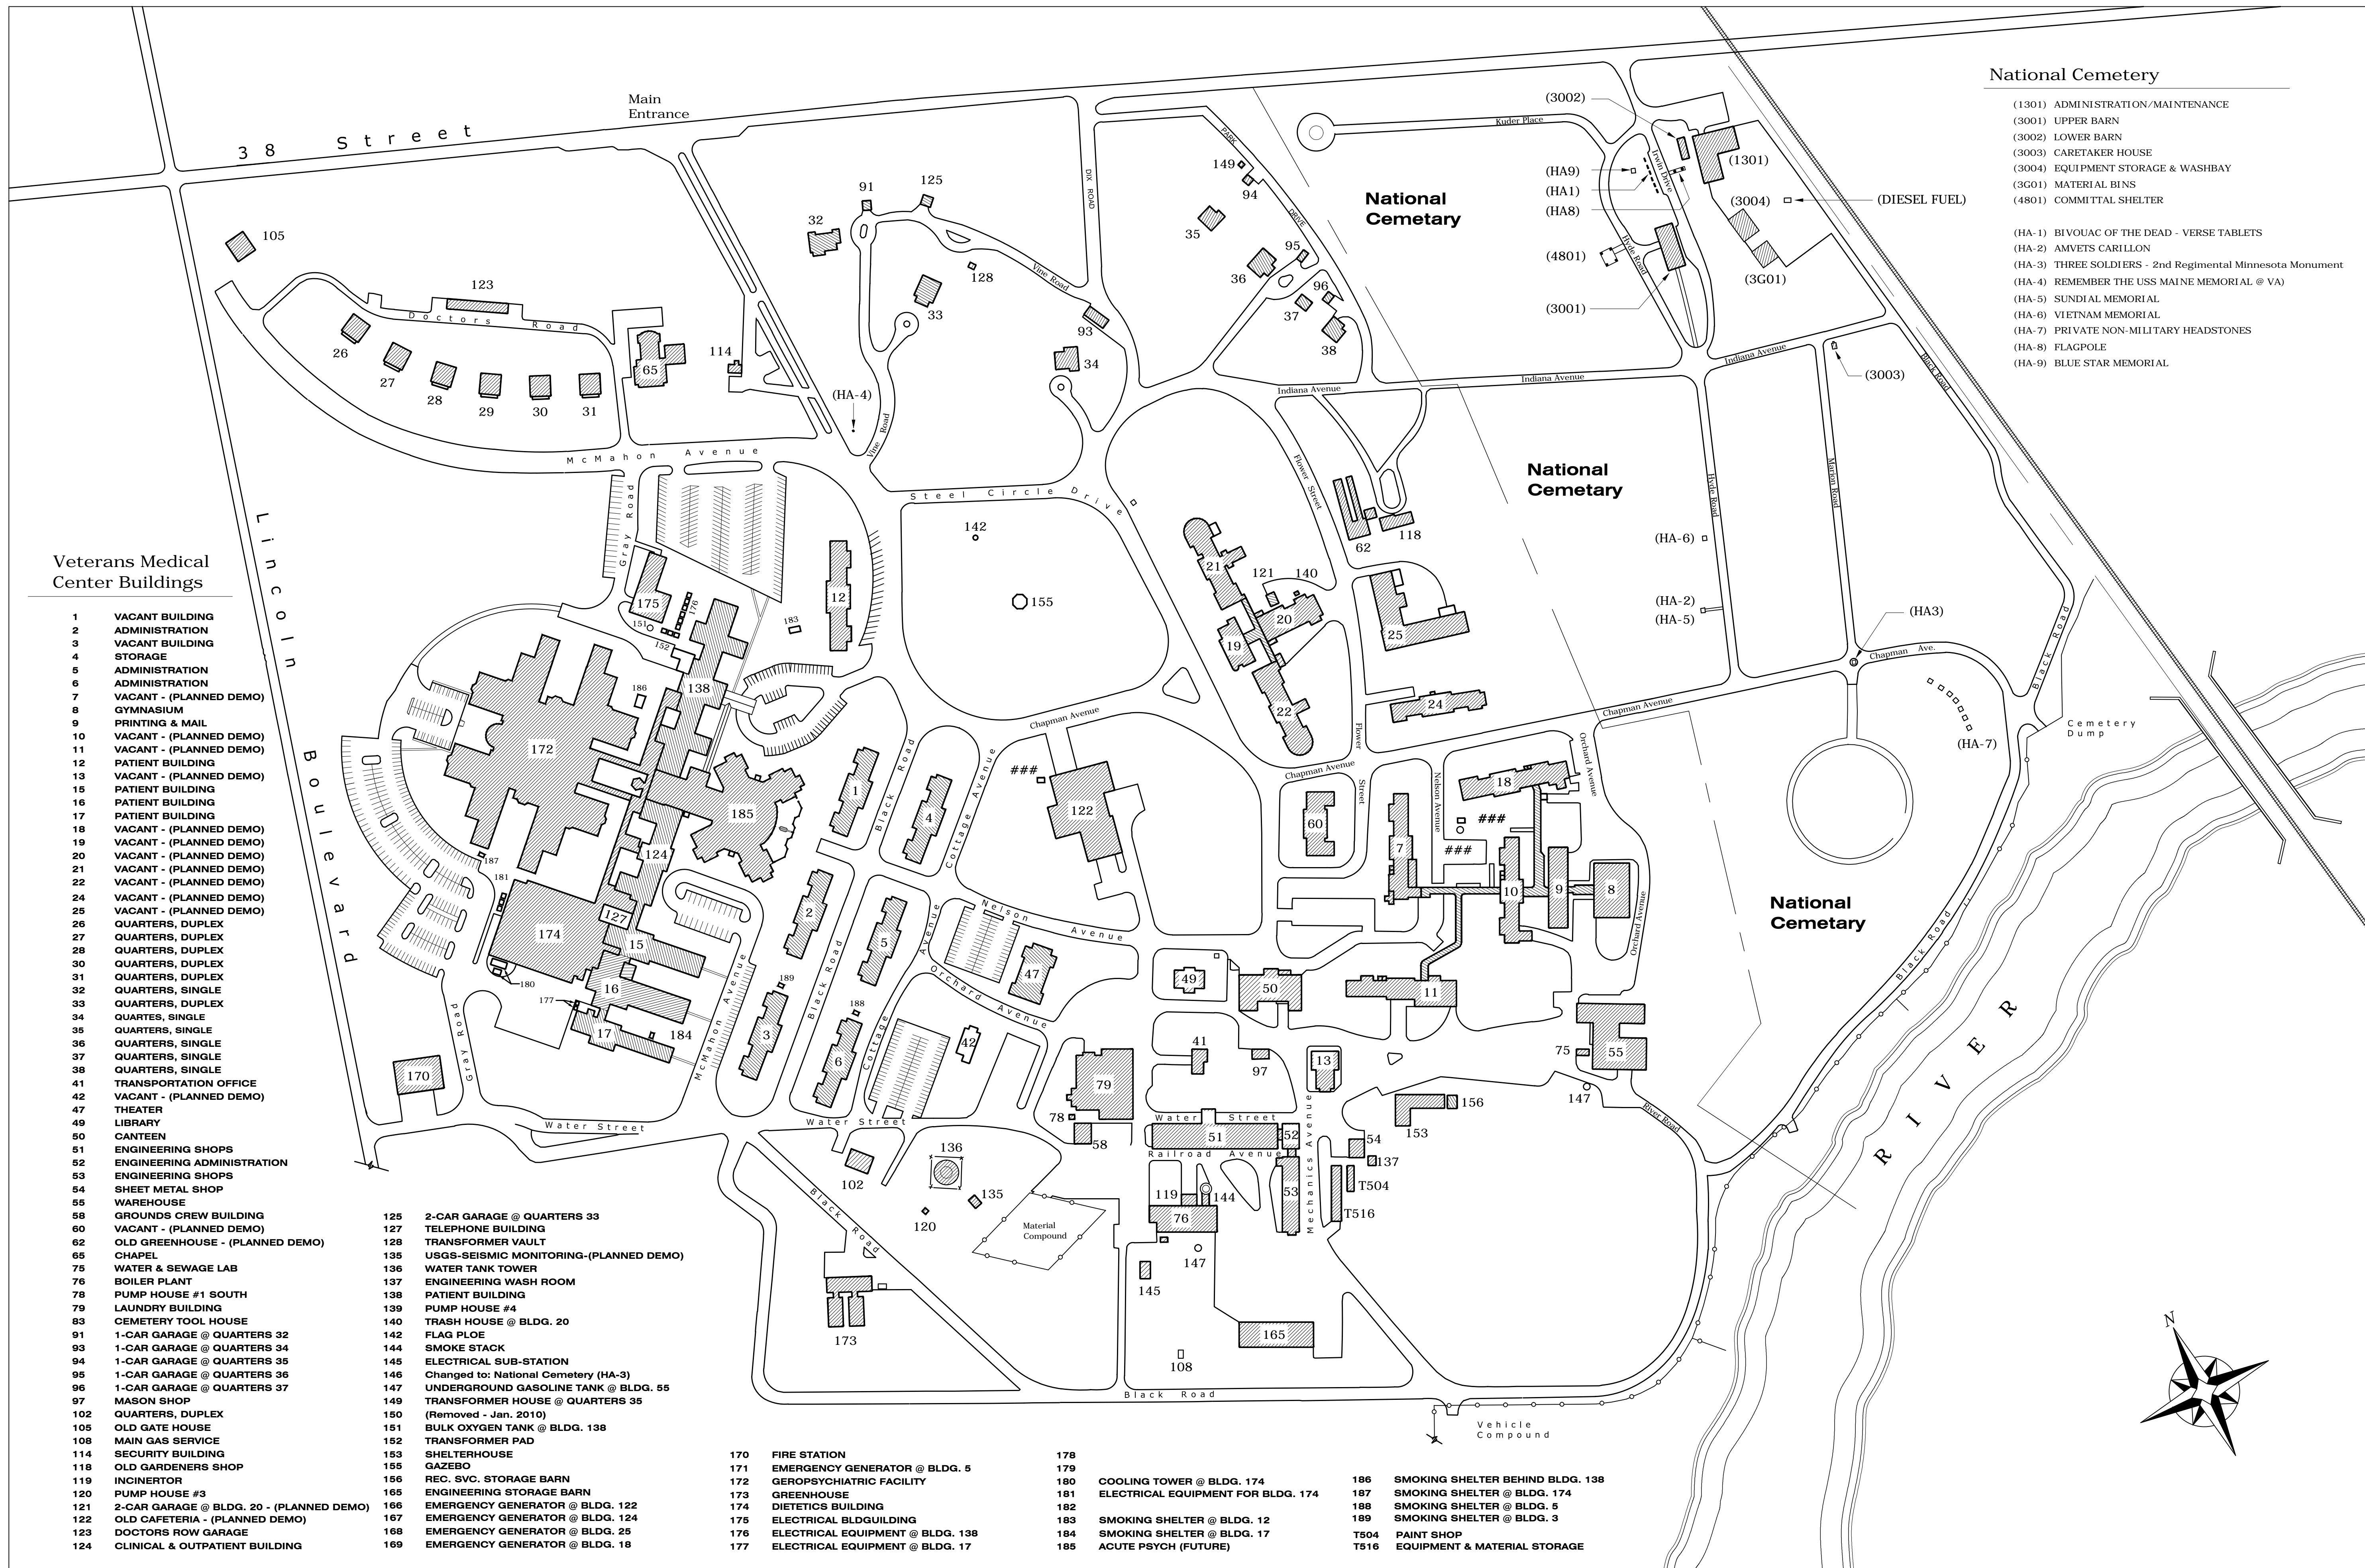

VA Northern Indiana Health Care
System, Marion
1700 E 38th Street
Marion, IN 46953

Drawing Title
Plot Plan
VA NIHCS, Marion Campus
Site Record Drawings

REVISED TO CURRENT CONDITIONS		ELKINS	01/20/2010
SYM	REVISIONS	BY	DATE
Project Number		Building Number	
Location VA NIHCS, Marion, IN		Drawing Number	
Date	Checked	Drawn	Dwg. 1 of 11

