


BLDG. 17
SECOND FLOOR

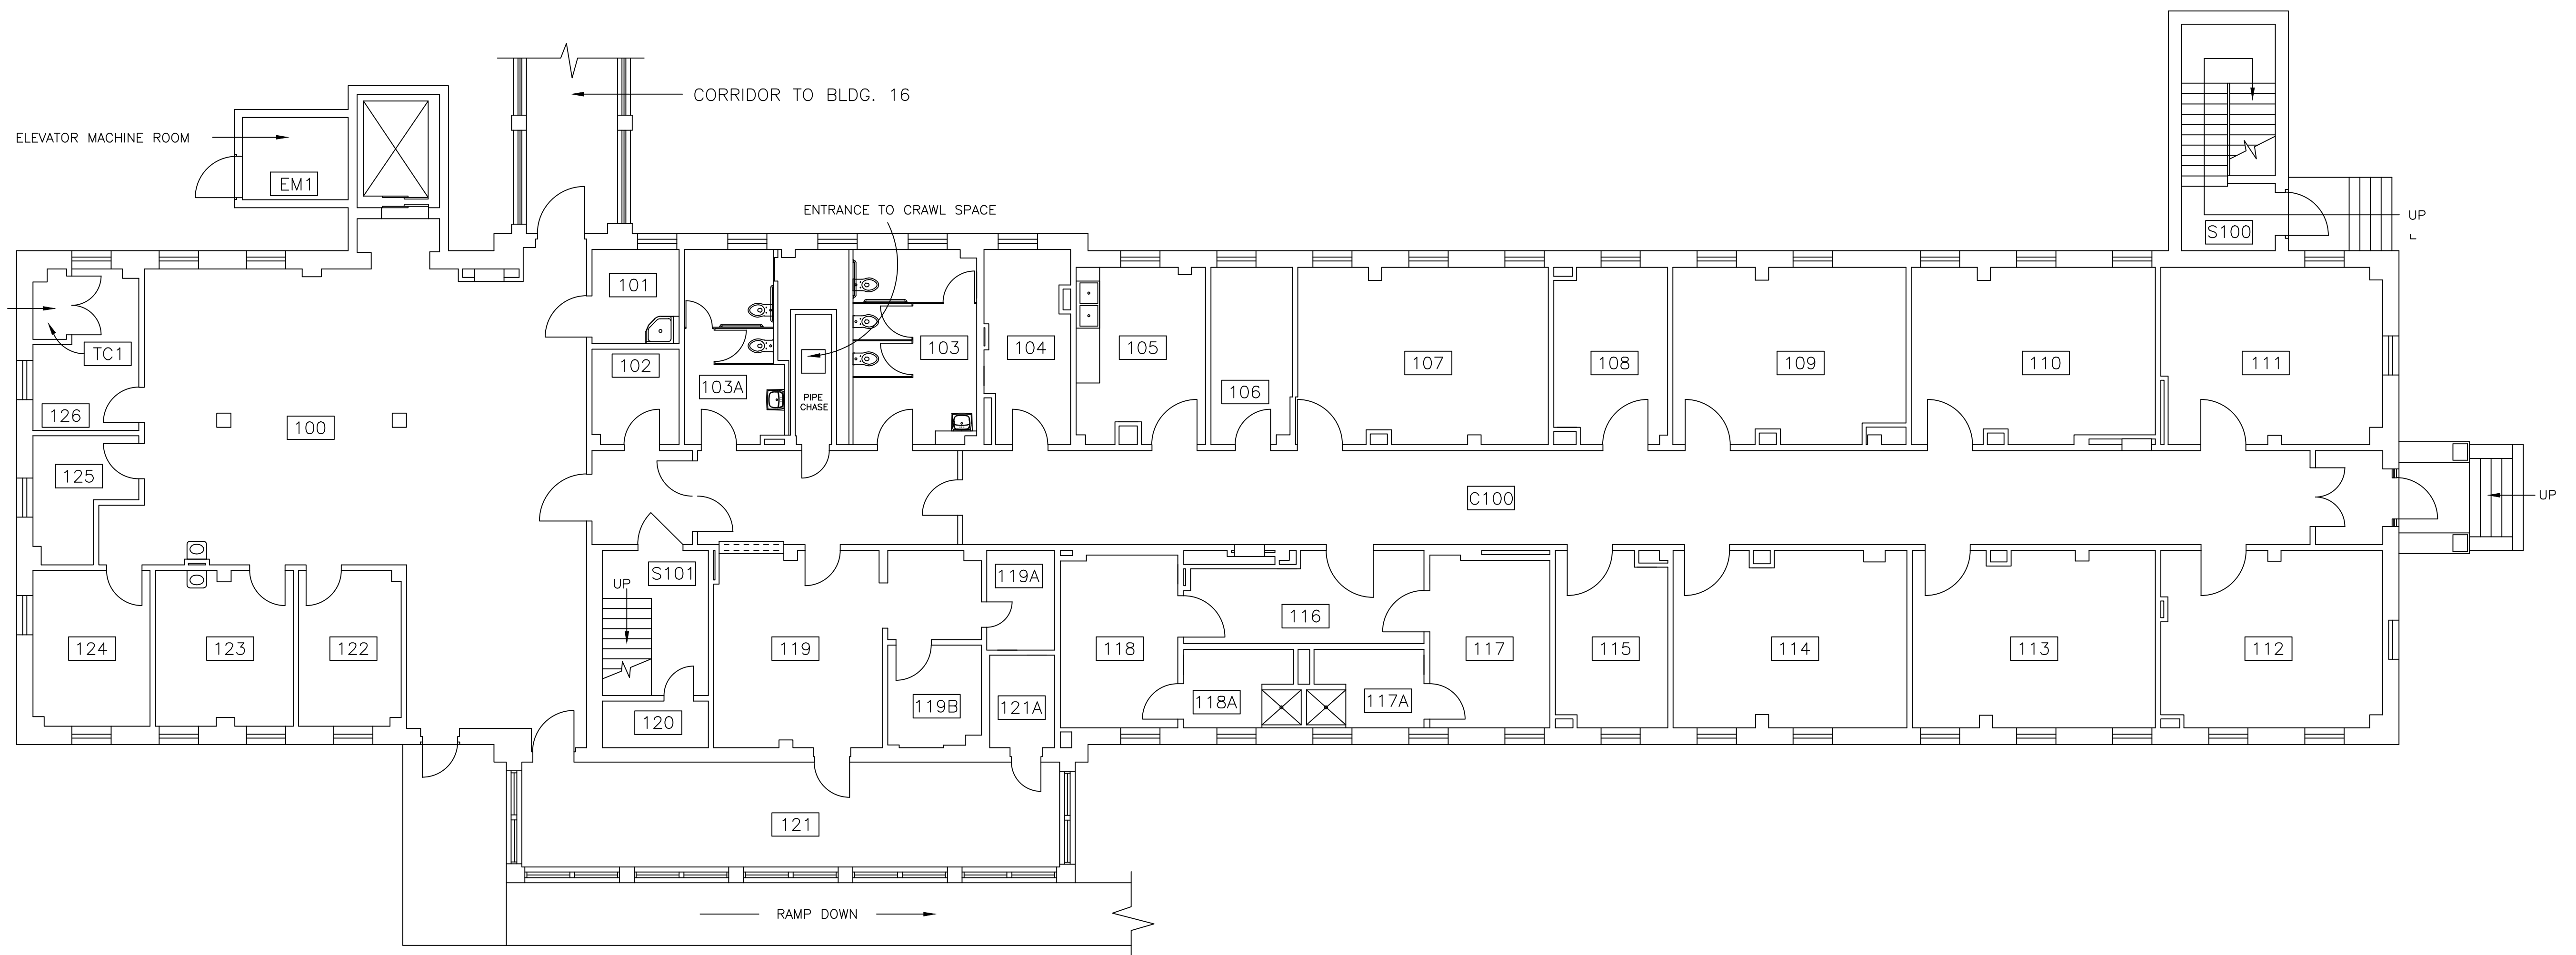

BLDG. 17
FIRST FLOOR
SCALE: 1/8" = 1'0"

	CAD File:	Approved: Medical Center Director	DRAWING TITLE AS-BUILT DWG.		SYM		REVISIONS		BY	DATE
		Approved: Medical Center Assoc. Director			PROJECT TITLE		DATE 3-11-08			
		Approved: Chief, Engineering Service			BUILDING NO. 17		CHECKED	DRAWN	PROJECT No.	
		Location VA Northern Indiana Health Care System Marion Campus, Marion, IN 46953		DRAWING No. 17		SHEET 1 OF 1		Department of Veterans Affairs		