
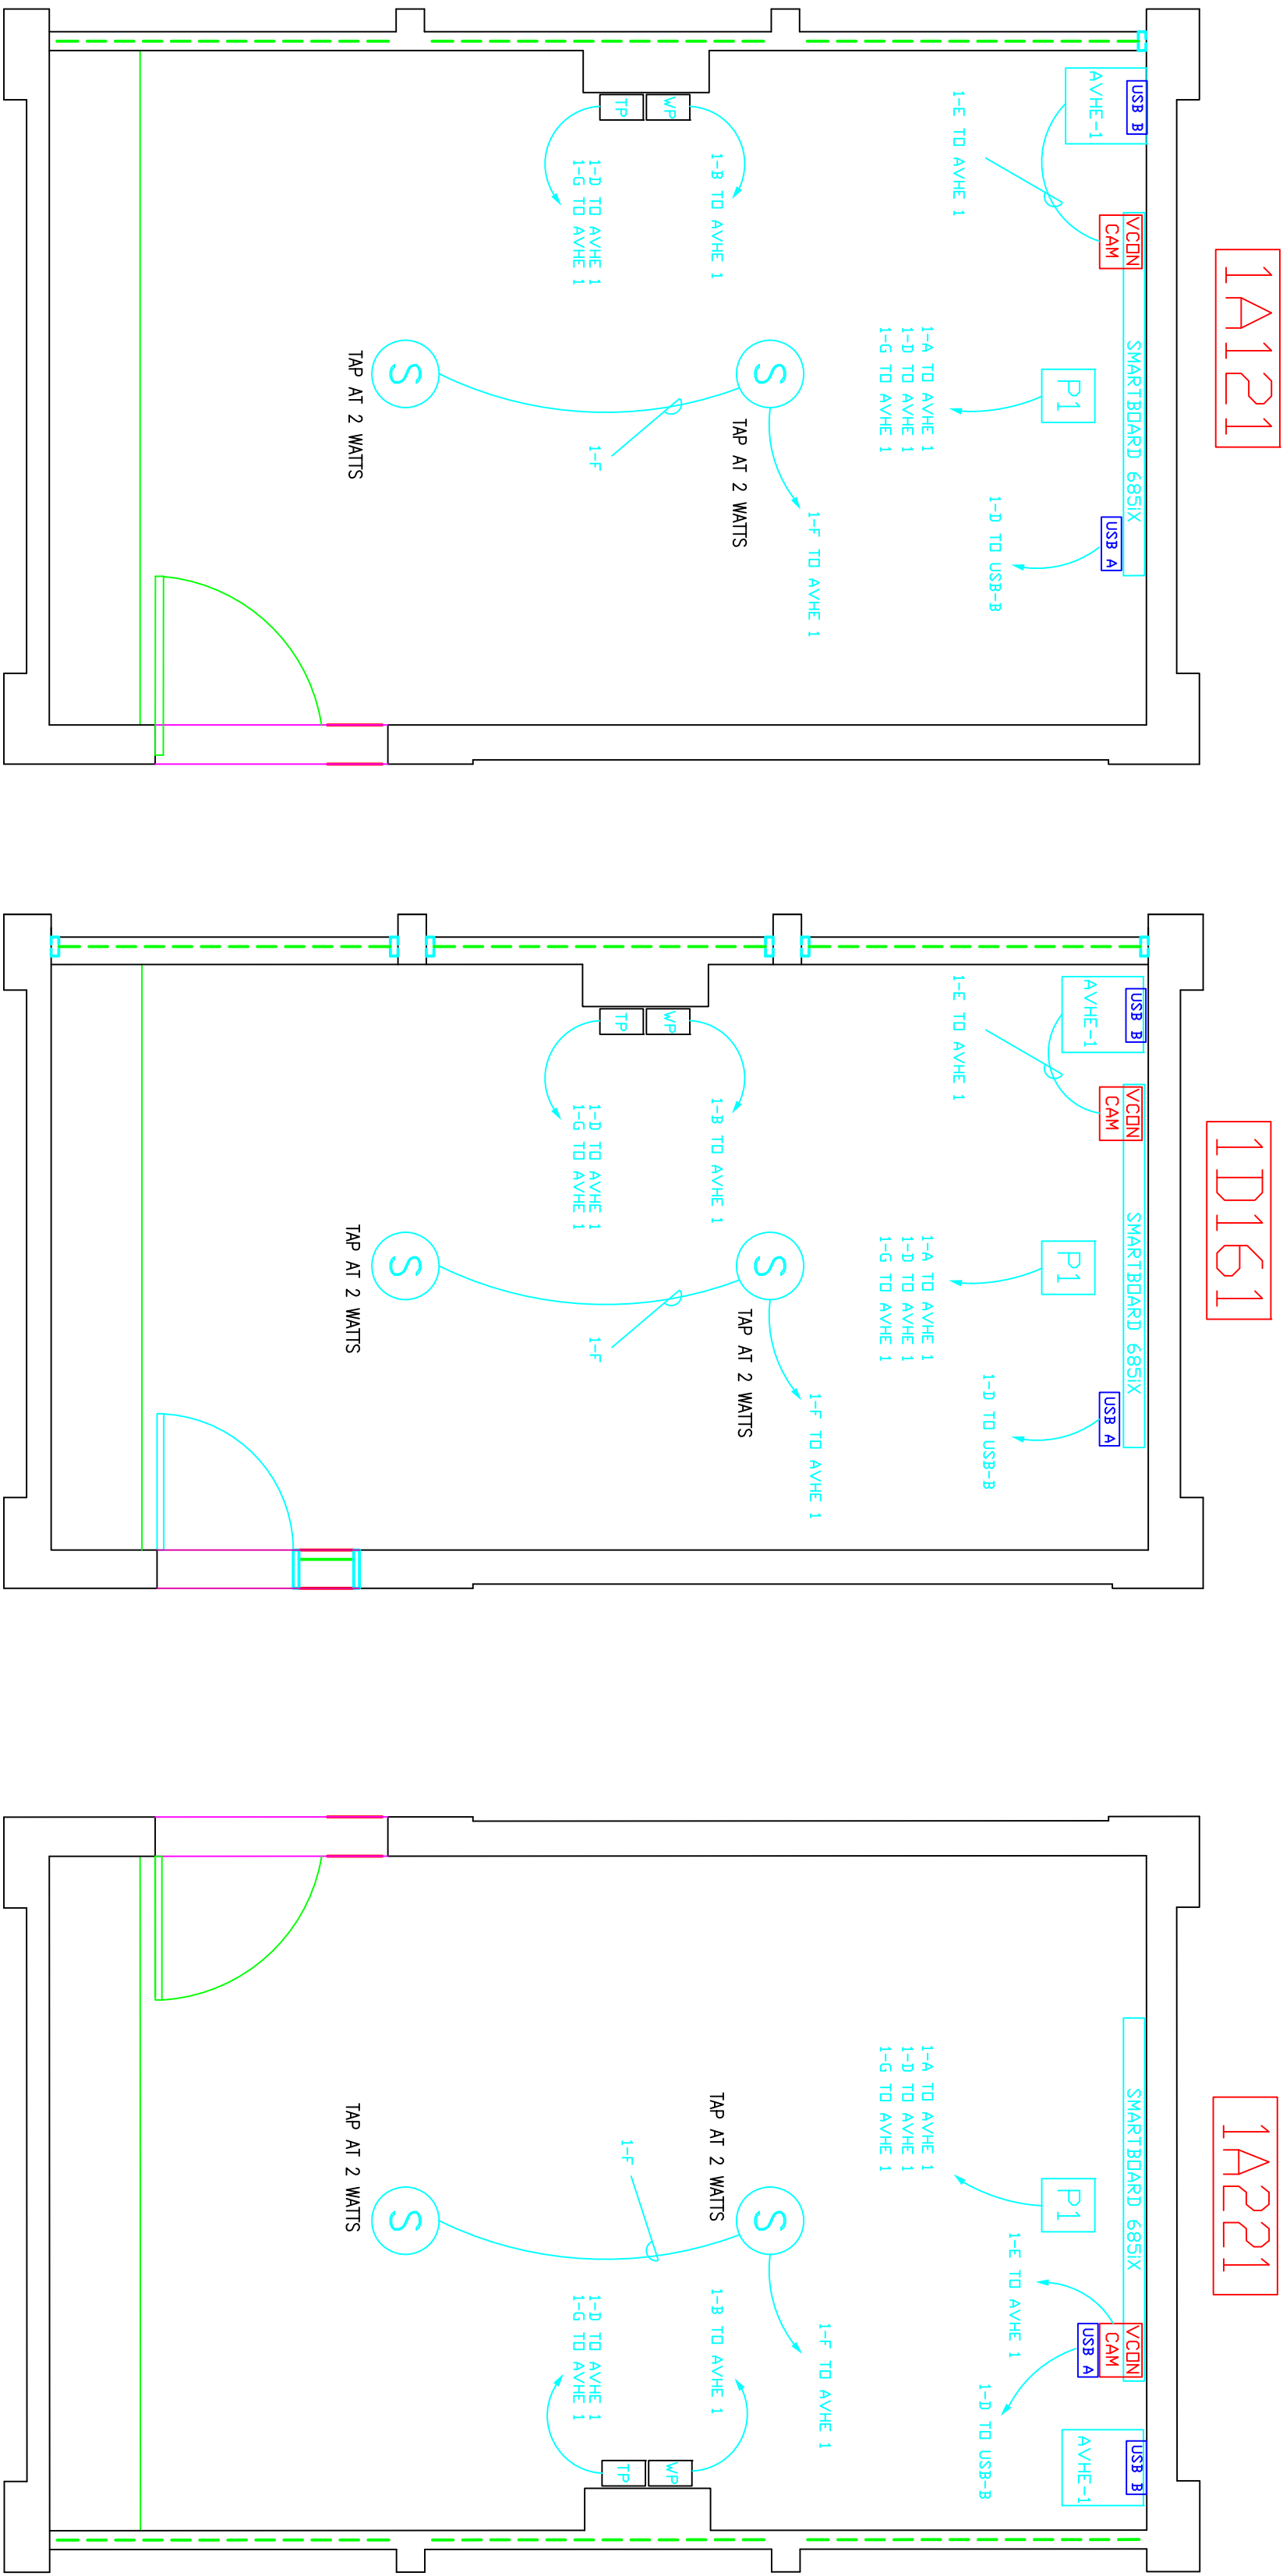



AS-BUILT DRAWING

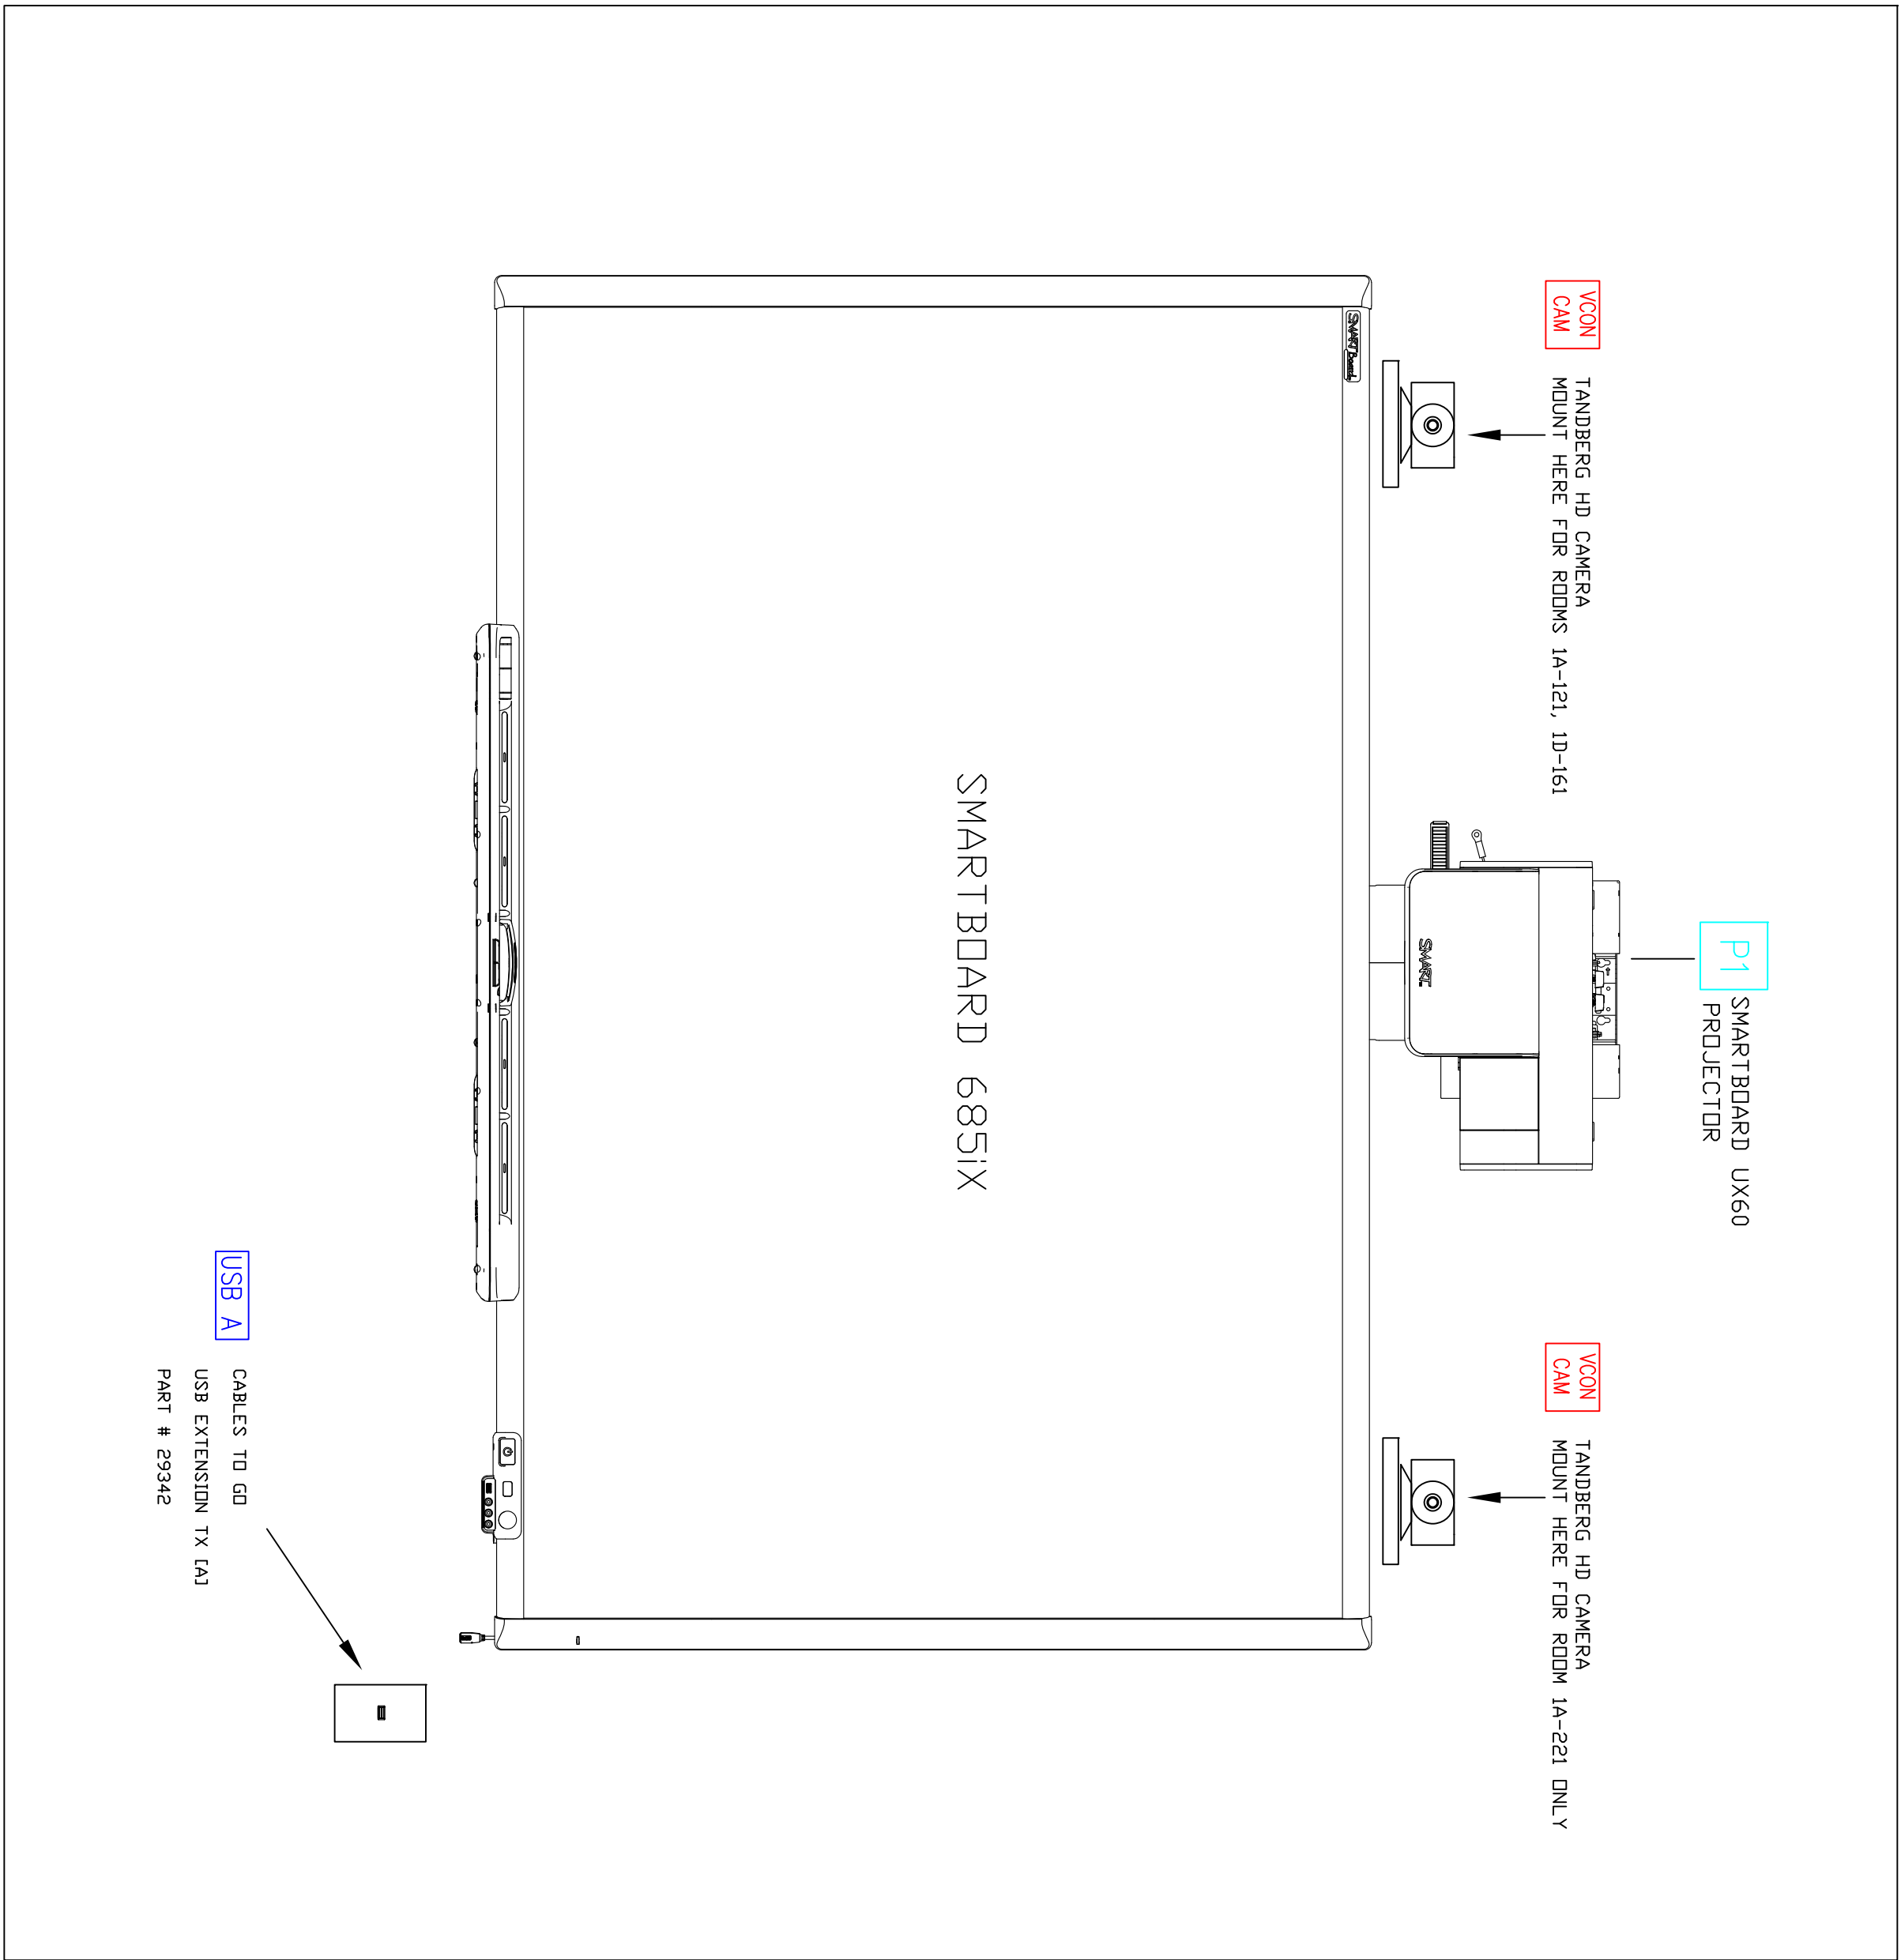

WIRE / CABLE SCHEDULE




ATS TYPE	DESCRIPTION	MANUFAC.	PART #
'A'	35' PC RUNNER, PLENUM	RAPID RUN	50730
'B'	50' PC RUNNER, PLENUM	RAPID RUN	40752
'C'	75' PC RUNNER, PLENUM	RAPID RUN	40753
'D'	CATS DR CAT6 PLENUM		
'E'	CAMERA EXTENSION CABLE	TANDBERG	1161653
'F'	18 AWG 2 COND PLENUM	WESTPENN	25224B
'G'	20 AWG 2 COND SHIELDED PLENUM	WESTPENN	25292B

DESCRIPTION	MANUFAC.	PART #	BACKBOX
AVV INPUT WALLPLATE, WHITE	RAVIO RUN	40854	STANDARD I-G
TOUCH PANEL, REMOTE CONTROL	EXTRON	TLP 350W	REQUIRES LEVITON DECORUM PLATE
CEILING SPEAKER, TAP AT 2 WATTS, 70V	TDA	F-23502B	INCLUDED
USB WALLPLATE, CONVERTS TO CAT6/6	CABLES TO GO	29942	STANDARD I-G
SMART BOARD PROJECTOR	SMART	UX60	STANDARD I-G
VIDEO CONFERENCE CAMERA	TANDBERG	HD	CUSTOMER SUPPLIED, SHEET OR APPROVED
WALL MOUNT BRACK	WIDILE ATLANTIC	DWR-21-22	INCLUDED

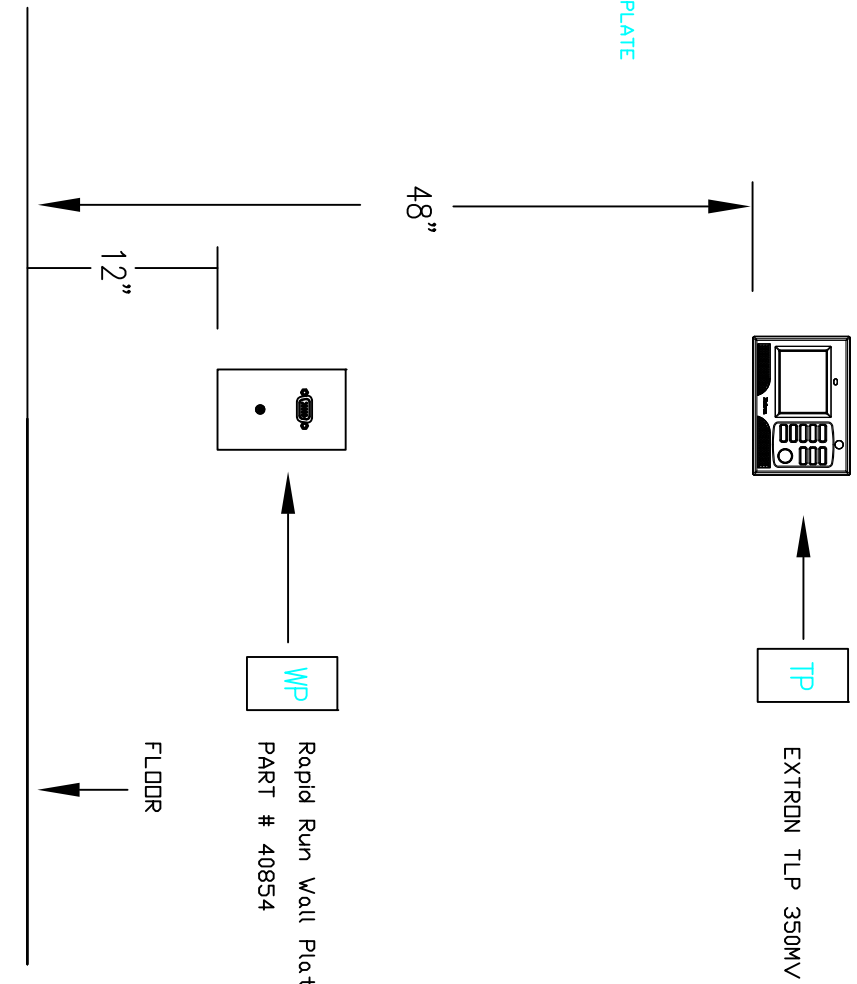





HEALTH EDUCATION BOARDROOMS 1A-121, 1D-161, 1A-221

- 1 PROVIDE 120VAC TO ALL PROJECTORS, SMARTBOARDS, RACKS, AND NEW SCREENS
- 2 FIELD COORDINATE LOCATIONS OF ALL FIELD DEVICES WITH ELECTRICAL
- 3 PROJECTOR (P1), SMARTBOARD 685IX, & VICON CAM TO BE SUPPLIED BY CUSTOMER

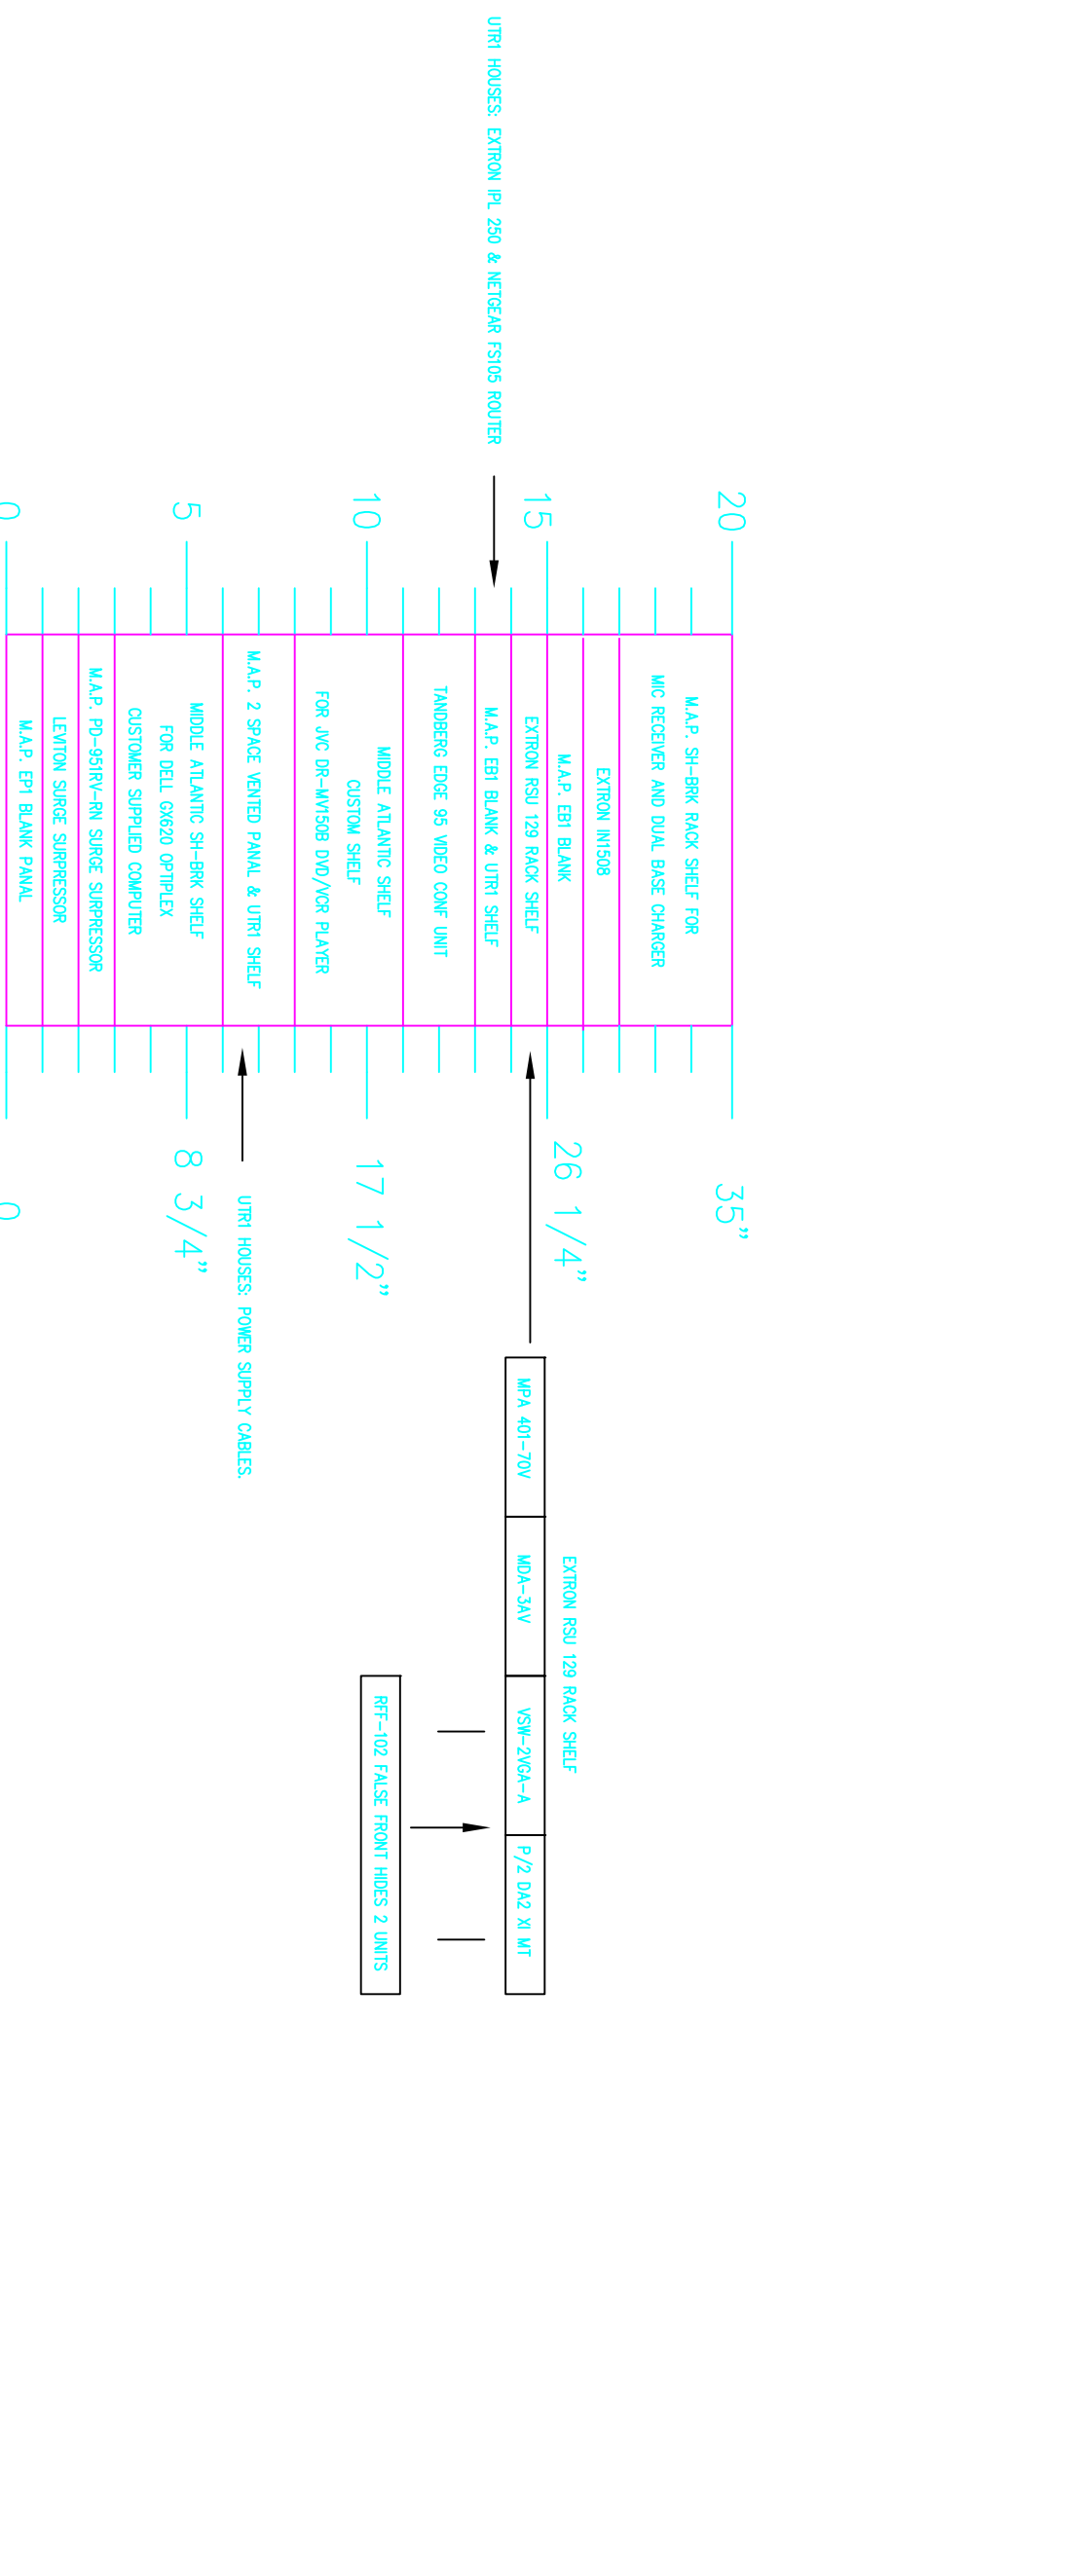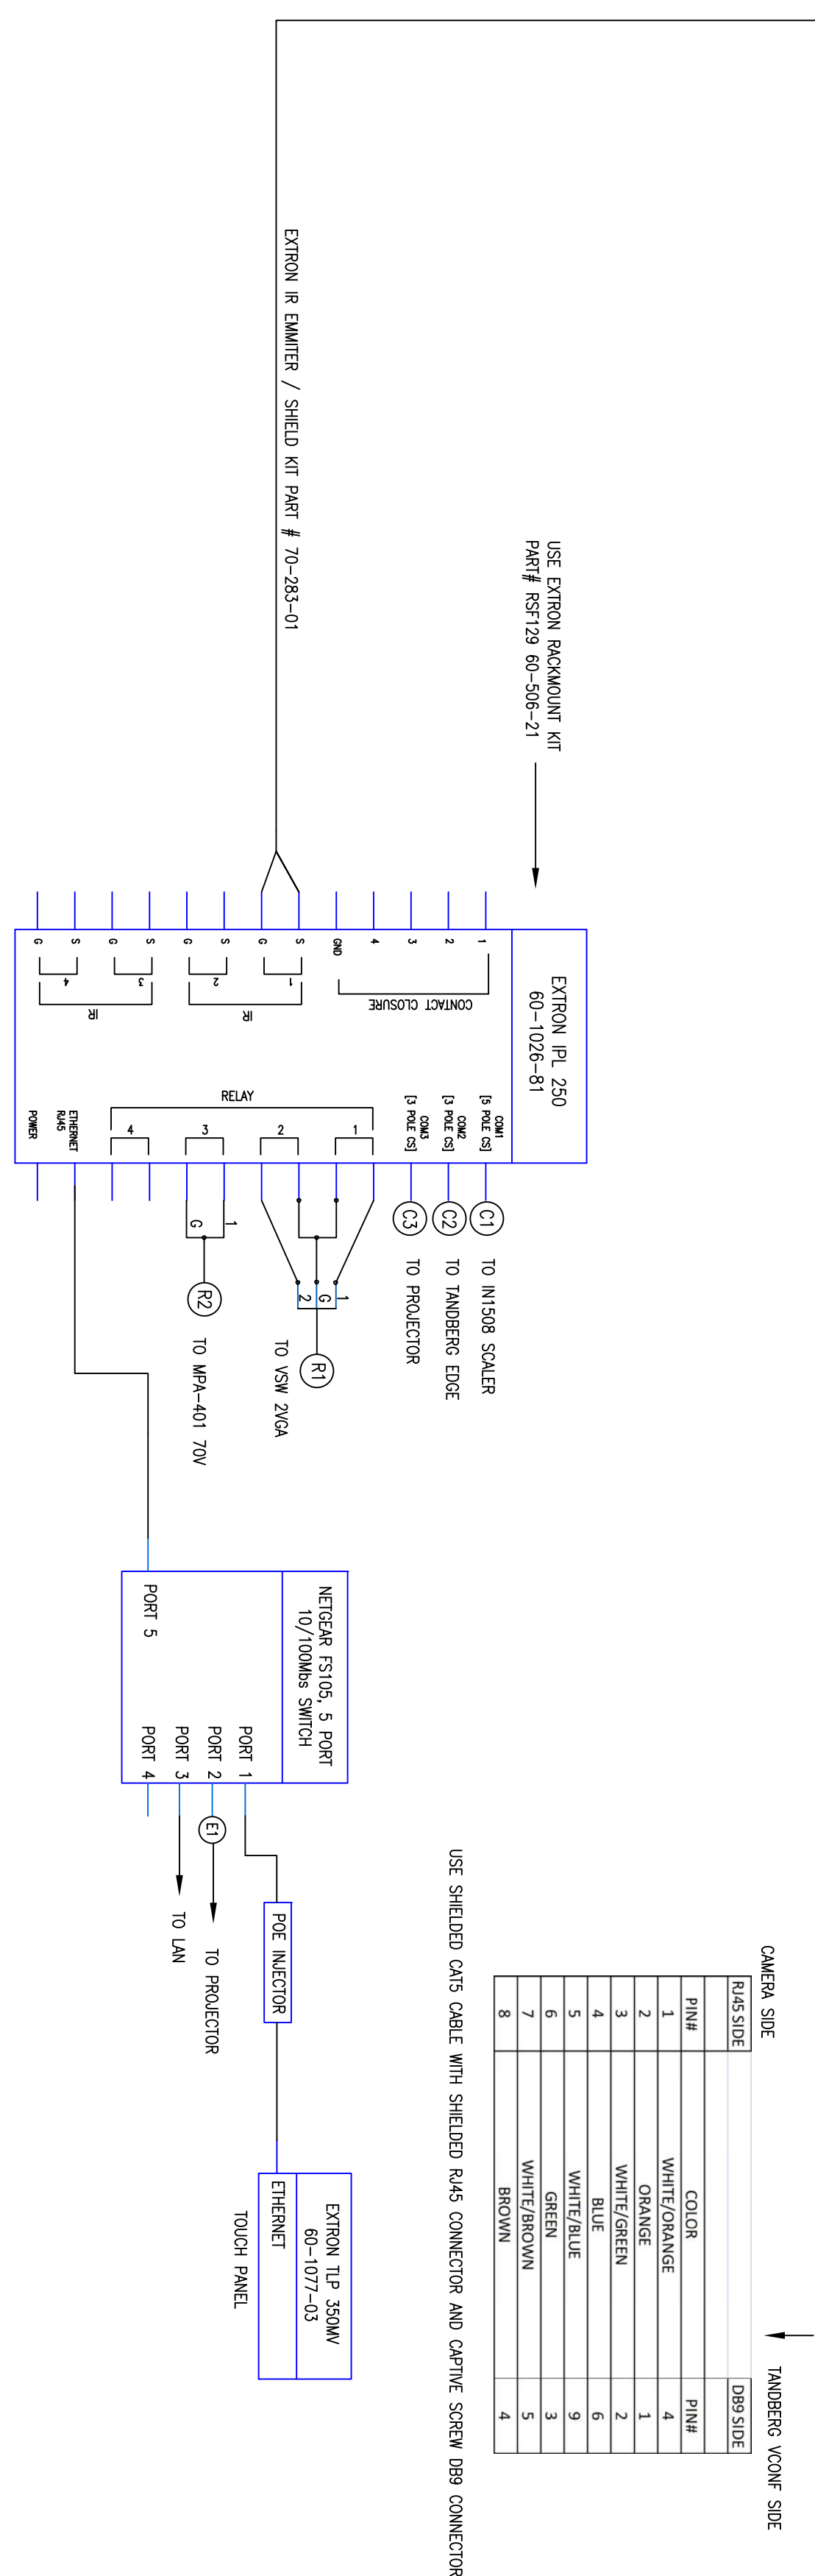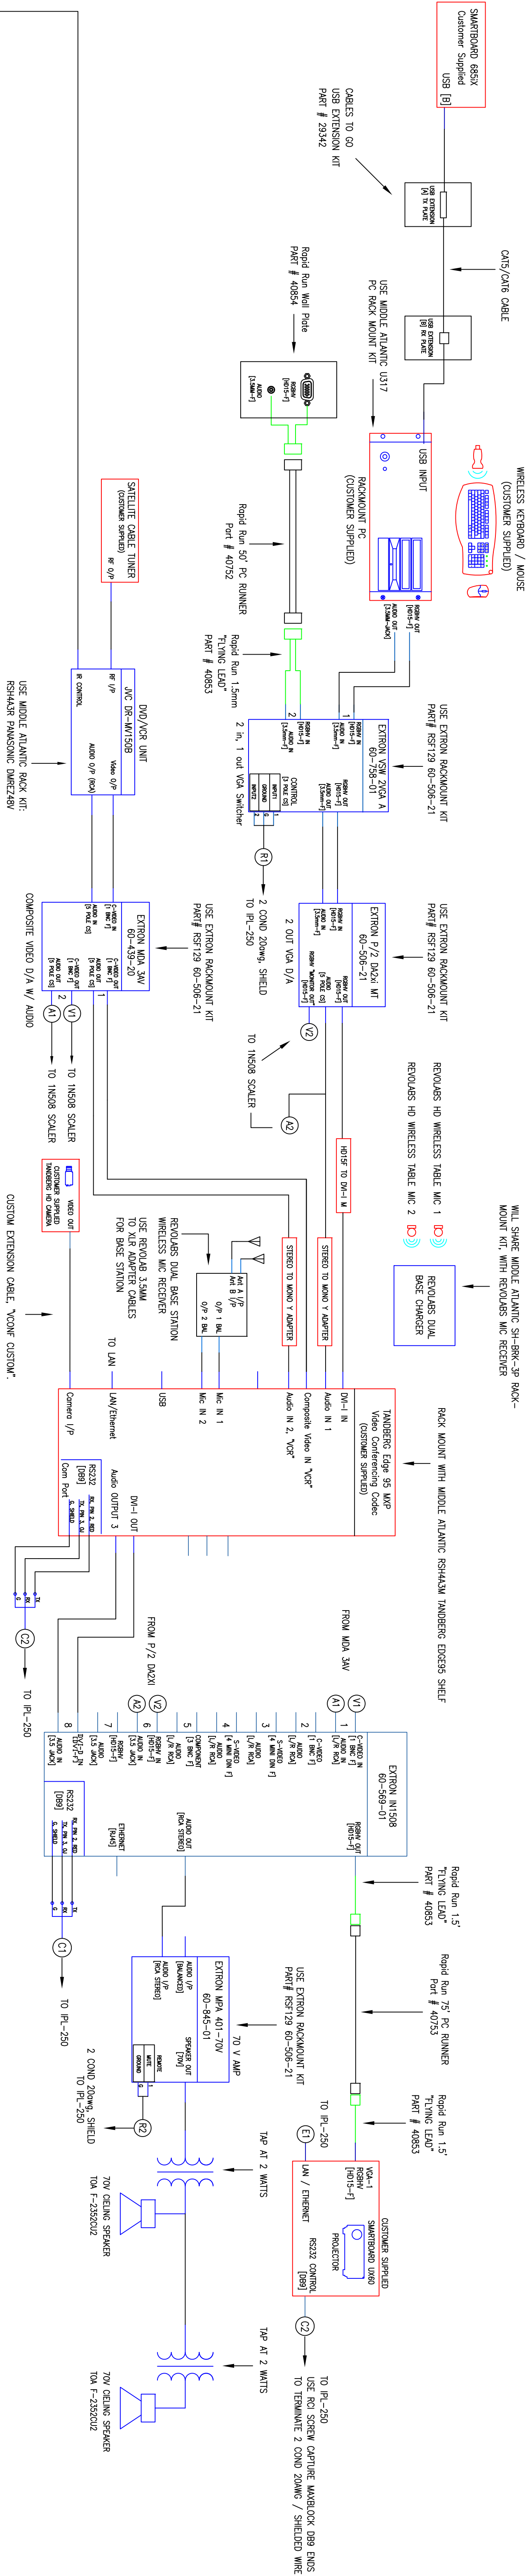

DIRECTOR'S CONFERENCE ROOM 2D-195

AS-BUILT DRAWING

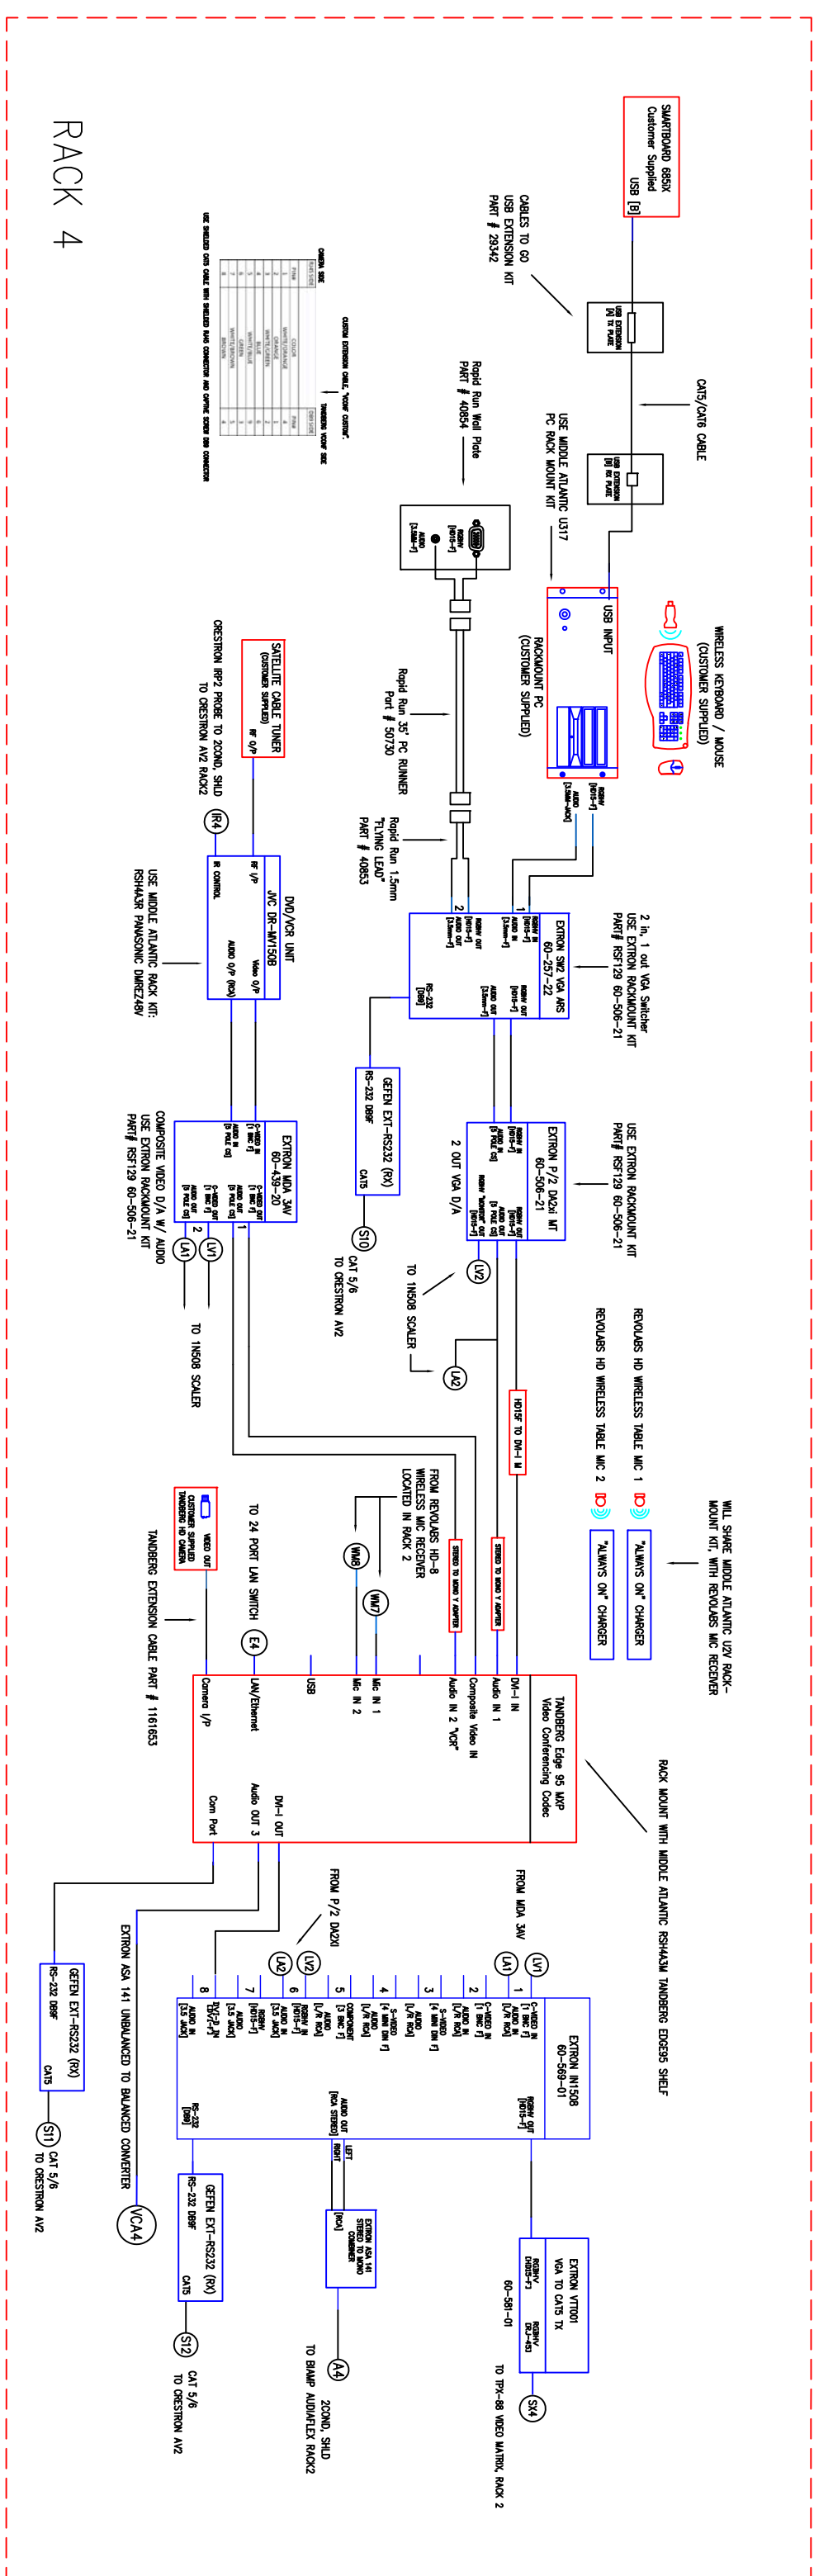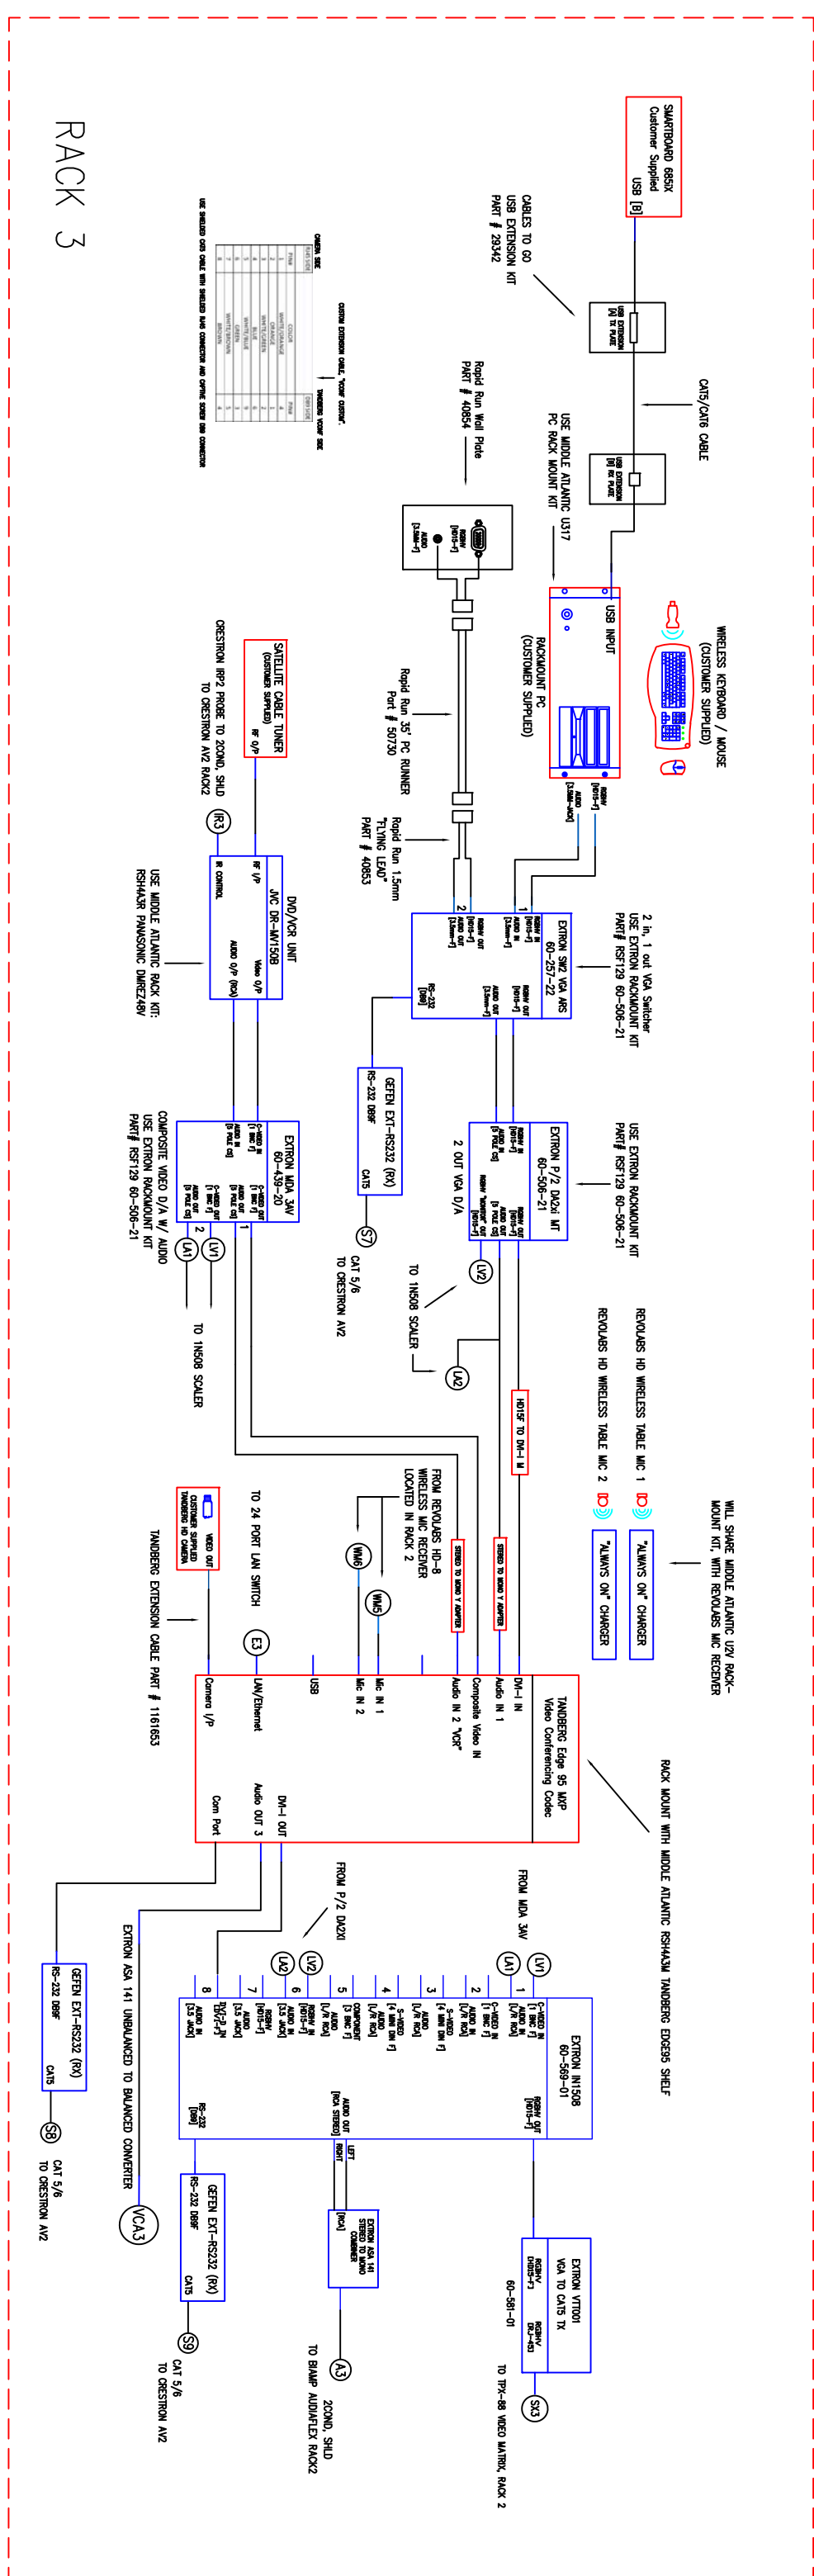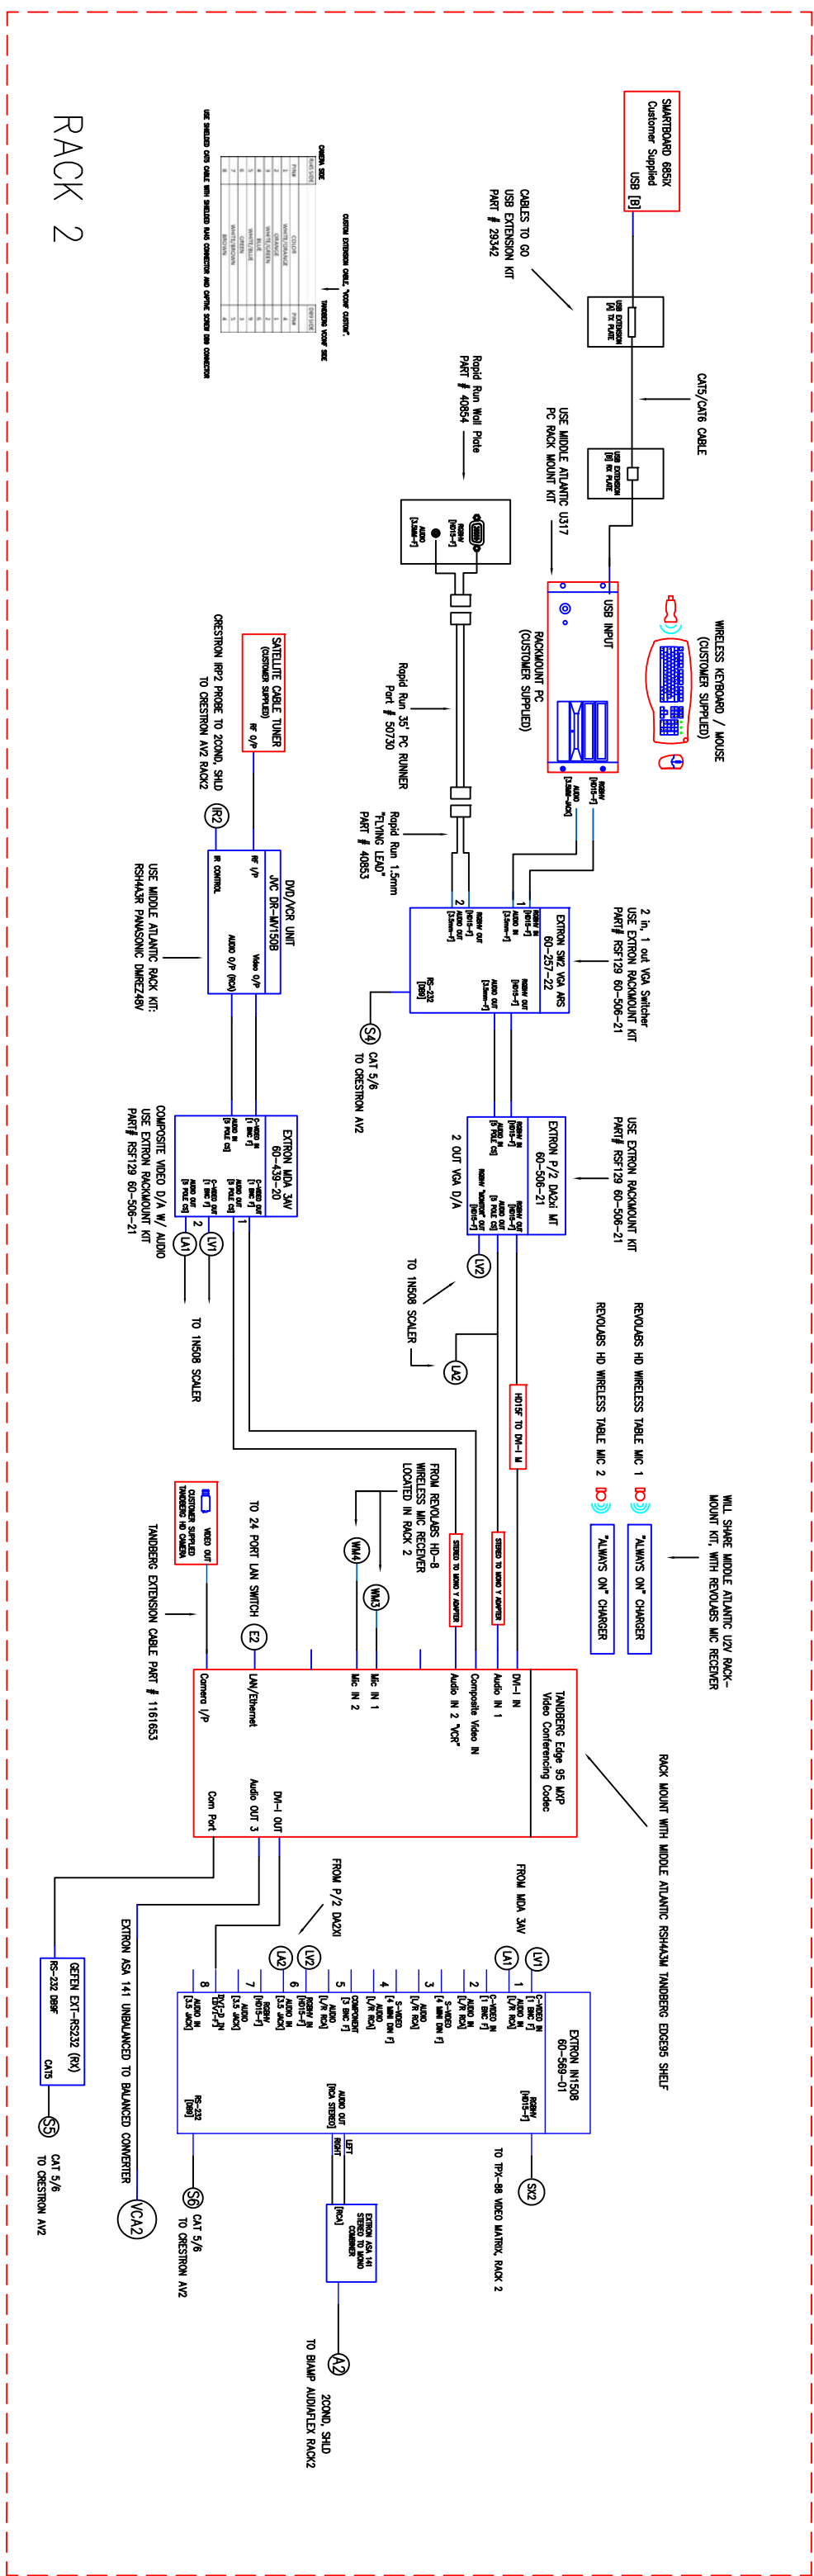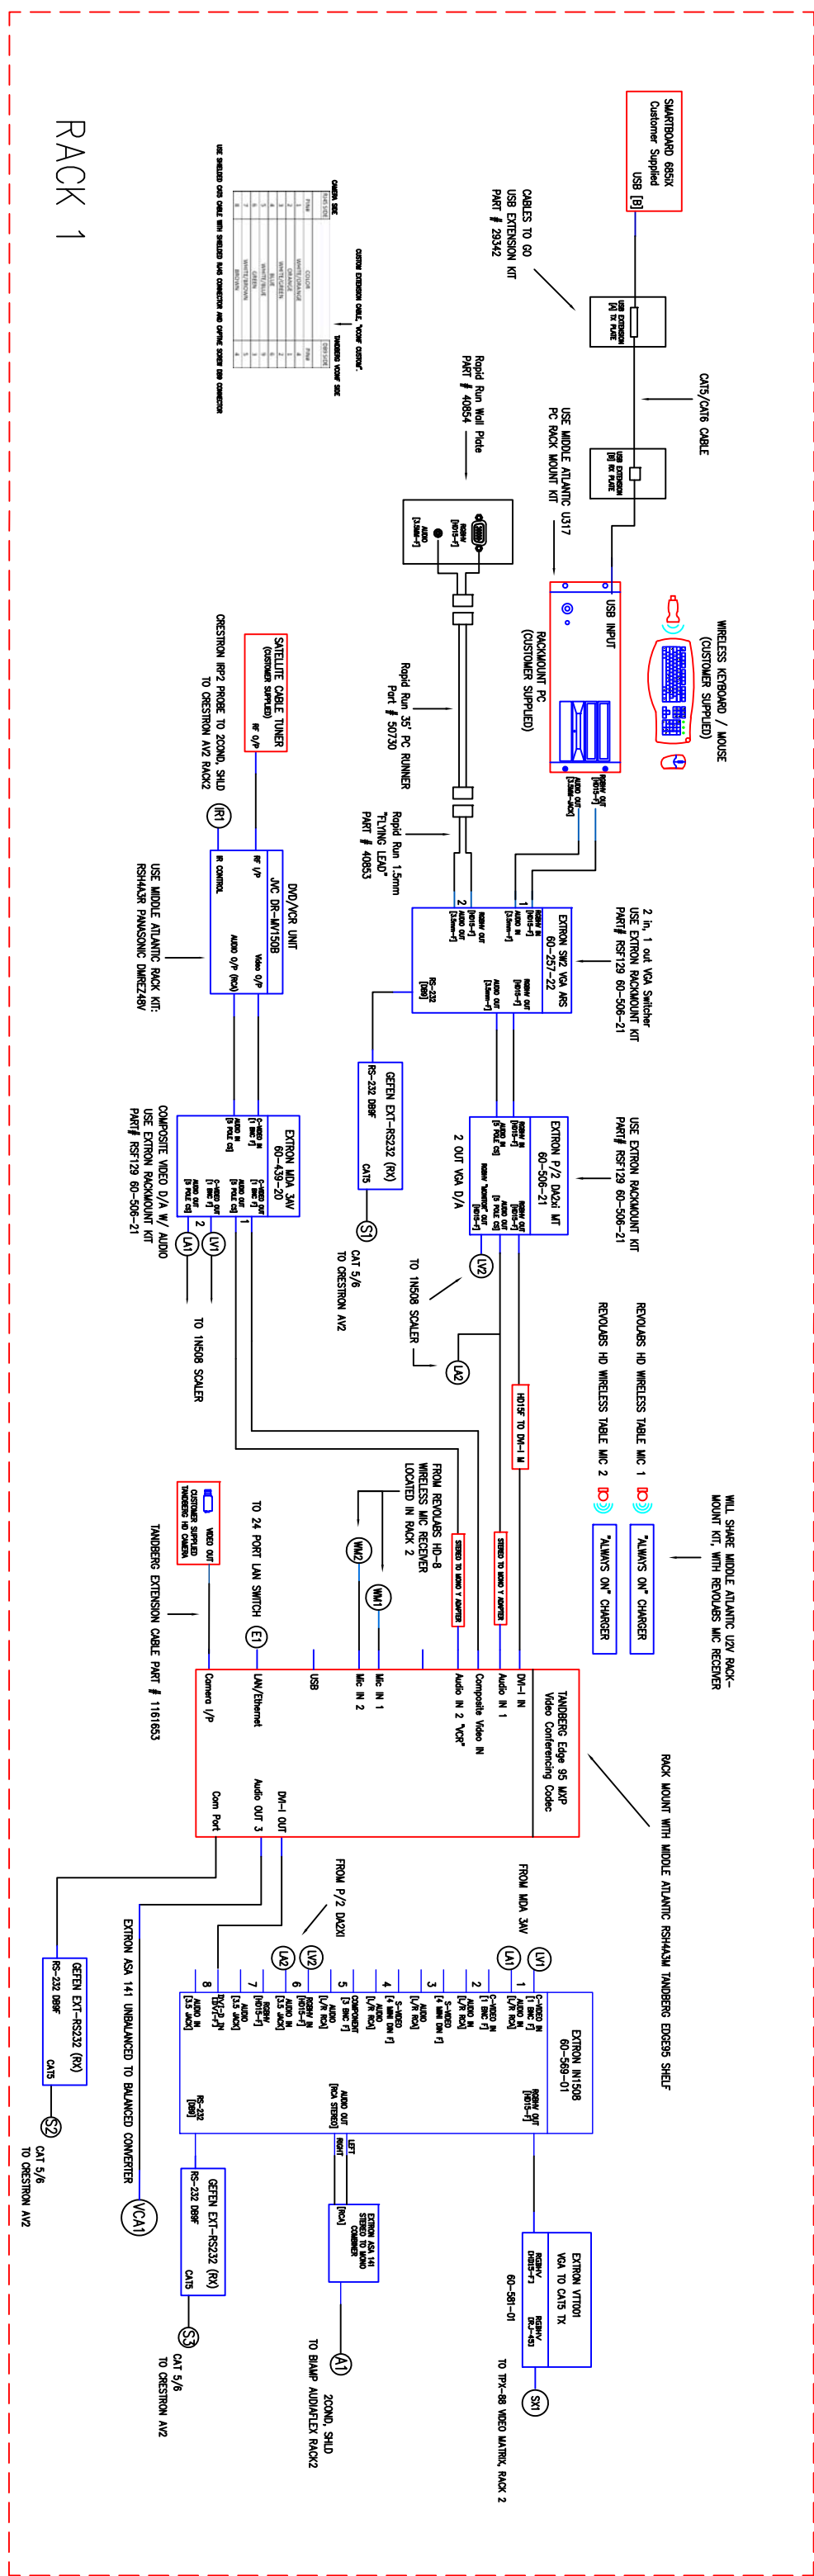

AS-BUILT DRAWING


LOCAL A/V SYSTEMS. ROOMS 2D-101, 2D-105, 2D-107, 2D-111

		<u>CONTRACTOR/INSTALLER</u>	
		MEGA WATT ELECTRIC	
		ANCHORAGE, ALASKA	
		<u>AS-BUILT DRAWING</u>	
#		REVISION DESCRIPTION	APPR.

ATS
ALASKA

139 EAST 51st. AVE. SUITE 100
ANCHORAGE, AK 99503

SAB
907.868.5100 TEL
907.868.5123 FAX

 NATIONAL INSTITUTE FOR CERTIFICATION
IN ENGINEERING TECHNOLOGIES
CERTIFIED TECHNICIANS

D.P.S.:	NOT TO SCALE
DRAWN BY:	SAB
APPROVED BY:	
DATE CREATED:	1/11/2011
REVISED DATE:	08/01/2011
SCALE:	AS SHOWN
JOB NUMBER:	3110571
CAD FILENAME:	3110571 VA AV

VA HOSPITAL AV ANCHORAGE, ALASKA	
PROJECT NAME:	
AREA:	2ND LEVEL
SYSTEM:	AUDIO VIDEO SYSTEM DEVICE LAYOUT

CATEGORY: AV
SHEET NUMBER: AV-08
YEAR: 2010

AS-BUILT DRAWING

SYMBOL LEGEND




SYMBOL	DESCRIPTION	MANUFAC.	PART #	BACKBOX
VP1	AV INPUT WHITE WALLPLATE, VP1-WP4	RAPID RUN	40854	STANDARD 1-G. Requires Leviton White Decora® Plate
CVB3	MEDIA WALLPLATE / AV INPUT / CONTROL UNIT, CVB-CWP2	CRESTRON	IM-WCV-M	3-gang wall plate, mountable in a 2.5 in (63.5 cm) deep electrical box. Noose Cordset must enter box via top or bottom (not side) only.
IM1	MEDIA RECEIVER, IM-1M2	CRESTRON	IM-RV1-M	MOUNTS TO PPA PROJECTOR RILE USING CRESTRON MK-1MK-POLE MOUNT KIT
ANT1	WIRELESS MIC ANTENNA, ANT1-A12	TDA	YW-4500	STANDARD 1-G BACKBOX
VC1	VCON® WIRELESS MIC ANTENNA "VC-ANT1" - "VC-ANT4"	REVOLVAS	REMOTE ANT	1-G WALLPLATE V/ CHASSIS MOUNT P-F BNC
TP1	TOUCH PANEL, REMOTE, TP1-TP4	CRESTRON	TPNC-4SM	STANDARD 1-G BACKBOX
S	CEILING SPEAKER, TWP AT 2 WATTS, 70V	TDA	F-2550J2	HORIZONTALLY ORIENTED INCLUDED
USB	USB WALLPLATE, CONVERTS TO CAT5/6	CABLES TO GO	29342	STANDARD 1-G PLATE NOT INCLUDED
SP1	SMART BOARD PROJECTOR, SP1-SP4	SMART	UX60	
P1	PROJECTOR, 4000 LUMENS, P1-P4	HITCHHI	CP-W40C5	MOUNT WITH REVERSE "HMK" ADJUSTABLE PROJECTOR MOUNT.
RACK1	WALL MOUNT METAL RACK, 218U	MIDDLE ATLANTIC	DWR-1B-22	INCLUDED
RACK2	WALL MOUNT METAL RACK, 218U RACK 2 (DLX1)	MIDDLE ATLANTIC	DWR-25-22	INCLUDED
SMARTBOARD 685X	SMARTBOARD 685X	SMART	685X1	
ELITE SCREEN 1 & 2	110" SHADOW, VIRE SCREEN W/ ELECTRIC MOTOR	ELITE	VMA1000V42E	

WIRE / CABLE SCHEDULE

ATS TYPE	DESCRIPTION	MANUFAC.	PART #
'A'	35' PC RUNNER, PLENUM	RAPID RUN	50730
'B'	50' PC RUNNER, PLENUM	RAPID RUN	40752
'C'	75' PC RUNNER, PLENUM	RAPID RUN	40753
'D'	CATS OR CAT6 PLENUM		
'E'	CAMERA EXTENSION CABLE	TANDBERG	1161653
'F'	18 awg 2 COND PLENUM	WESTPENN	252248
'G'	20 awg 2 COND SHIELDED PLENUM	WESTPENN	252928B
'H'	UTP-P/1000 SKEW FREE VIDEO CAT5	EXTIRON	22-142-03
'I'	500' SPDDL MEDIA, PLENUM	CRESTRON	IM-P-DRN-SP500
'J'	16 awg 2 COND PLENUM	WESTPENN	252258
'K'	RG6 PLENUM		

- △ PROVIDE 120VAC TO ALL PROJECTORS, SMARTBOARDS, RACKS, AND NEW SCREENS
- △ FIELD COORDINATE LOCATIONS OF ALL FIELD DEVICES WITH ELECTRICAL

PLEASE LABEL ALL WIRES AS SPECIFIED

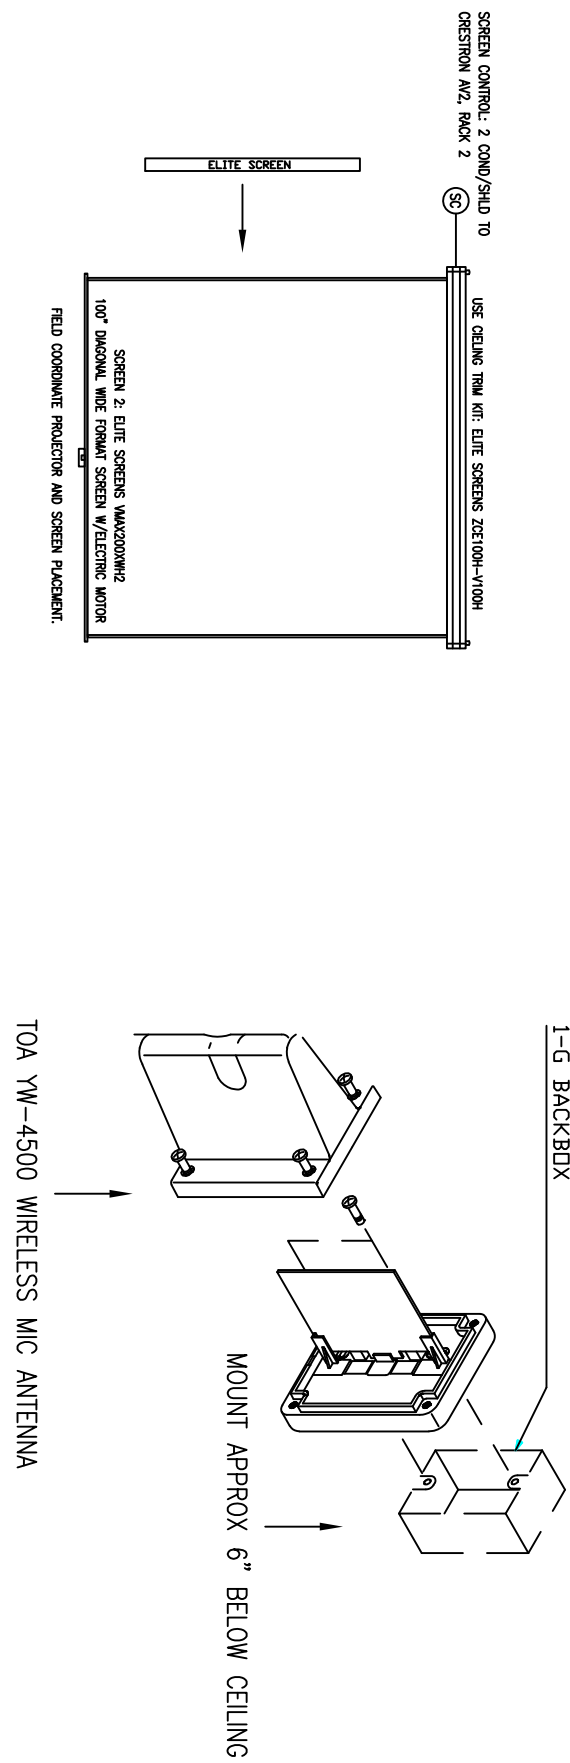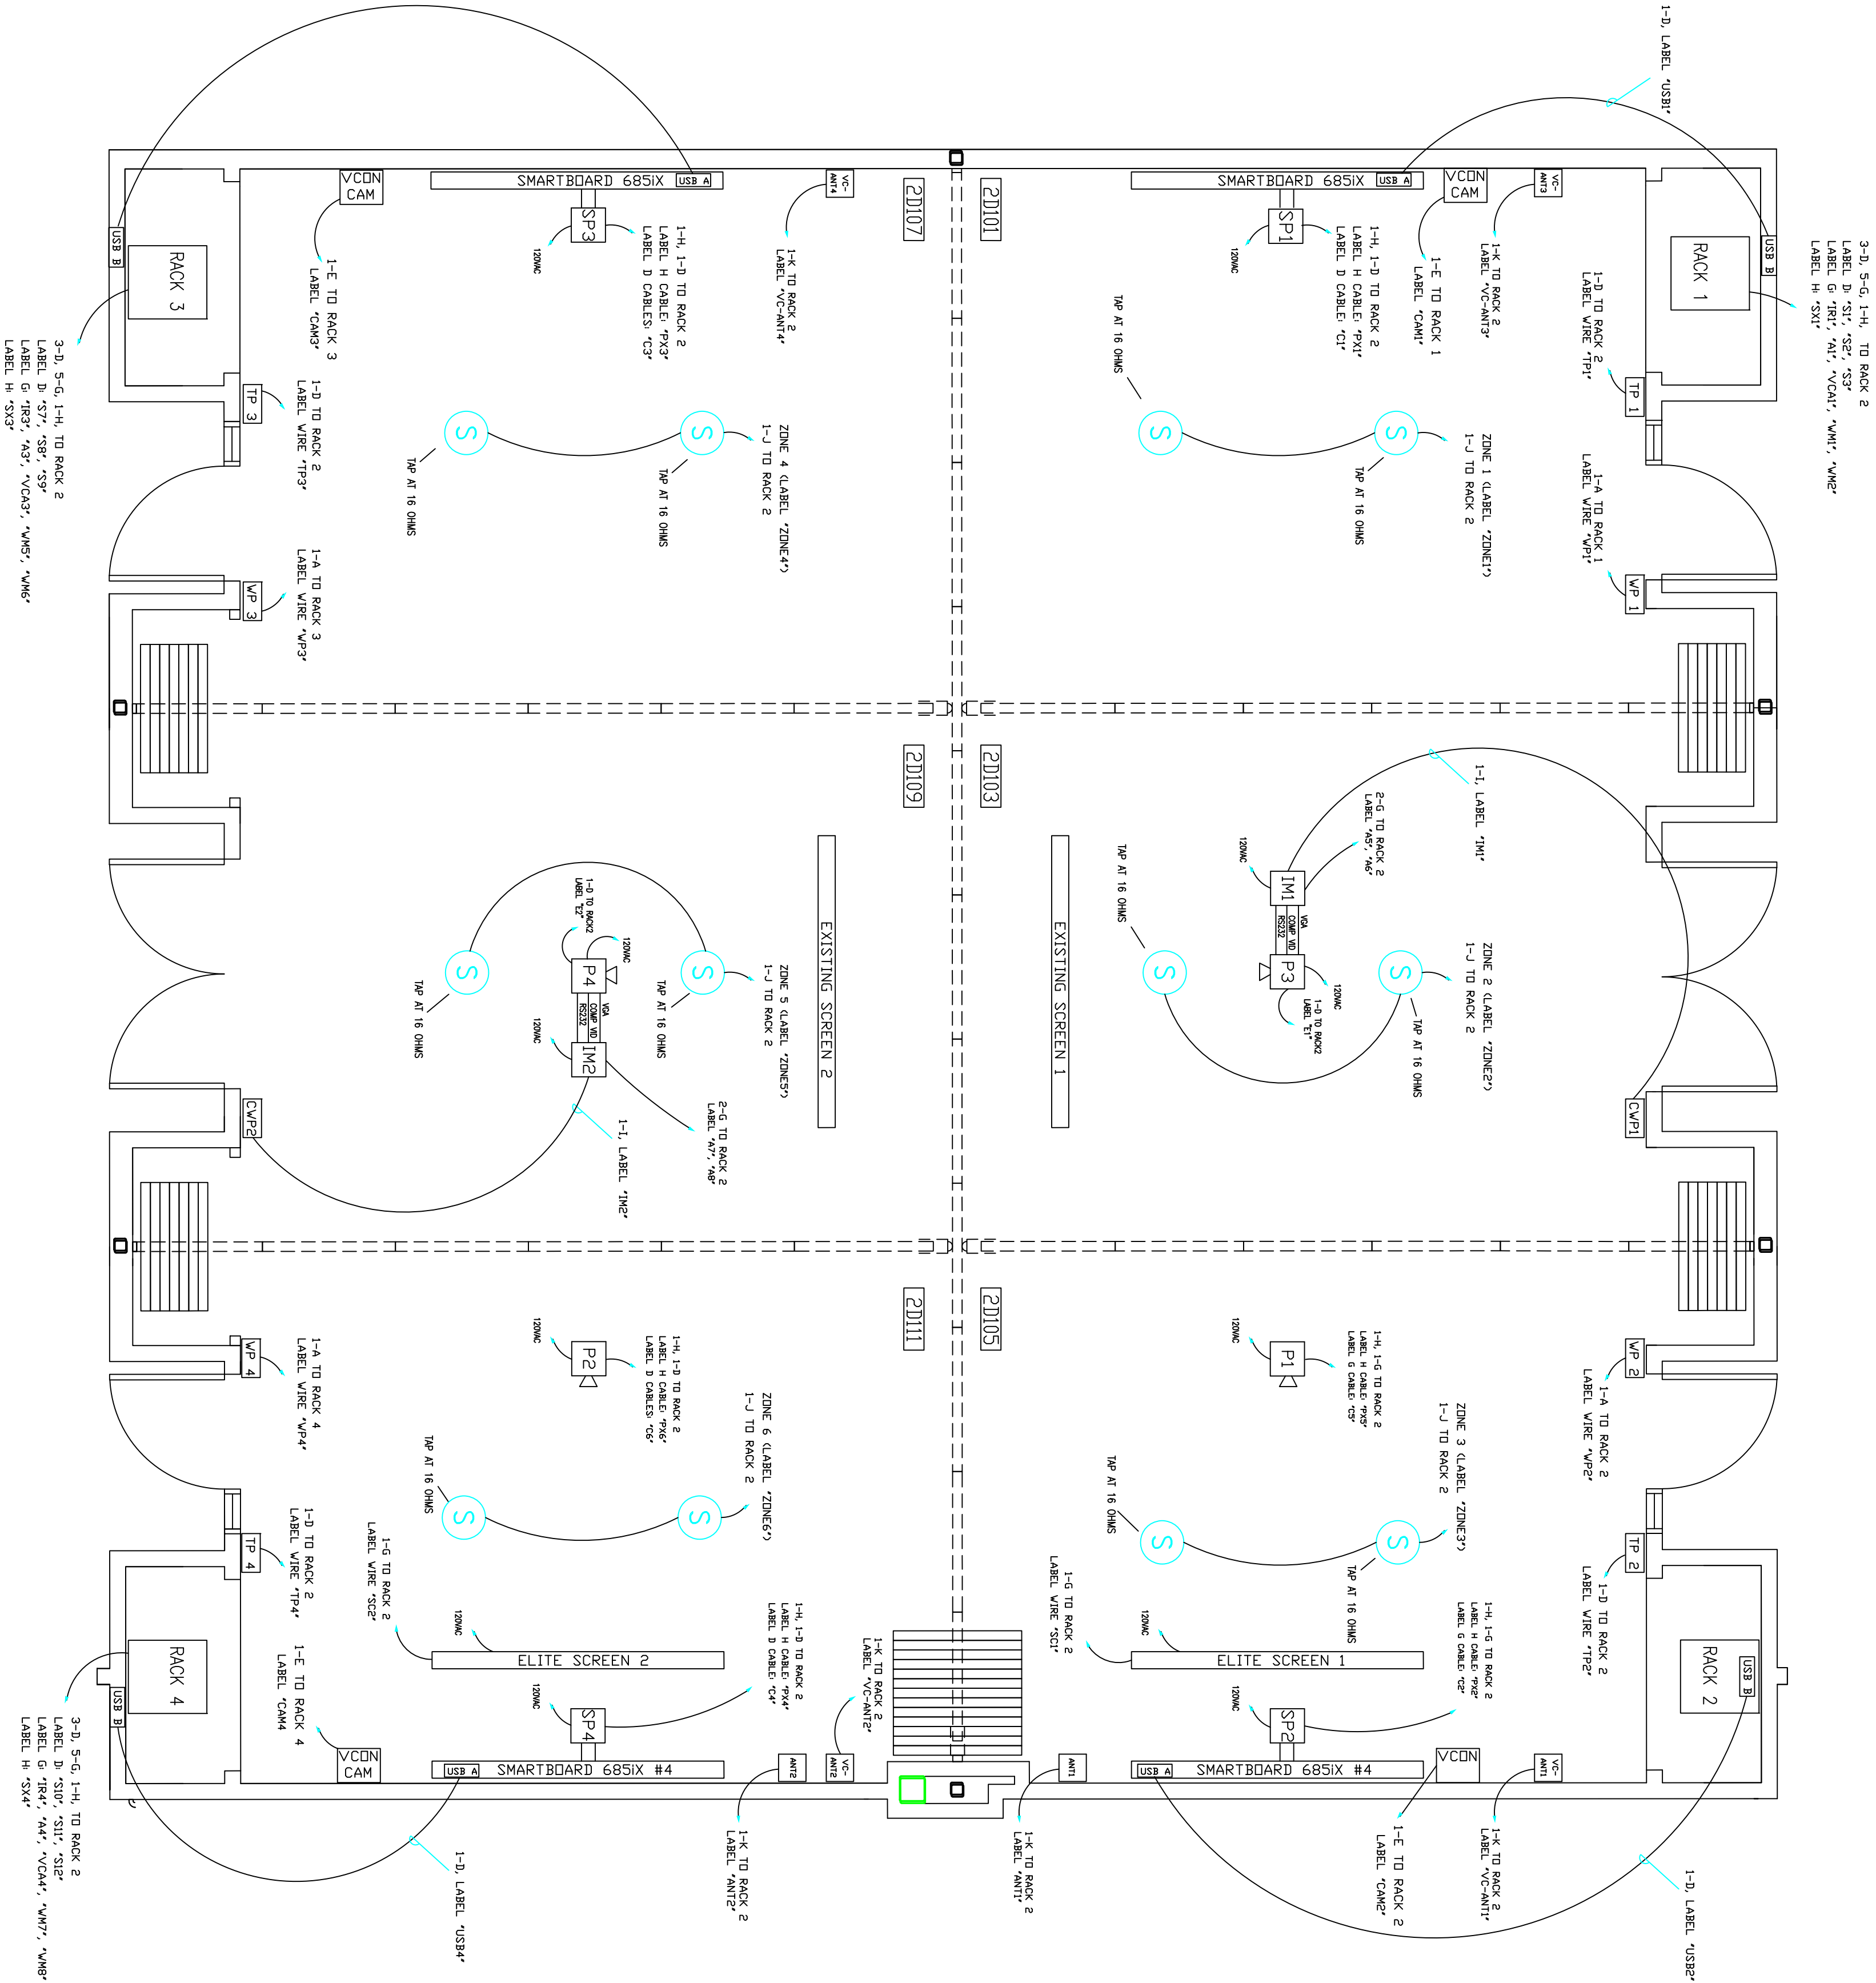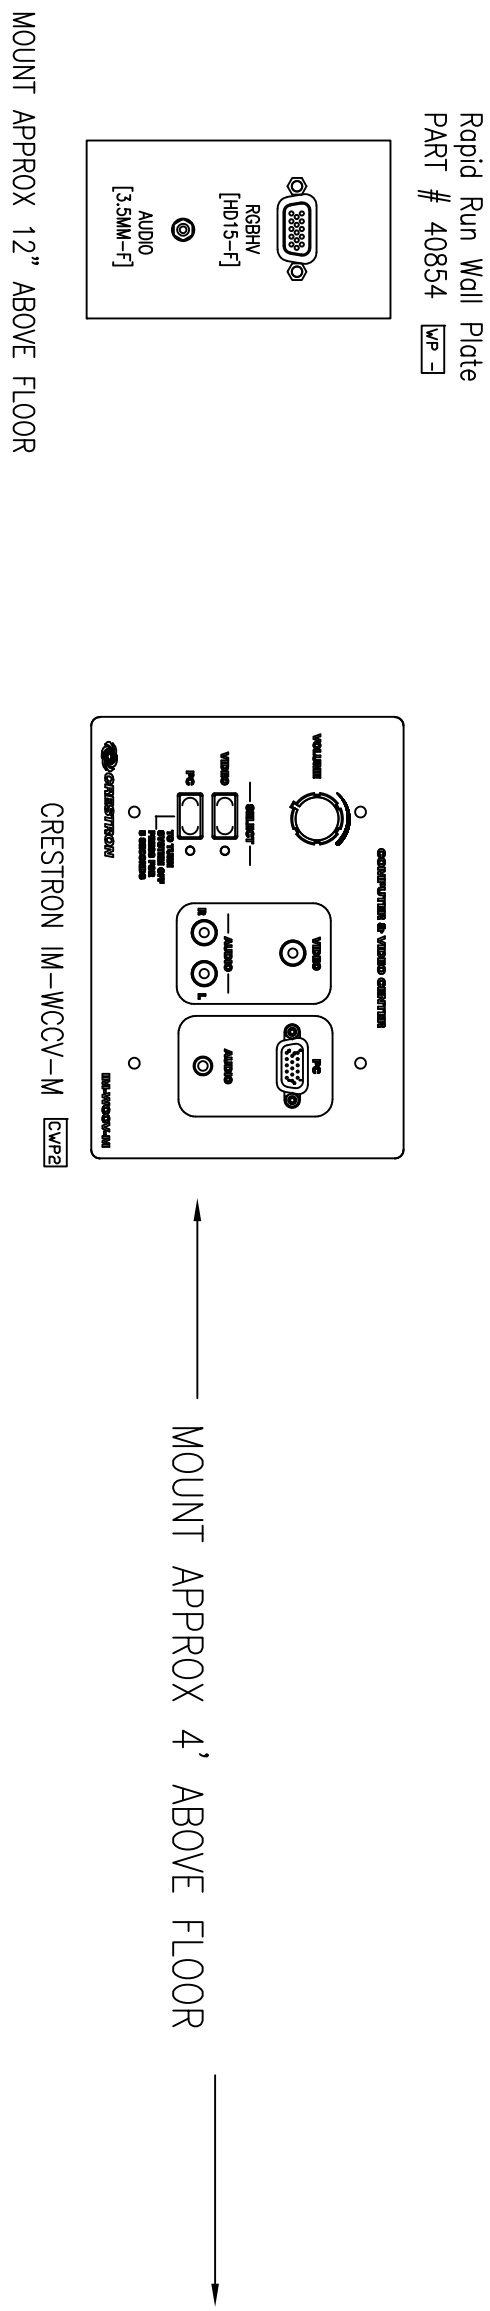

6 ROOM COMBINE SYSTEM, ROOMS 2D-101, 2D-103, 2D-105, 2D-107, 2D-109, 2D-111

