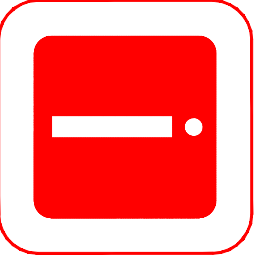
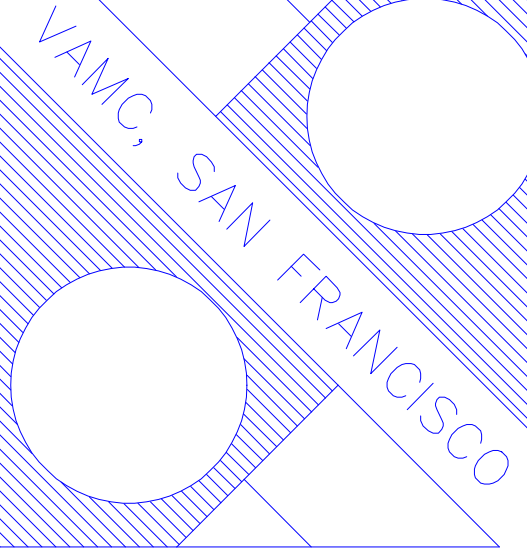


Revisions		Date		Professional Seal		<div><div><div>Indus Systems, Inc. 2352, Main Street, Concord MA 01742 Tel: 978-461-0565 www.indus-systems.com</div></div></div>		Drawing Title BASEMENT FLOOR PLAN ARCHITECTURAL		Project Title AS-BUILT Drawings		Date 04-16-2009 Project No.	
Approved:		Building Number 205		Checked		Drawn		Approved:		Location VAMC, SAN FRANCISCO		Drawing No.	
VA FORM 05-623, OCT 1978								<div><div><div>VAMC, SAN FRANCISCO</div></div></div>		<div><div><div>Department of Veterans Affairs</div></div></div>			