



- KEYNOTES: (KEYNOTES REFERENCE THIS SHEET ONLY)
1. EXISTING SUSPENDED CEILING SYSTEM AND ACOUSTICAL PANELS TO REMAIN.
  2. EXISTING G.W.B. CEILING TO REMAIN
  3. 2'X2' ACOUSTICAL PANELS AND SUSPENDED CEILING SYSTEM
  4. NO WORK THIS ROOM - EXISTING CEILING, HVAC, DIFFUSERS, HVAC RETURN GRILLES, LIGHTS AND OTHER CEILING RELATED ITEMS TO REMAIN

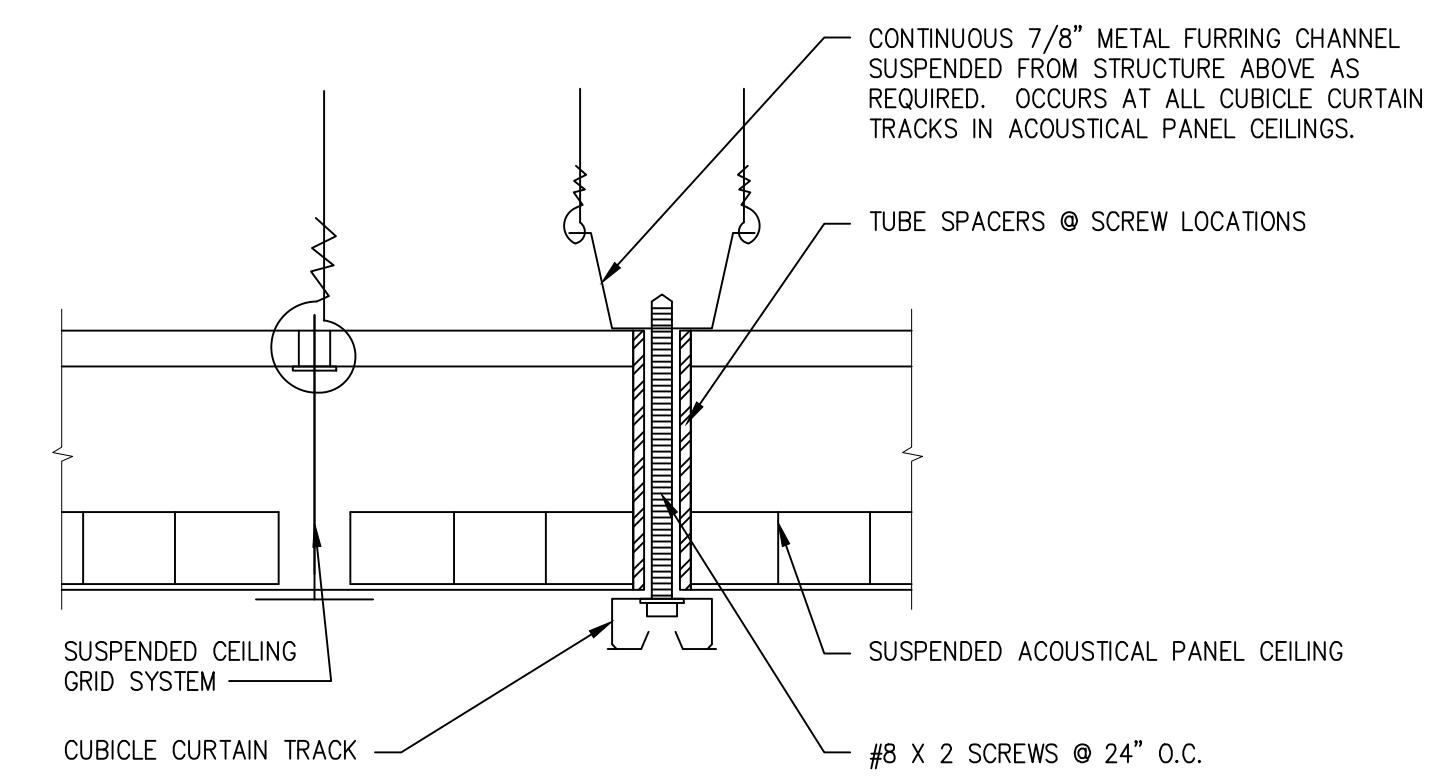


**CUBICLE CURTAIN TRACK DETAIL** 2  
SCALE: 1" = 1'-0" A2.0 A2.0

- LIGHT FIXTURE LEGEND:**
- EXISTING 2X4 FLUORESCENT LIGHT FIXTURE TO REMAIN, SEE ELECTRICAL DRAWINGS FOR TYPE
  - EXISTING 2X2 DIFFUSER TO REMAIN, SEE ELECTRICAL DRAWINGS FOR TYPE
  - EXISTING 2X2 RETURN AIR GRILLE TO REMAIN, SEE ELECTRICAL DRAWINGS FOR TYPE
  - EXISTING ACOUSTICAL CEILING PANELS AND SUSPENSION SYSTEM TO REMAIN
  - ACOUSTICAL CEILING PANELS AND SUSPENSION SYSTEM
  - 2X4 FLUORESCENT LIGHT FIXTURE, SEE ELECTRICAL DRAWINGS FOR TYPE
  - LIGHT FIXTURE, SEE ELECTRICAL DRAWINGS
  - 2X2 DIFFUSER, SEE ELECTRICAL DRAWINGS FOR TYPE
  - 2X2 RETURN AIR GRILLE, SEE ELECTRICAL DRAWINGS FOR TYPE
  - 12"X12" DIFFUSER, SEE ELECTRICAL DRAWINGS FOR TYPE
  - 12"X12" RETURN AIR GRILLE, SEE ELECTRICAL DRAWINGS FOR TYPE
  - 8'-0" A.F.F. CEILING HEIGHT REFERENCE TAG

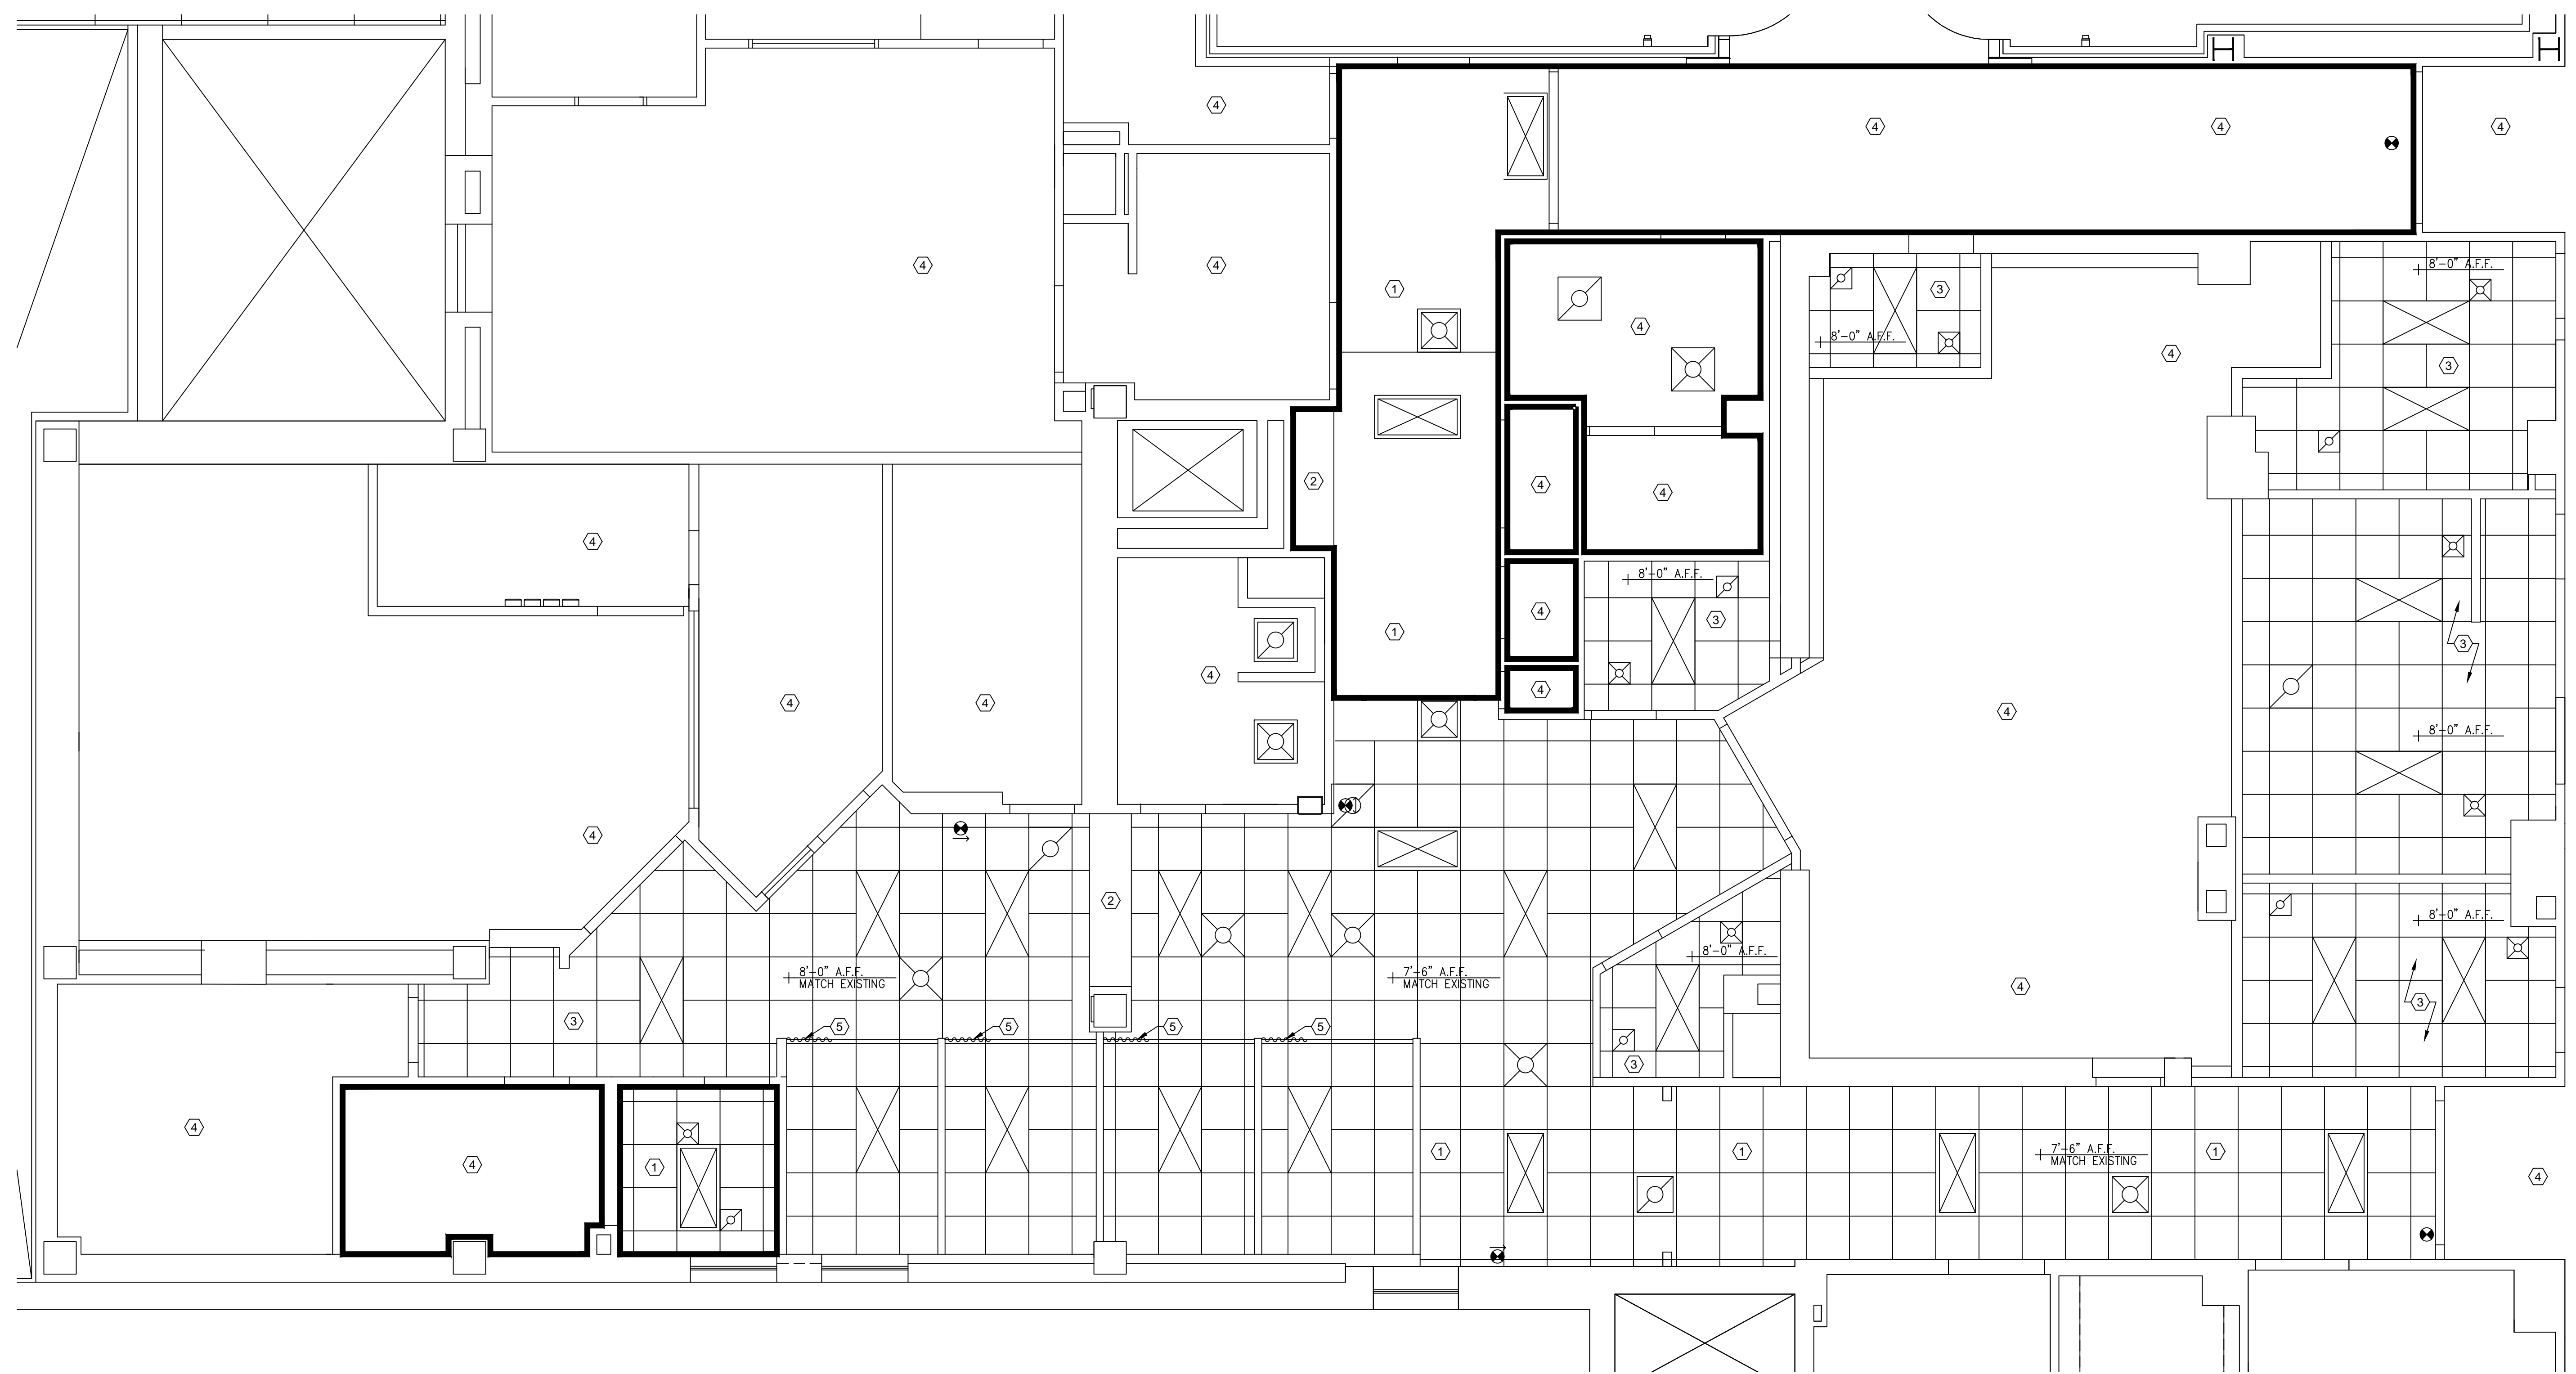

**REFLECTED CEILING PLAN** 1  
GRAPHIC SCALE SUPERSEDES NUMERIC SCALE  
0 2' 4' 8'  
SCALE: 1/4" = 1'-0" A2.0 A2.0

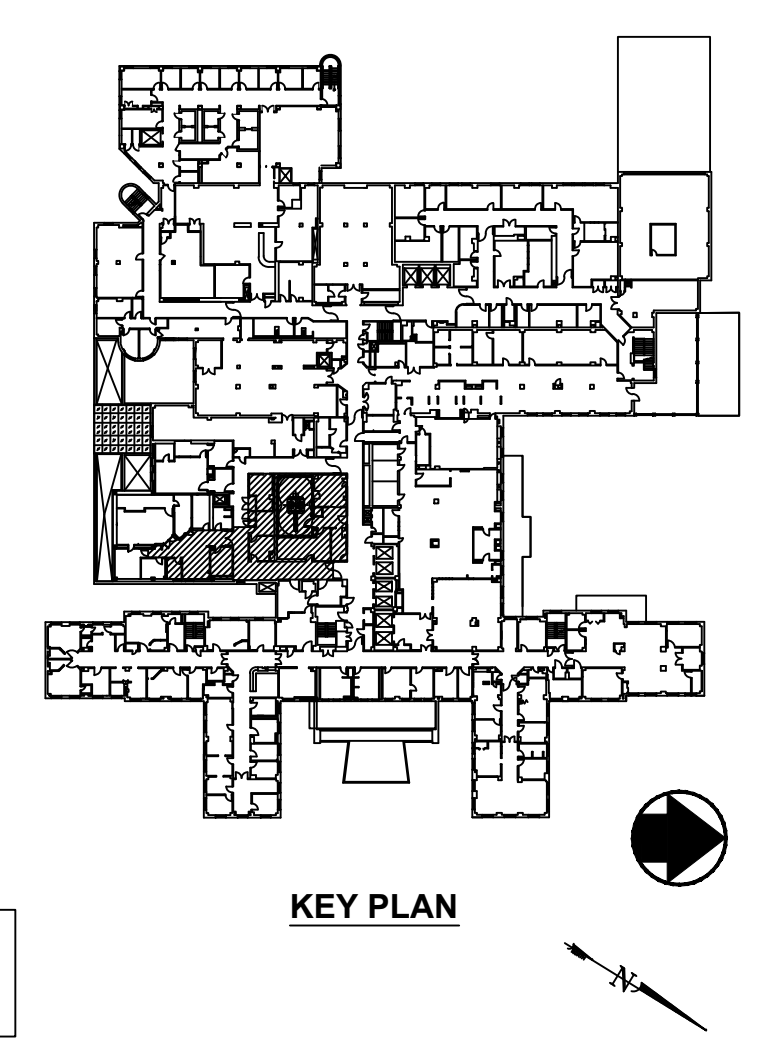

**RECORD DRAWINGS T-659**

**PARADIGM**  
ENGINEERS AND CONSTRUCTORS  
PO BOX 498223  
Louisville, Kentucky 40253  
502-338-8511 [www.paradigmusa.com](http://www.paradigmusa.com)

CARDIAC CATH LAB  
SITE PREPARATION  
PROJECT: 603-09-704  
VA MEDICAL CENTER  
800 Zinn Ave.  
Louisville, Kentucky 40206

Department of  
Veterans Affairs

DATE	
REVISIONS	
1	
2	
3	
4	
5	
6	
7	
8	
9	
10	

COMM. NO.	
MADE BY	JEM
CHECKED	HB
DATE	05-21-12
REFLECTED CEILING PLAN	
DRAWING NO.	A2.0
BD FIG.	