



**GENERAL NOTE:**

ALL EXISTING PIPING, DUCTWORK, SPRINKLERS, CONDUIT, LIGHTING OR OTHER CONSTRUCTION SHALL BE RELOCATED AS NECESSARY FOR ALL DEMOLITION AND INSTALLATION WORK.

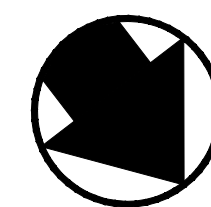

**2ND FLOOR MECHANICAL DEMOLITION  
HVAC**

GRAPHIC SCALE SUPERSEDES NUMERIC SCALE  
0 2 4 8  
SCALE: 1/4" = 1'-0"

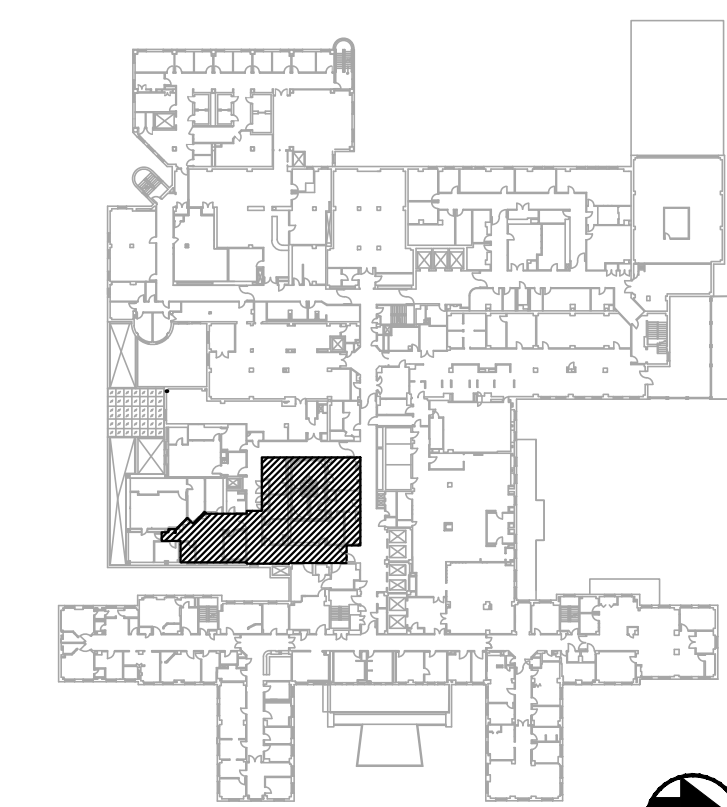

KEY PLAN

**RECORD DRAWINGS T-659**

**PARADIGM**  
ENGINEERS AND CONSTRUCTORS  
PO BOX 498223  
Louisville, Kentucky 40253  
502-839-8611 www.paradigmusa.com

CARDIAC CATH LAB  
SITE PREPARATION  
PROJECT: 603-09-704  
VA MEDICAL CENTER  
800 Zorn Ave.  
Louisville, Kentucky 40206



DATE	REVISIONS

COMM. NO.	
MADE BY <b>JEM</b>	CHECKED <b>HB</b>
DATE <b>05-21-12</b>	
<b>MECHANICAL DEMOLITION</b>	
DRAWING NO. <b>M1.0</b>	SHEET NO. 