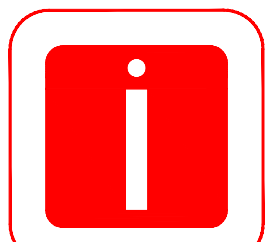
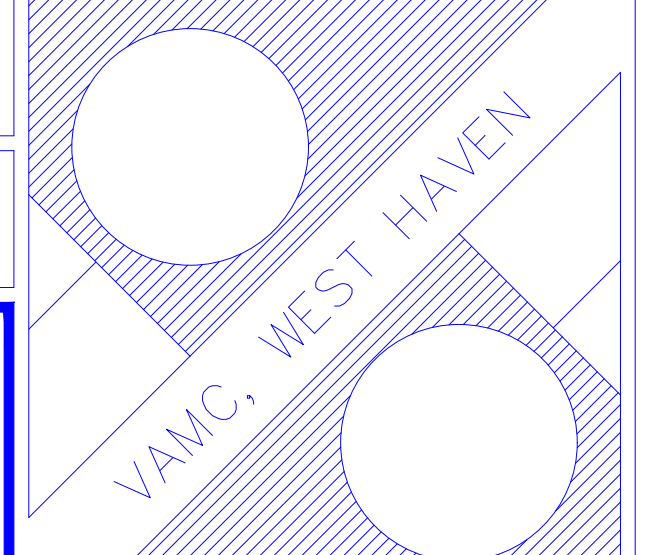


three inches = one foot
 one and one half inches = one foot
 one inch = one foot
 three quarters inch = one foot
 one half inch = one foot
 three eighths inch = one foot
 one quarter inch = one foot
 one eighth inch = one foot

Revisions Date Professional Seal	 Indus Systems, Inc 2352, Main Street, Concord MA 01742 Tel: 978-461-0555 www.indus-systems.com		Drawing Title GROUND FLOOR PLAN ARCHITECTURAL		Project Title AS-BUILT Drawings		Date 10-19-2017 Project No		 VAMC WEST HAVEN VA Department of Veterans Affairs
	Approved:		Approved:		Building Number 01	Checked Drawn	Drawing No	Location WEST HAVEN, CT 06516	