


three inches = one foot  
one and one half inches = one foot  
one inch = one foot  
three quarters inch = one foot  
one half inch = one foot  
three eighths inch = one foot  
one quarter inch = one foot  
one eighth inch = one foot

ASBUILT

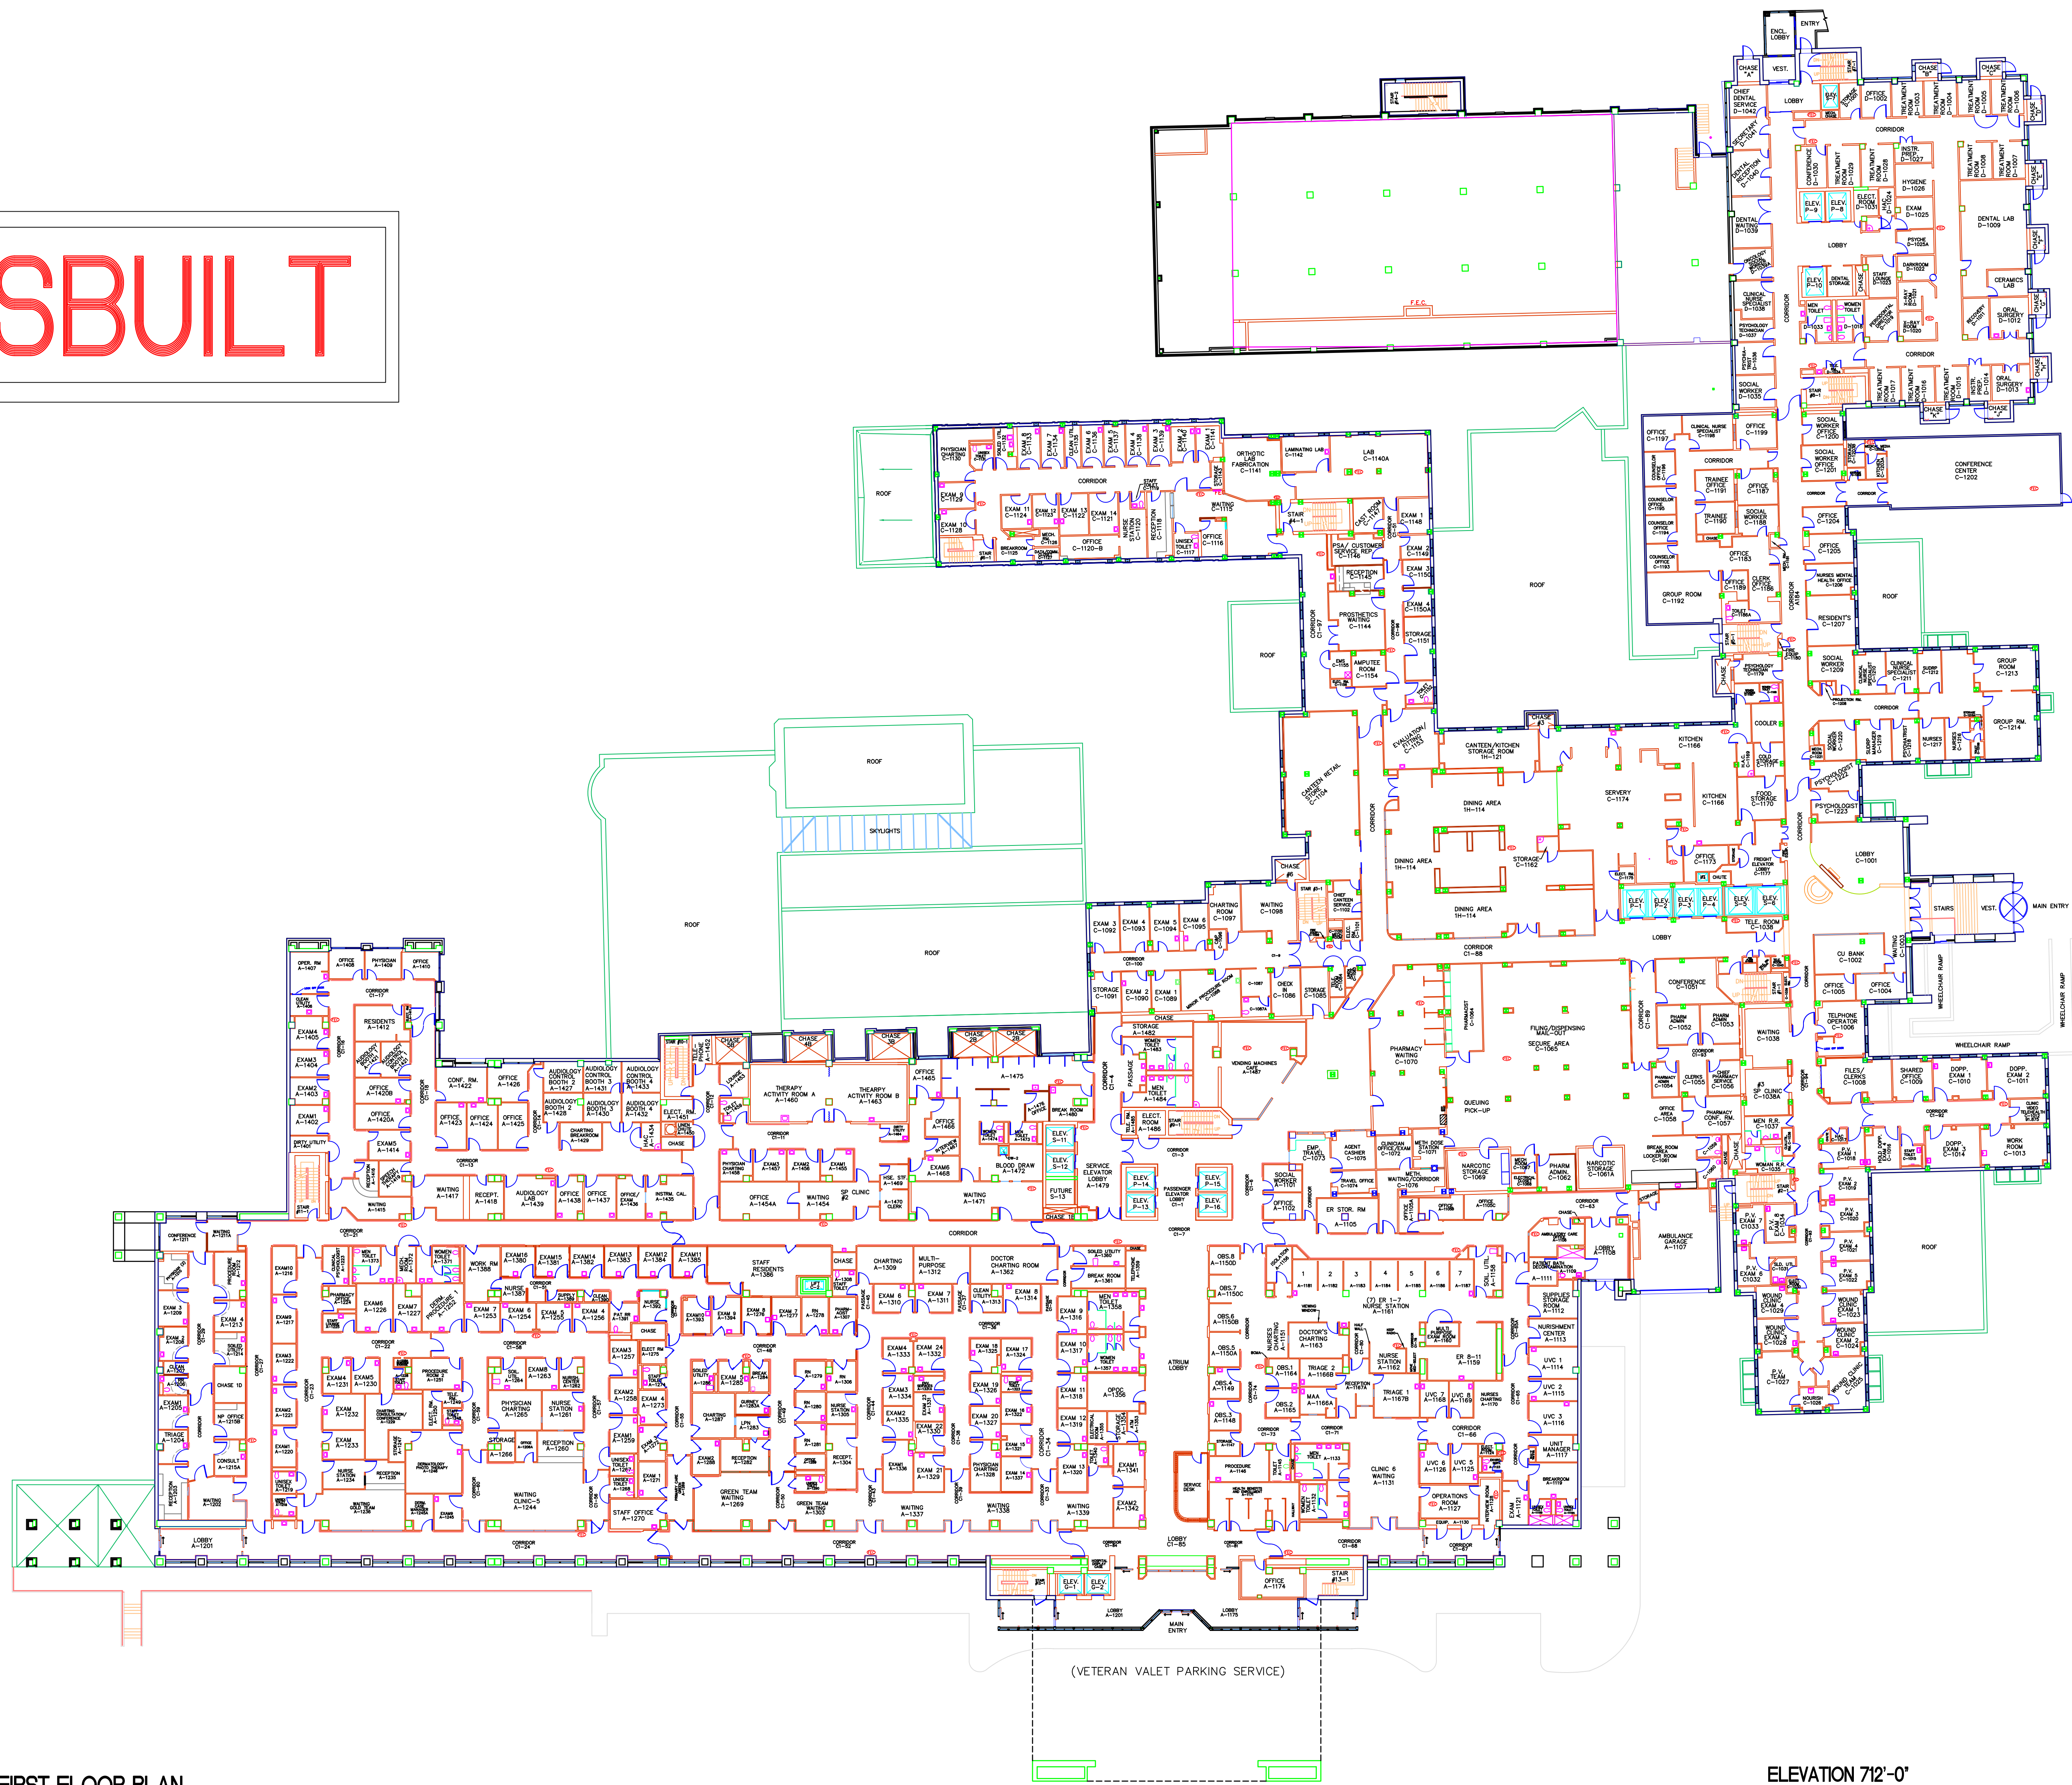

1 FIRST FLOOR PLAN  
SCALE: 1" = 25'

ELEVATION 712'-0"

DRAWING ORIGINATED ON 4-1-2002


UPDATED FEB 2019

EXTERNAL GROSS: 149778.843 SQ. FT.

Revisions:	Date
2 REVISED/ UPDATED FIRE EXTINGUISHER LOCATIONS	8/15/2011
3 REVISED FLOOR PLAN TO ACCOMMODATE RENOV. NEW WALLS & DOORS.	8/30/2011
3 REVISED FLOOR PLAN TO ACCOMMODATE RENOV. NEW WALLS & DOORS.	10/24/2012
4 REVISED FLOOR PLAN TO ACCOMMODATE ALL RENOV.	11/09/2015
5 REVISED UPDATE TO 2016	6/23/2016
6 REVISED ER AREA SUITE WITH SEVERAL ROOMS	11/04/2016
7 REVISED UPDATE TO END OF 2018	08/17/18

<b>PLOT DATE:</b>
PLOT DATE:
<b>CAD DRAWING FILE LOCATION:</b>
S:\As-Built Drawings\WTS_Campus\Building #1_Main Hospital\Building#1_As-Built Drawings

<b>ADDRESS:</b>
Richard L. Roudebush VA Medical Center 1481 W. 10th St. Indianapolis, Indiana 46202

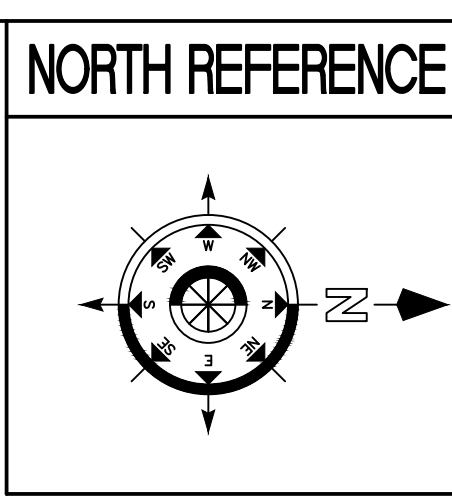

<b>PROJECT ENGINEERS:</b>
CHIEF OF ENGINEERING: SCOTT L. MORITZ

<b>DRAWN BY:</b>
A. FERNANDEZ

<b>Drawing Title</b>
FIRST FLOOR PLAN
<b>Approved Project Director</b>

<b>Project Title</b>
FIRST FLOOR
<b>Location</b>
WEST TENTH STREET
<b>Date</b>
24 OCT 2012
<b>Checked</b>
<b>Drawn</b>
AF

<b>Project Number</b>
-
<b>Building Number</b>
BUILDING #1
<b>Drawing Number</b>
A-103
<b>Dwg. 3 of 13</b>

