


0 1 2 3 4 5 6 7 8 9
A
three inches = one foot
0 1 2 3 4 5 6 7 8 9
B
One and one-half inches = one foot
0 1 2 3 4 5 6 7 8 9
C
one inch = one foot
0 1 2 3 4 5 6 7 8 9
D
three-quarters inch = one foot
0 1 2 3 4 5 6 7 8 9
E
one-half inch = one foot
0 1 2 3 4 5 6 7 8 9
F
three-eighth inch = one foot
0 1 2 3 4 5 6 7 8 9
G
one-quarter inch = one foot
0 1 2 3 4 5 6 7 8 9
H
one-eighth inch = one foot
0 1 2 3 4 5 6 7 8 9

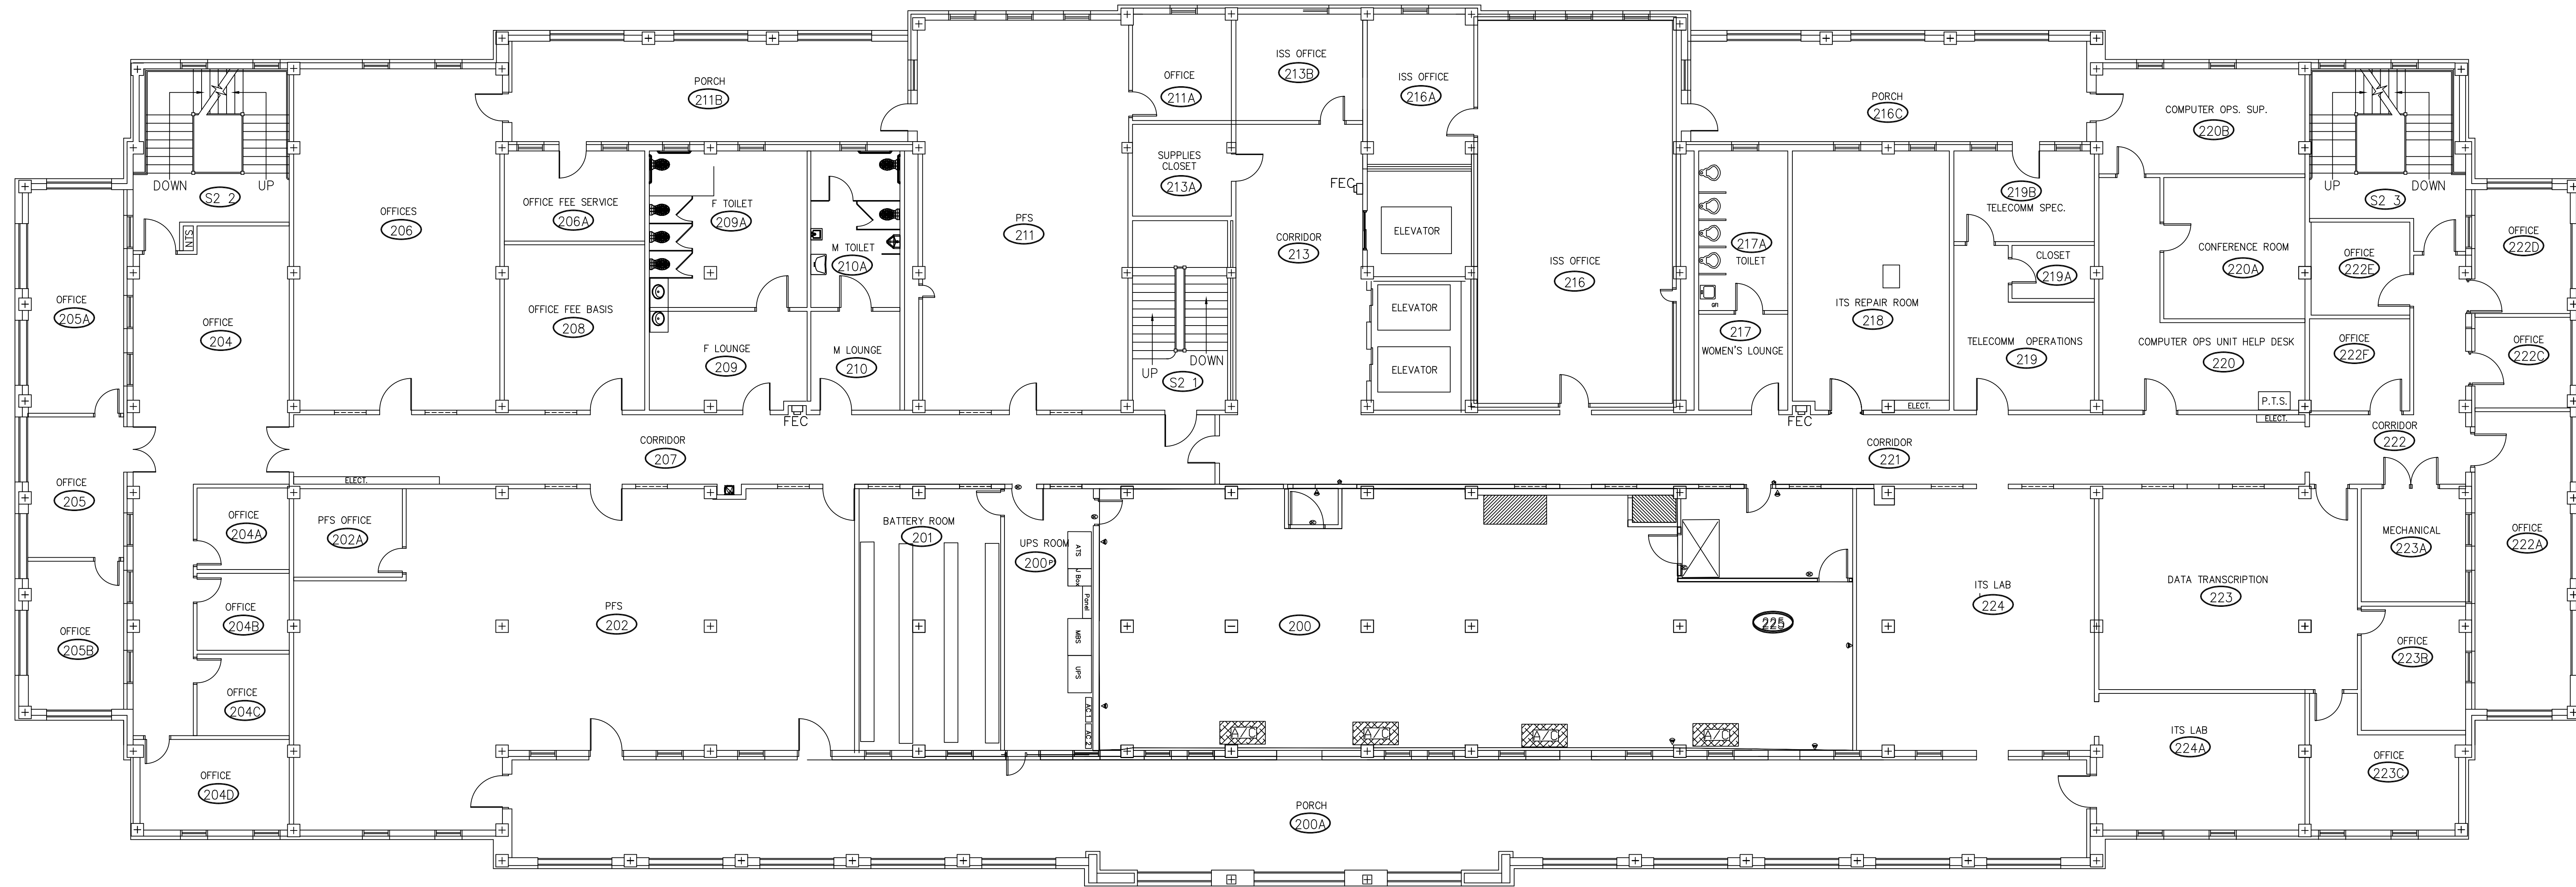

Revisions	Date

Drawing Title SECOND FLOOR PLAN SCALE: 1/8" = 1'-0" Approved: Division Chief	Project Title UPDATE AS-BUILTS Building Number 2 Checked MAKI Drawn MAKI	Date 7-22-04 Project No. DRAWING NO. Dwg. 1 Of 1
Approved: Service Director	Location VAMC Bay Pines Bay Pines FL 33504	