


Split rm 326 made 326A, CLM	12/6/06
Revisions	Date

YA FORM 08-6231, DEC 1989

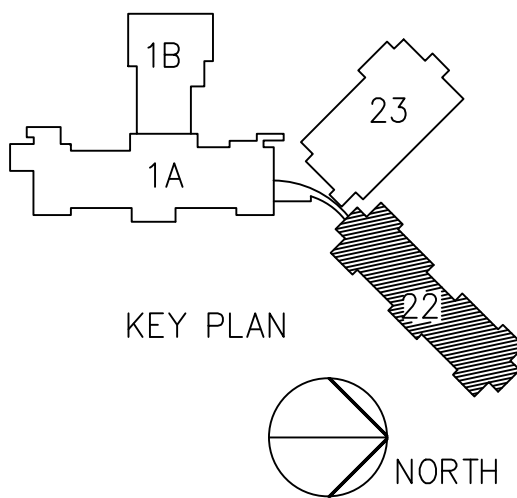

Drawing Title
THIRD FLOOR PLAN

SCALE: 1/8" = 1'-0"

Approved: Division Chief

Approved: Service Director

Project Title
UPDATE AS-BUILTS

Building Number
22

Checked
CLM

Drawn
MAKI


Location VAMC Bay Pines
Bay Pines FL 33504

Date
10-22-96

Project No.
AS-BUILTS

DRAWING NO.
22-11

Dwg. 82 of 284

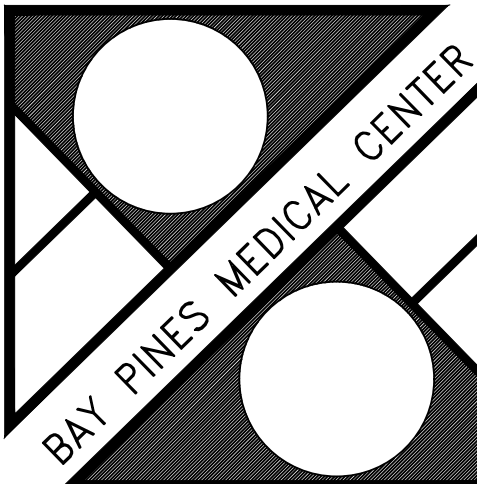

Department of
Veterans Affairs

U.S. GOVERNMENT PRINTING OFFICE: 1985-400-385