


COMPLETE RENOVATION	HANBY	11/1/13
UPDATED TO AS-BUILT	MAKI	6-9-03
Revisions		Date

YA FORM 08-6231, DEC 1989

Drawing Title
FLOOR PLAN
SCALE: 1/8" = 1'-0"
Approved: Division Chief
Approved: Service Director

Project Title
UPDATE AS-BUILTS
Building Number
24
Location
VAMC Bay Pines Bay Pines FL 33744

Date
2-26-14
Project No.
AS-BUILTS
DRAWING NO.
24-3
Dwg. 1 of .

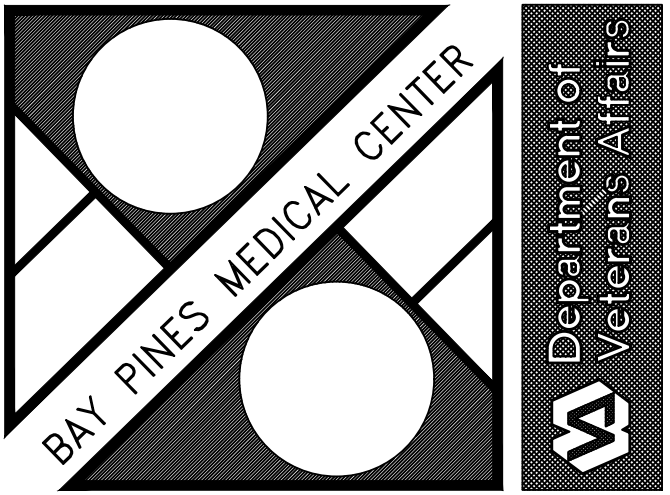

U.S. GOVERNMENT PRINTING OFFICE: 1985-400-385