

| | |
|----------------------------------|--------|
| ADDED RM 149--GENERATOR HOUSE #2 | 5-1-13 |
| Revisions | Date |

Drawing Title
BLDG. 37
FIRST FLOOR PLAN
SCALE: 1/8" = 1'-0"

Approved: Division Chief

Approved: Service Director

Project Title

Building Number
37

Location
V.A.M.C. BAY PINES, FLORIDA

Checked
--


Drawn
MAKI

Date
11-10-97

Project No.
AS-BUILTS

DRAWING NO.
37-1

Dwg. 1 of

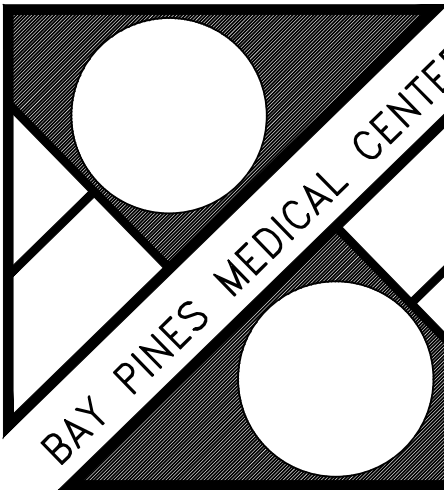

Department of
Veterans Affairs