


ENCLOSURES ARE LOCATED IN BUILDING 71N ROOM 110

- A = PAIGE 800040 12 AWG POWER CABLE
B = PAIGE 800038 14 AWG POWER CABLE
C = PAIGE 800002 J-BUS OR X-BUS CABLE
D = PAIGE 800008 J-DROP AND CONSOLE CABLE
E = PAIGE 800014 S-BUS CABLE
F = PAIGE 800012 CL-DROP CABLE
H = PAIGE 454691AHW TV & LIGHTING CONTROL CABLE

CABLE LEGEND

C FROM GCM8 BUILDING 71N IN ROOM 215

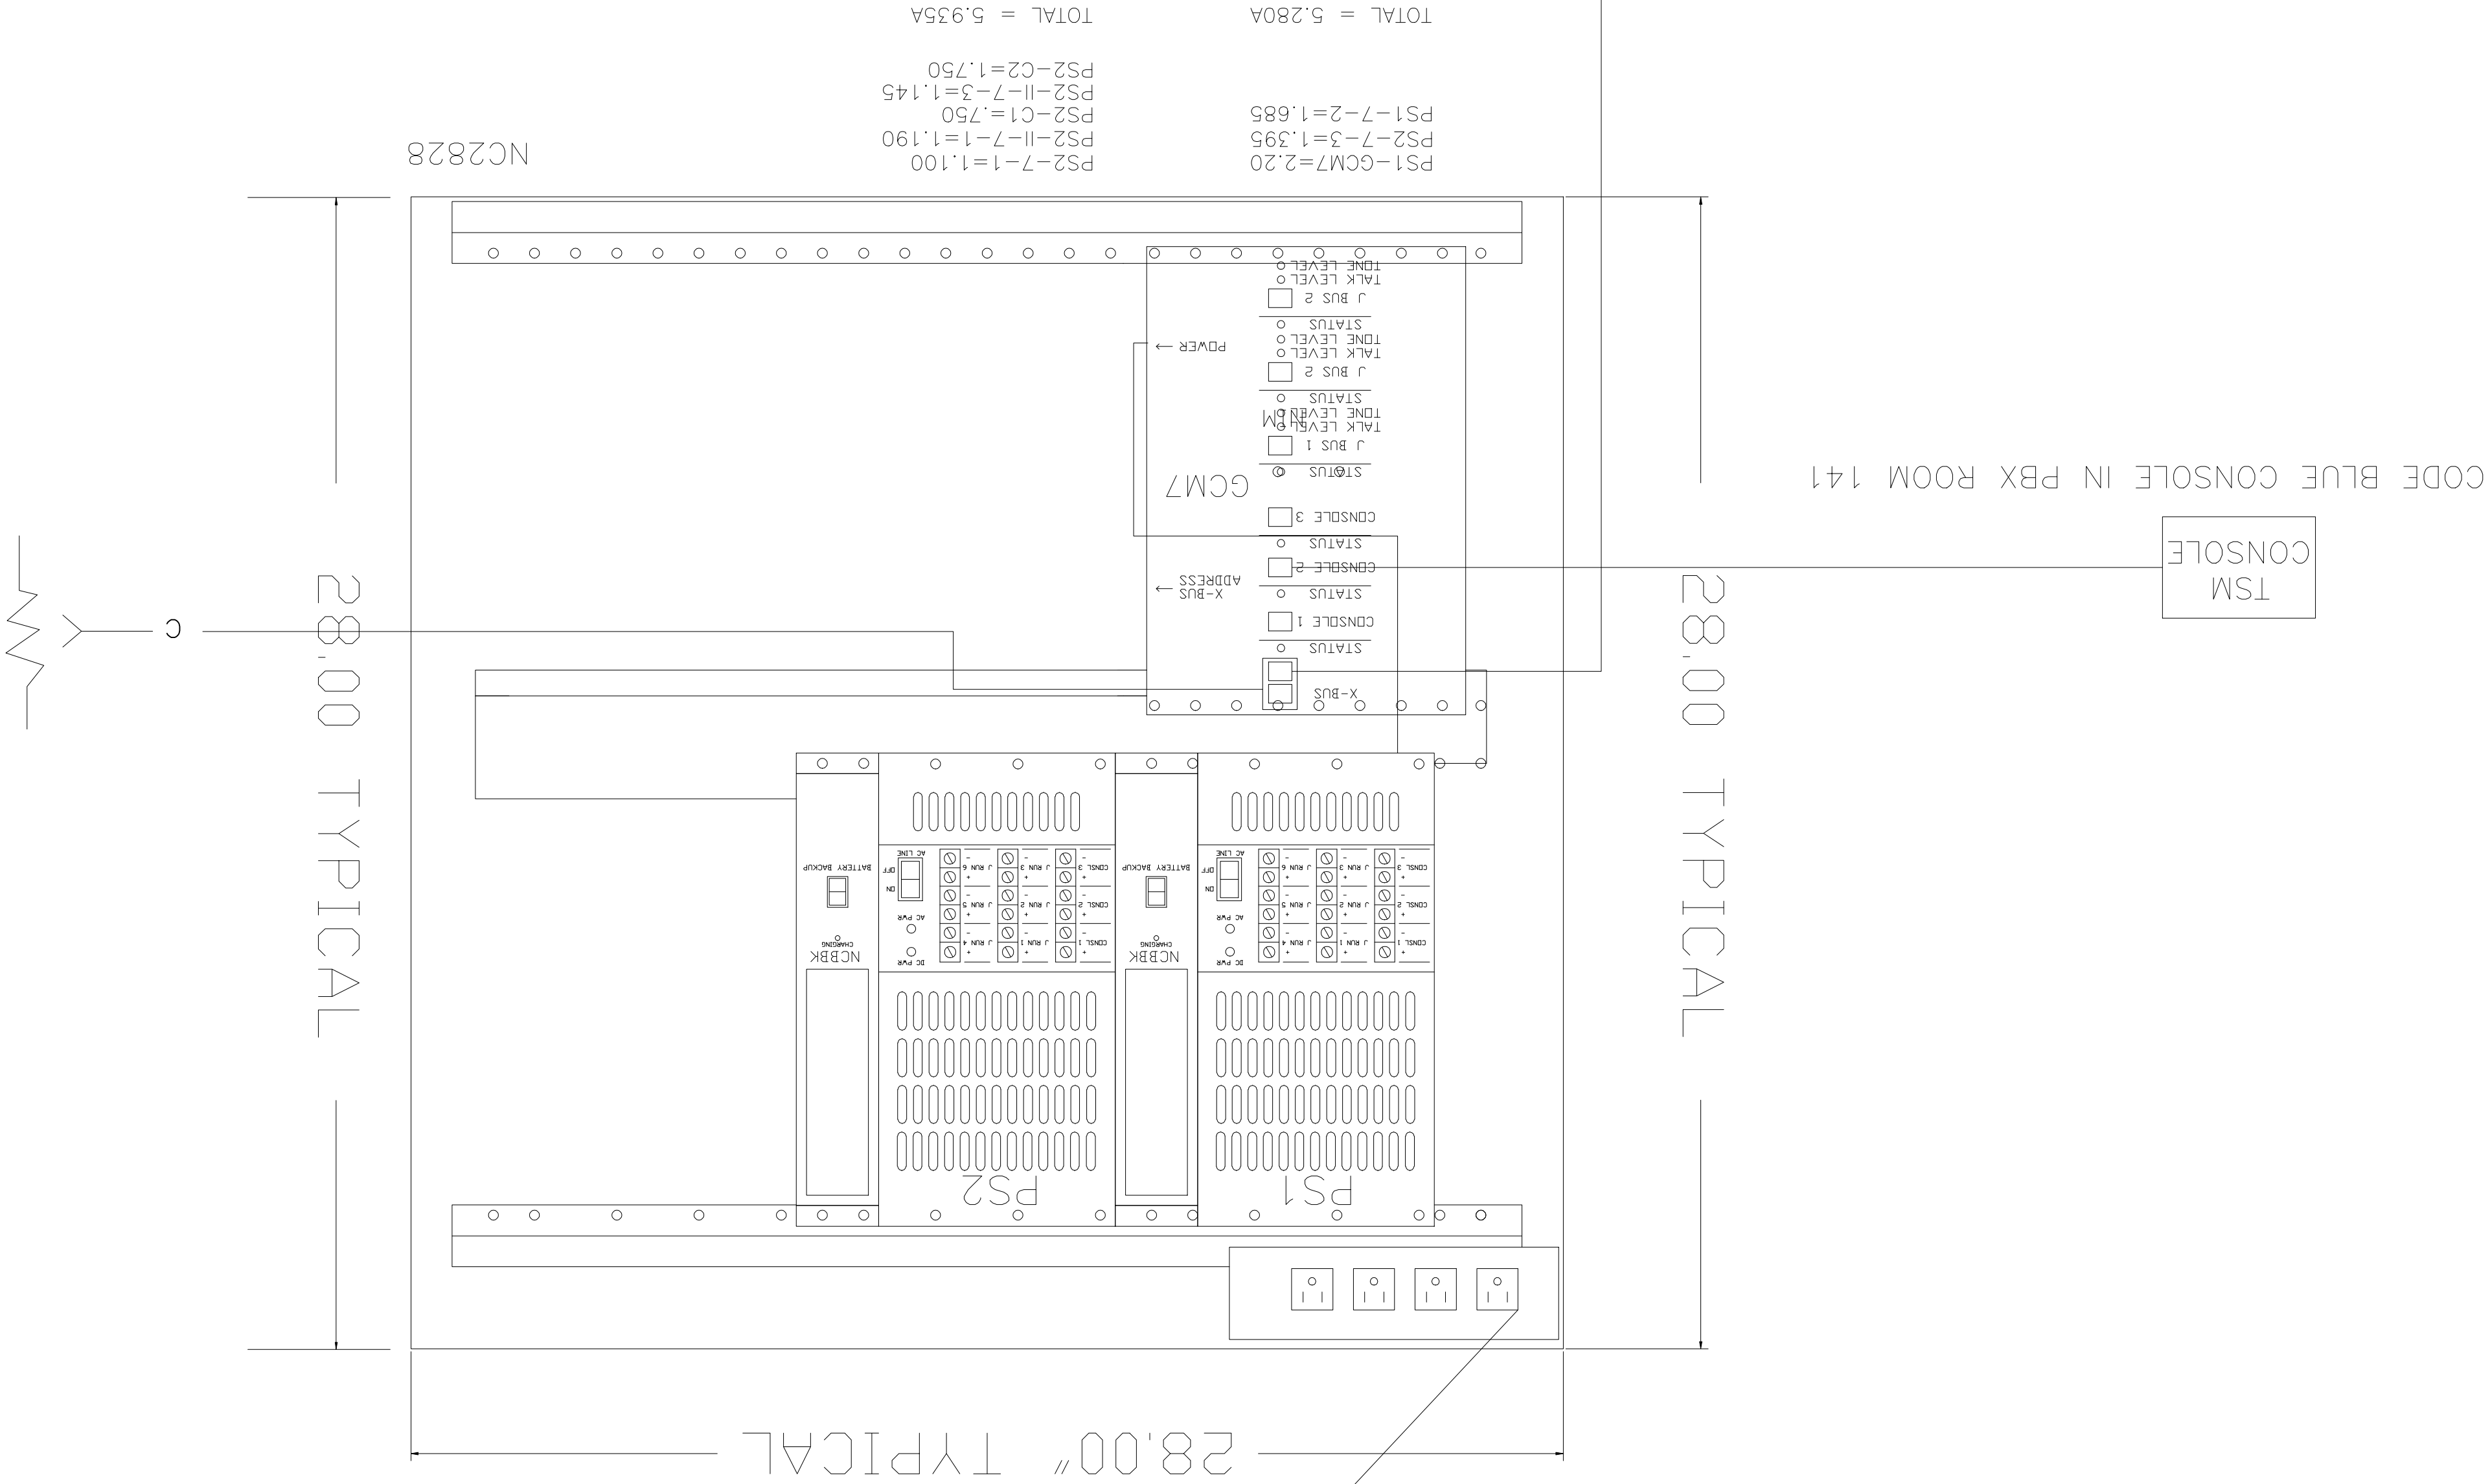

120 VAC 15 AMP CIRCUIT SUPPLIED BY OTHERS

FIRST FLOOR
NURSE CALL
ENCLOSURE
NC-112

Contents:

Revision: _____
Date: _____

Revision: _____
Date: _____

ASBUILT
Revision: A
Date: 6/21/10

9/17/2009

Issue Record:

9/17/2009

Drawn: _____
Date: _____

Mike Clute

Approved: _____
Date: _____

Job No. _____

VA MEDICAL CENTER
BUILDING 71N ED
SHERIDAN, WYOMING

RESPONDER IV NURSE CALL SYSTEM

Key Plan:

4242 Delaware Street
Denver, CO 80216
303-750-6500
www.beaconcom.com

Beacon
Value. Integrity. Service.