

Key Plan:

**VA MEDICAL CENTER
 WOMENS BUILDING 71S
 SHERIDAN, WYOMING**

RESPONDER IV NURSE CALL SYSTEM

Job No. _____
 Approved: *M. Clute*
 Date: _____
 Drawn: **Mike Clute**

Issue Record:
 Submitted Date: **9/17/2009**

Revision: **A** Date: **8/21/10**
ASBUILT

Revision: _____ Date: _____


Revision: _____ Date: _____

Contents:
 FIRST FLOOR
 ASCOM
 BLDG 71S
 AS 1.25

QTY	MANUF.	PART #	DESCRIPTION	BACKBOX	MOUNTING HEIGHT
	ASCOM	IPBS1-A3	IP-DECT BASE STATION	N/A	CEILING MOUNT

CABLE LEGEND:
 BELDEN 1585-CAT 5 CABLE

NOTES:
 ALL LOW VOLTAGE WIRING TO ROOM 270.

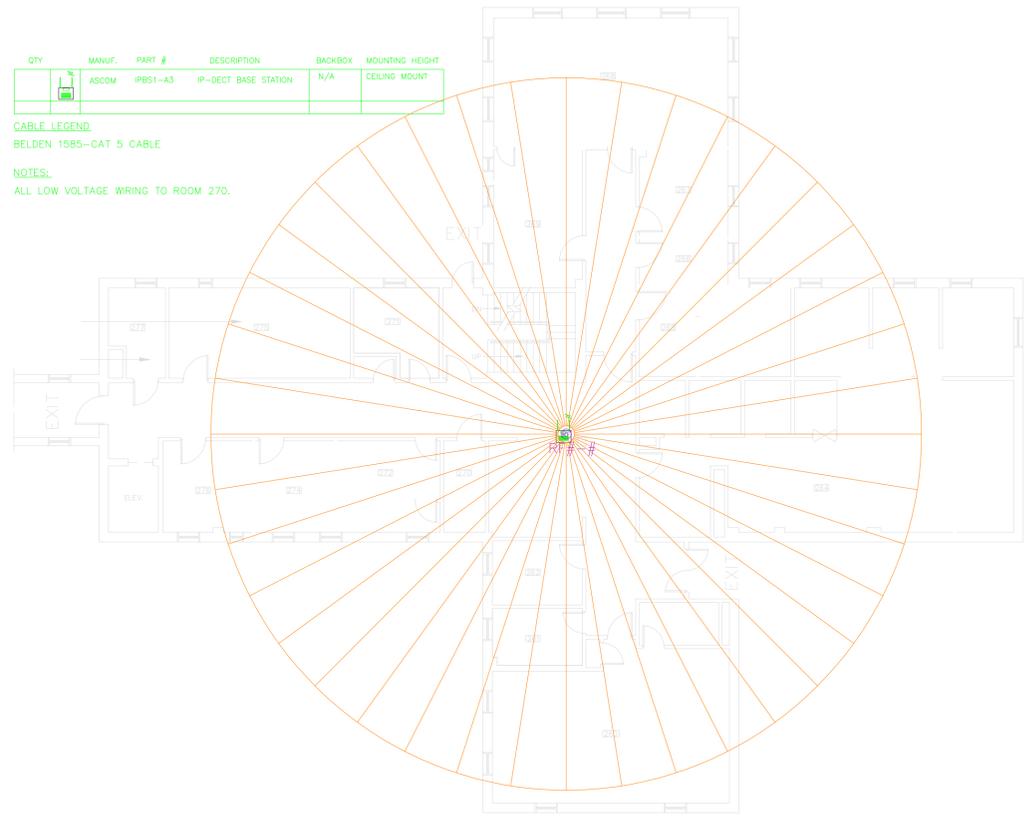

1 ASCOM WOMENS BUILDING 71S FLOOR PLAN