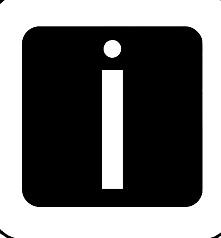
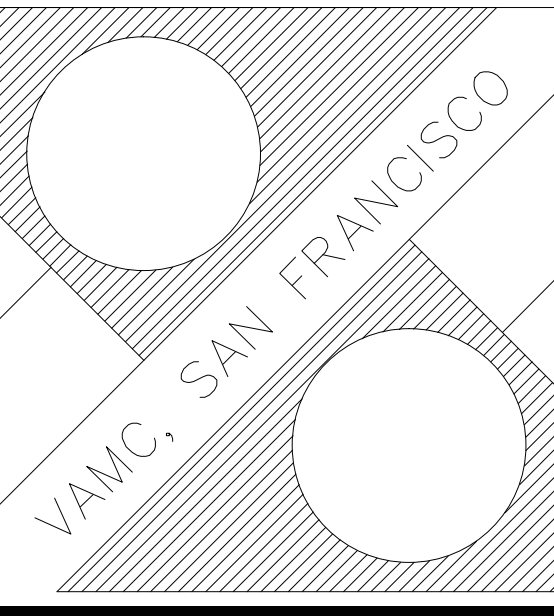


one eighth inch = one foot  
one quarter inch = one foot  
three eighths inch = one foot  
one half inch = one foot  
three quarters inch = one foot  
one inch = one foot  
one and one half inches = one foot  
three inches = one foot

Revisions		Date		Professional Seal		 <b>Indus Systems, Inc.</b> 2352, Main Street, Concord MA 01742 Tel: 978-461-0555 www.indus-systems.com		Drawing Title THIRD FLOOR PLAN ARCHITECTURAL		Project Title AS-BUILT Drawings		Date 05-16-2008		 VAMC, SAN FRANCISCO		Department of Veterans Affairs			
Approved:				Approved:				Building Number 209		Checked		Drawn						Project No.	
Approved:				Approved:				Location VAMC, SAN FRANCISCO				Drawing No.							