

three inches = one foot

one and one half inches = one foot

one inch = one foot

three quarters inch = one foot



one half inch = one foot

three eighths inch = one foot

one quarter inch = one foot

one eighth inch = one foot

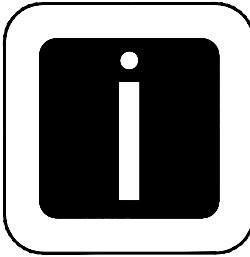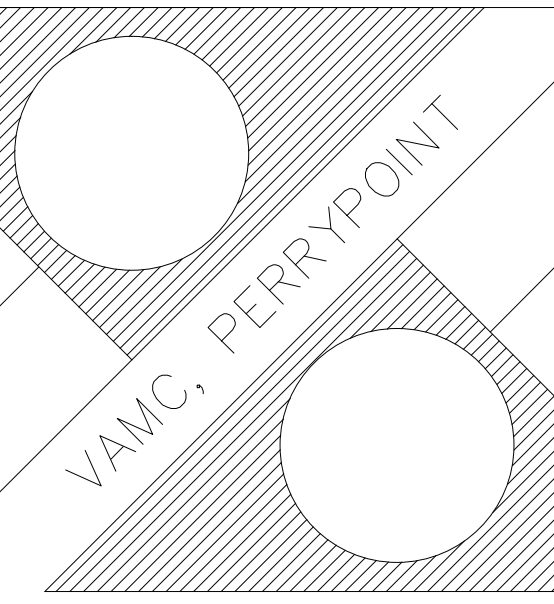

Revisions		Date	Professional Seal		<div><div>Indus Systems, Inc. 2352, Main Street, Concord MA 01742 Tel: 978-461-0555 www.indus-systems.com</div></div>	Drawing Title SECOND FLOOR PLAN ARCHITECTURAL		Project Title AS-BUILT Drawings		Date 03-11-2011	
Approved:		Building Number 82H		Checked	Drawn	Project No.		Drawing No.		<div><div>VAMC, PERRYPOINT</div></div> <div>VA Department of Veterans Affairs</div>	
Approved:		Location VAMC, PERRYPOINT, MARYLAND									