

0
6
three eighths inch = one foot
one and one half inches = one foot
one inch = one foot
three quarters inch = one foot
one half inch = one foot
three eighths inch = one foot
one quarter inch = one foot
one eighth inch = one foot

A

B

C

D

E

F

A

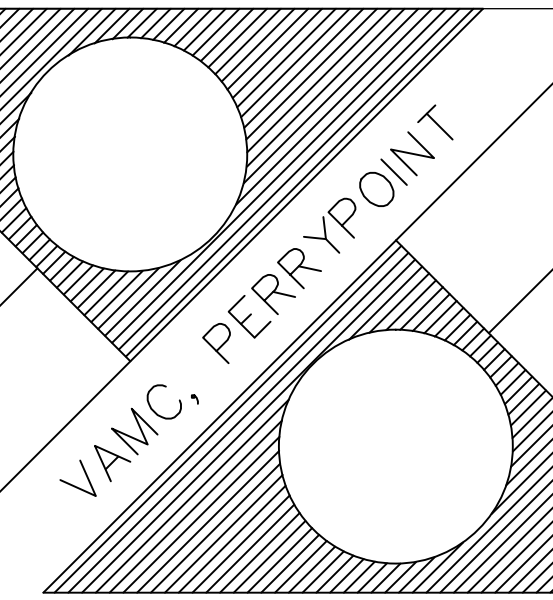
B

C

D

E

F

Revisions		Date	Professional Seal		Drawing Title BASEMENT FLOOR PLAN ARCHITECTURAL		Project Title AS-BUILT Drawings		Date 03-03-2005				VA Department of Veterans Affairs				
						Approved:		Building Number 80H		Checked					Drawn	Project No.	
						Approved:		Location VAMC PERRYPOINT MARYLAND		Drawing No.							