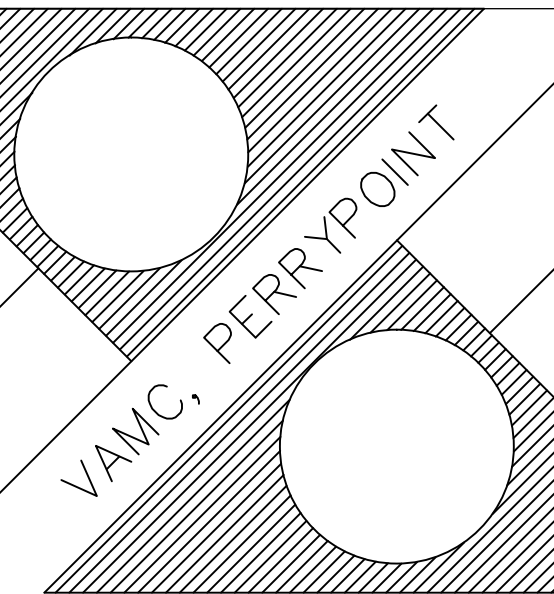


Revisions		Date	Professional Seal	Drawing Title		Project Title		Date		VA Department of Veterans Affairs
				BASEMENT LEVEL PLAN ARCHITECTURAL		AS-BUILT Drawings		05-02-2005		
				Approved:		Building Number	Checked	Drawn		
				Approved:		314B			Drawing No.	
						Location		VAMC PERRYPOINT MARYLAND		