




KEY PLAN

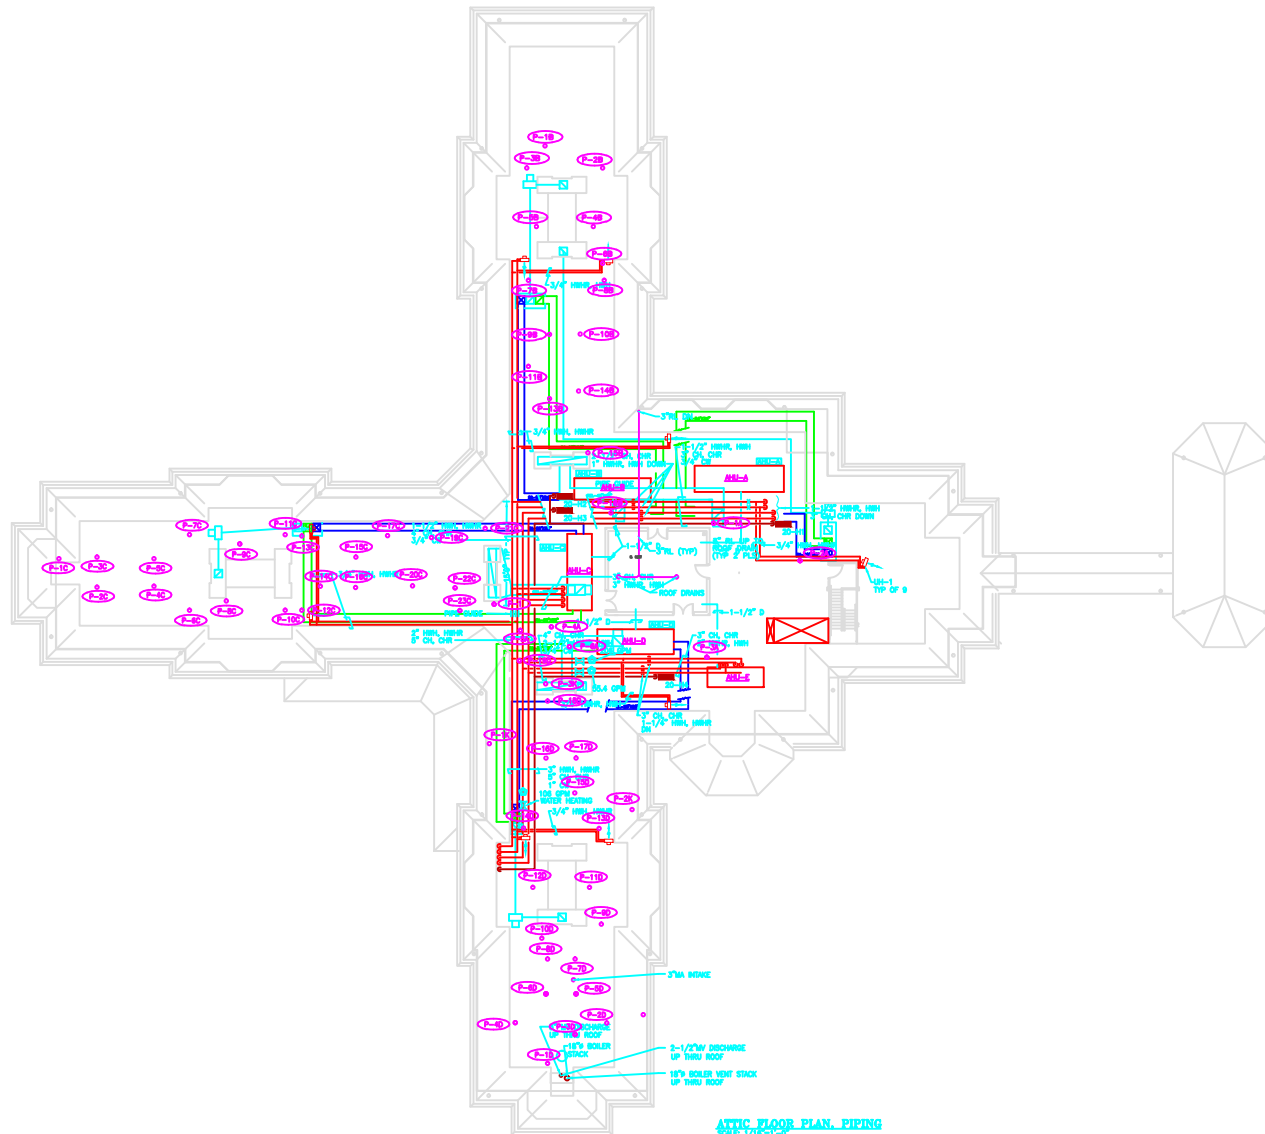

ATTIC FLOOR PLAN, PIPING
SCALE 1/16"=1'-0"

Department of
Veterans Affairs

BALTIMORE
REHABILITATION
EXTENDED CARE
CENTER

Drawn
2504
Checked
2504
Date
8-28-87

ATTIC-FLOORPLAN
PIPING/PLUMBING
(AS-BUILT)

File Path
Building ID
Building
ATTICP6