




one-eighth inch = one foot
 one-quarter inch = one foot
 one-half inch = one foot
 three-eighths inch = one foot
 one inch = one foot
 one and one-eighth inches = one foot
 one and one-quarter inches = one foot
 one and one-half inches = one foot
 one and three-quarters inches = one foot
 two inches = one foot
 two and one-quarter inches = one foot
 two and one-half inches = one foot
 two and three-quarters inches = one foot
 three inches = one foot
 three and one-quarter inches = one foot
 three and one-half inches = one foot
 three and three-quarters inches = one foot
 four inches = one foot
 four and one-quarter inches = one foot
 four and one-half inches = one foot
 four and three-quarters inches = one foot
 five inches = one foot
 five and one-quarter inches = one foot
 five and one-half inches = one foot
 ninety-nine and three-quarters inches = one foot
 one hundred inches = one foot

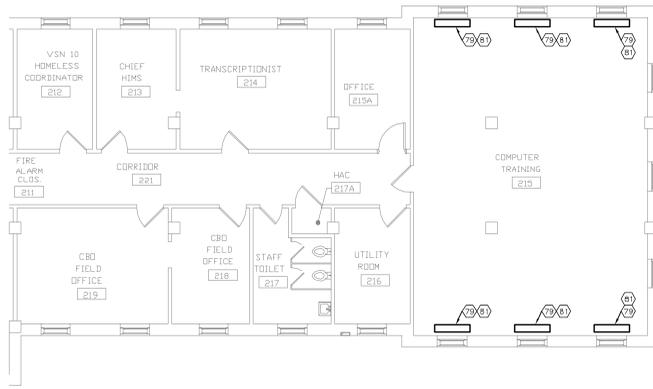

SECOND FLOOR PLAN
 SCALE: 1/8" = 1'-0"

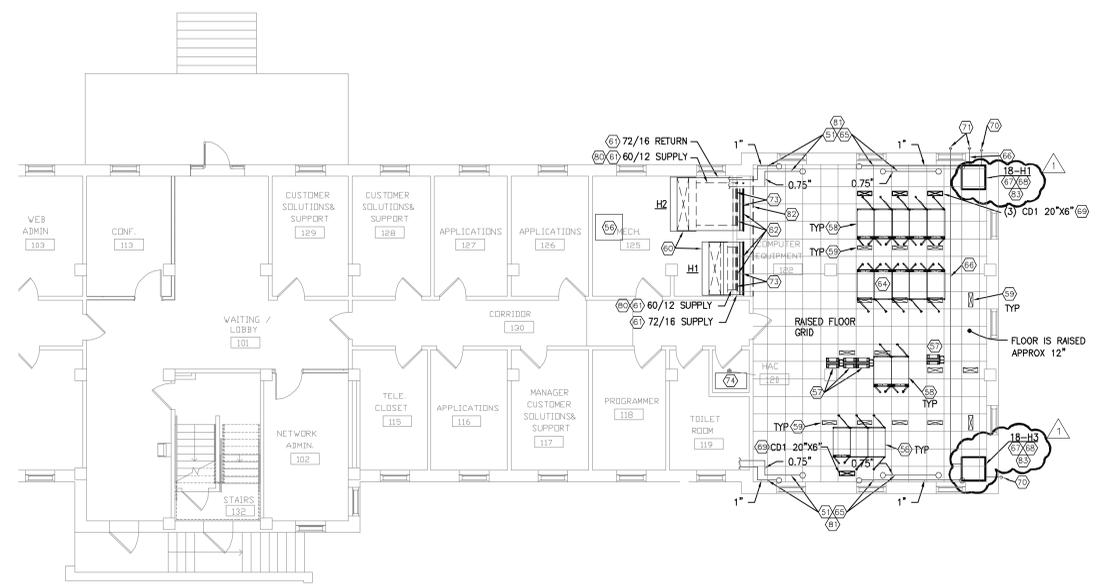

FIRST FLOOR PLAN
 SCALE: 1/8" = 1'-0"

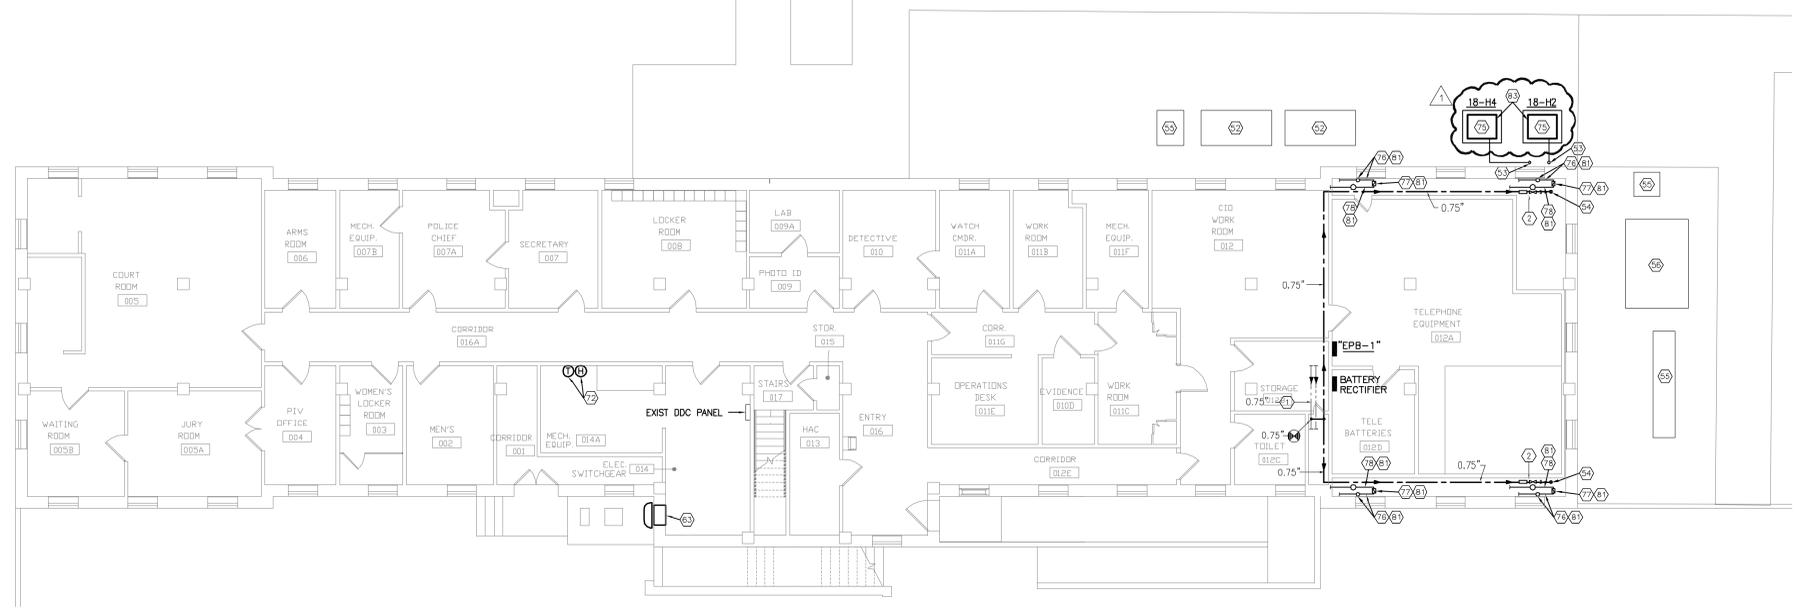

BASEMENT FLOOR PLAN
 SCALE: 1/8" = 1'-0"

GENERAL NOTES

A REFER TO SHEET 18M001 FOR LEGEND, ABBREVIATIONS AND ADDITIONAL GENERAL NOTES.

DIVISION 22 NOTES

- EXISTING PIPING TO REMAIN.
- EXTEND 0.75" DOW PIPING AND PROVIDE BALL TYPE SHUT-OFF VALVE, STRAINER, 0.75" SIZE REDUCED PRESSURE TYPE BACKFLOW PREVENTER, AND CAP FOR EXTENSION BY DIVISION 23 CONTRACT AS INDICATED.

DIVISION 23 NOTES


- EXISTING PIPING TO REMAIN.
- EXISTING 10 TON COMPUTER ROOM CONDENSING UNIT TO REMAIN.
- PROVIDE REFRIGERANT PIPING AND ACCESSORIES PER MANUFACTURERS RECOMMENDATIONS. LINE REPRESENTS APPROXIMATE PIPE ROUTE.
- HUMIDIFIER PIPING FROM ABOVE. REFER TO FIRST FLOOR PLAN ON THIS SHEET.
- EXISTING CONDENSING UNIT TO REMAIN.
- EXISTING AIR HANDLING UNIT TO REMAIN.
- EXISTING RELAY RACK TO REMAIN.
- EXISTING SERVER RACK TO REMAIN.
- EXISTING FLOOR TYPE AIR DIFFUSER TO REMAIN.
- EXISTING 10 TON COMPUTER ROOM A/C UNIT TO REMAIN.
- EXISTING DUCTWORK TO REMAIN.
- REMOVE EXISTING SIDEWALL AIR DEVICE AND SECTION OF DUCTWORK AS REQUIRED FOR INSTALLATION OF SMOKE DAMPER. EXTEND/MODIFY DUCTWORK AS REQUIRED AND RE-INSTALL AIR DEVICE.
- EXISTING EXHAUST FAN TO REMAIN. REFER TO CONTROLS SEQUENCE ON SHEET 18M001 FOR WORK ASSOCIATED WITH FAN.
- NEW SERVER RACK BEING PROVIDED UNDER VA PROJECT NUMBER 538-13-100.
- PROVIDE ADDITIONAL 1.5" OF INSULATION OVER EXISTING PIPE. INSULATION ABOVE CEILING OF SERVER ROOM. FIELD VERIFY PIPE SIZE AND INSULATION THICKNESS. APPROXIMATE PPE SIZE INDICATED. APPROXIMATE INSULATION THICKNESS 1.5".
- PROVIDE REFRIGERANT PIPING AND ACCESSORIES BELOW RAISED FLOOR PER MANUFACTURERS RECOMMENDATIONS. LINE REPRESENTS APPROXIMATE PIPE ROUTE.
- MODIFY RAISED FLOOR AS REQUIRED FOR INSTALLATION OF NEW A/C UNIT. MODIFY FLOOR PER FLOOR MANUFACTURERS RECOMMENDATIONS. COORDINATE WITH CDR.
- EXTEND UNIT MANUFACTURERS RECOMMENDED HUMIDIFIER PIPING DOWN THRU FLOOR AND CONNECT TO CW PIPE PROVIDED UNDER DIVISION 22. SEAL PENETRATION LIQUID TIGHT.
- MATCH EXISTING FLOOR DIFFUSERS. INSTALL PER MANUFACTURERS RECOMMENDATIONS.
- EXTEND FULL SIZE PVC CONDENSATE DRAIN PIPE THRU WALL, TURN DOWN AND TERMINATE AT GRADE. PROVIDE SPLASH BLOCK.
- REFER TO BASEMENT FLOOR PLAN ON THIS SHEET FOR CONTINUATION.
- PROVIDE THERMOSTAT AND HUMIDISTAT FOR CONTROL OF EXHAUST FAN. REFER TO CONTROL SEQUENCE ON SHEET 18M001.
- PROVIDE SMOKE DAMPER. LOCATE ACTUATOR OUT OF AIR STREAM. REFER TO CONTROLS SEQUENCE ON SHEET 18M001.
- SIEMENS SAPPHIRE FIRE SUPPRESSION SYSTEM BEING PROVIDED UNDER A SEPARATE VA PROJECT.
- PROVIDE 6" HIGH, 4000 PSI AIR ENTRAINED CONCRETE PAD WITH INTEGRAL WELDED WIRE FABRIC. EXTEND PAD 6" BEYOND EQUIPMENT ON ALL FOUR SIDES.
- INSULATE HORIZONTAL AND VERTICAL 0.75" STEAM CONDENSATE PIPING. APPROXIMATELY FIVE FEET TOTAL LENGTH.
- PROVIDE REMOVABLE INSULATION OVER 0.75" STEAM TRAP.
- INSULATE 1" STEAM SUPPLY PIPING. APPROXIMATELY 5 FEET TOTAL LENGTH.
- PROVIDE 2" BOARD INSULATION AT FLOOR UNDER HEATING ELEMENT.
- REMOVE BLANKET INSULATION AND REPLACEMENT WITH BOARD INSULATION.
- THIS WORK TO BE INCLUDED IN DEDUCT ALTERNATE #1.
- EXISTING SOFFIT CONSTRUCTED OF CEILING GRID AND TILES. REVISE AS NECESSARY TO INSTALL DAMPERS BEHIND GRILLES.
- AT LEAST ONE NEW COMPUTER ROOM AIR CONDITIONING UNIT AND ASSOCIATED REMOTE AIR COOLED CONDENSER SHALL BE RUN TESTED AND OPERATIONAL PRIOR TO ELECTRICAL SEQUENCE PHASE 3. TEMPORARY ELECTRIC WILL BE PROVIDED BY DIVISION 23.

PROJECT NO. 14-00000000
 HEAPP ENGINEERING
 DAYTON, COLUMBUS, OHIO & INDIANAPOLIS, INDIANA
 MECHANICAL ELECTRICAL COMMISSIONING TECHNOLOGY

Revisions	Date
1 ADDENDUM #1	2/27/13

CONSULTANTS:

Heapy Engineering
 Mechanical Electrical Commissioning Technology
 Nationally Recognized Leader in Sustainability / LEED
 1400 W Dorothy Lane, Dayton OH 45409-1310
 Ph: 937-224-0861 Fax: 937-224-5777 www.heapy.com
 Heapy Project Number: 2012-04619 Firm License: 01528

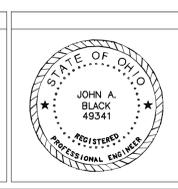

ARCHITECT/ENGINEERS:

RDC/JOHN POE ARCHITECTS

531 EASTWOOD DRIVE
 INDIANAPOLIS, INDIANA 46204
 800.867.3888 PHONE
 317.491.4838 FAX
 jpo@rdcpoe.com

Drawing Title

**FLOOR PLANS
 PLUMBING AND HVAC**

Approved: Project Director

Project Title

**REHAB B18
 MACHINE ROOM**

Location
Chillicothe, Ohio

Date
 12/27/2012

Checked
 CLC

Drawn
 DPB/WJS

Project No.
 VA Project No. 538-13-119
 JPA Project No. 12022.00

Building Number
 18

Drawing Number
18M101

Dwg. of

Office of
 Construction
 and Facilities
 Management

Department of
 Veterans Affairs

SEQUENCE OF CONSTRUCTION:

- PHASE I:**
- ALL EXISTING UNDERGROUND UTILITIES ARE TO BE MARKED, DEPTH LOCATED IN AREAS WHERE NEW DUCTBANKS ARE TO CROSS OR EQUIPMENT IS LOCATED.
 - SAW CUT BLOCK WALL (FROM ELECTRICAL ROOM SIDE) TO GAIN ACCESS INTO THE BELOW-STAIR CAVITY AREA. EXCAVATE THE AREA NEAR B18 STAR CAVITY FOUNDATION WALL.
 - SUBMIT COORDINATION DRAWINGS SHOWING ALL PROPOSED CONDUIT (2" AND LARGER) EQUIPMENT, ETC... FOR APPROVAL BY COTR AND ELECTRICAL ENGINEER.
 - ROUGH-IN NEW 800A DISTRIBUTION PANEL "MDP-1A", SERVICE ENTRANCE RATED AUTOMATIC TRANSFER SWITCH AND FEEDER CONNECTING THE TWO IN EXISTING ELECTRICAL ROOM. ROUGH-IN NEW PRIMARY CONDUIT AND FEEDER FROM EXISTING PAD MOUNTED SWITCH TO NEW TRANSFORMER CONCRETE PAD LOCATION. ROUGH-IN NEW SECONDARY CONDUIT AND FEEDERS FROM NEW TRANSFORMER CONCRETE PAD LOCATION TO EXISTING ELECTRICAL ROOM AND TERMINATE TO NEW SERVICE ENTRANCE ATS.
 - ROUGH-IN NEW EMERGENCY CONDUITS AND FEEDERS (LIFE SAFETY AND OPTIONAL STANDBY) FROM NEW GENERATOR CONCRETE PAD LOCATION TO EXISTING ELECTRICAL ROOM AND TERMINATE OPTIONAL STANDBY FEEDER TO NEW SERVICE ENTRANCE ATS. STUB LIFE SAFETY CONDUIT AND FEEDER IN TO MAIN ELECTRICAL ROOM FOR FUTURE EXTENSION.
 - ROUGH-IN NEW FEEDER FROM DISTRIBUTION PANEL "MDP-1A" AND STUB TO EXISTING DISTRIBUTION PANEL "PDP-1".
 - ROUGH-IN NEW FEEDERS FROM DISTRIBUTION PANEL "MDP-1A" AND TERMINATE TO TWO(2) NEW 5-TON COOLING UNITS LOCATED IN THE EXISTING SERVER ROOM.
- PHASE II:**
- PROVIDE AND SET TEMPORARY 100KW (125KVA, 348A, 208Y/120V-3PH-4W) GENERATOR WITH OVERLOAD PROTECTION AND TEMPORARY FEEDERS FOR TEMPORARY POWER TO DISTRIBUTION PANEL "PDP-1" (SERVES EXISTING UPS DISTRIBUTION PANEL, EXISTING LIBERT INDOOR/OUTDOOR UNIT AND EXISTING TELEPHONE ROOM PANELS) DURING CUTOVER. COORDINATE PATH OF TEMPORARY FEEDERS THRU EXISTING MECH/ELEC ROOMS TO ACCESS "PDP-1" BUSBARS. TEMPORARY FEEDERS SHALL BE LAID ON FLOOR DURING CUTOVER. PROTECT FEEDERS WHERE ACCESSIBLE TO PUBLIC/PEDESTRIAN TRAFFIC.
 - PROVIDE POWER TO ONE(1) OF THE 5-TON COOLING UNIT (INDOOR AND OUTDOOR UNITS) FROM TEMPORARY GENERATOR. CONTRACTOR IS PERMITTED TO UTILIZE PERMANENT FEEDER FOR TEMPORARY EMERGENCY POWER TO COOLING UNIT(S). COORDINATE WORK WITH DIVISION 23.
 - CLOSE BREAKER ASSOCIATED TO EXISTING PANEL "EMG-2" PRIOR TO DOWNTIME TO FREE UP SPARE CAPACITY ON GENERATOR. COORDINATE BREAKER CLOSURE WITH VA TO ENSURE ALL ASSOCIATED LOADS HAVE BEEN PROPERLY SHUT DOWN.
 - VA SHALL DETERMINE ALL NON-ESSENTIAL LOADS TO TURN OFF WITHIN SERVER ROOM TO EXTEND UPS BATTERY LIFE (BACKUP TIME). COORDINATE WORK HAS BEEN COMPLETED WITH COTR PRIOR TO CUTOVER OF TEMPORARY POWER.
 - UTILIZE UPS POWER (APPROX. 25 MIN OF BATTERY BACKUP) DURING CUTOVER TO TEMPORARY GENERATOR. TERMINATION OF TEMPORARY CONDUCTORS FROM TEMPORARY GENERATOR TO EXISTING DISTRIBUTION PANEL "PDP-1" SHALL TAKE PLACE DURING BATTERY LIFE OF UPS.
- PHASE III:**
- SET NEW 225 KVA TRANSFORMER AND 200 KW EMERGENCY GENERATOR. TEST GENERATOR AND TRANSFORMER FUNCTIONALITY TO SATISFACTION OF COTR AND ENGINEER. ALL TESTS SHALL BE COMPLETED PRIOR TO ANY CONNECTION TO CAMPUS PRIMARY OR BUILDING FEEDERS.
 - ONCE TESTING STANDARDS HAVE BEEN MET TO PROPER STANDARDS, TERMINATE ALL ASSOCIATED CONDUCTORS TO TRANSFORMER AND GENERATOR. PROVIDE WRITTEN VERIFICATION TO COTR THAT ALL PHASES OF EQUIPMENT HAVE BEEN VERIFIED WITH RESPECT TO CONDUCTORS PRIOR TO TERMINATIONS.
 - OPEN SKV SWITCH IN PMSG25 SERVING PMT18A AND PMT18. MAXIMUM DOWNTIME FOR BUILDING POWER SHALL BE NO MORE THAN 4 HOURS TO COMPLETE REMAINING PHASES III-V. SUCCESSFUL CONTRACTOR IS RESPONSIBLE FOR PROVIDING ADEQUATE STAFF TO ACCOMMODATE THIS WORK WITHIN THE 4 HOUR WINDOW.
 - TERMINATE NEW FEEDER TO EXISTING DISTRIBUTION PANEL "PDP-1".
 - VERIFY SERVICE ENTRANCE ATS IS IN THE "EMERGENCY" AND BYPASS POSITION AND START NEW 200 KW EMERGENCY GENERATOR ENERGIZING THE NEW DISTRIBUTION PANEL "MDP-1A".
 - CONTRACTOR TO PROVIDE TEMPORARY LIGHTING IN POLICE DISPATCH WITHIN THE 4 HOUR DOWNTIME OF BUILDING POWER.
- PHASE IV:**
- INTERCEPT ALL EXISTING LOADS FED FROM EXISTING "MDP-1" AND EXTEND TO NEW 800A DISTRIBUTION PANEL "MDP-1A".
 - INTERCEPT EXISTING "MDP-2" AND EXTEND TO NEW 800A DISTRIBUTION PANEL "MDP-1A".
- PHASE V:**
- TERMINATE PRIMARY FEEDER WITHIN PMSG25 AND CLOSE TO ENERGIZE NORMAL POWER TO BUILDING 18.
 - SWITCH NEW SEATS TO "NORMAL" POSITION AND SHUT DOWN EMERGENCY GENERATOR.
- PHASE VI:**
- REMOVE ALL EXISTING EQUIPMENT, TRANSFORMERS, GENERATOR, FEEDERS, CONDUITS AND CONCRETE PADS NO LONGER BEING USED ASSOCIATED WITH THIS WORK.
- PHASE VII:**
- INSTALL NEW EMERGENCY PANEL, ATS AND CONNECTING FEEDER.

- NOTES**
- REMOVE EXISTING EMERGENCY GENERATOR, CONCRETE PAD AND ASSOCIATED UNDERGROUND FEEDER/CONDUIT. REFER TO SEQUENCE OF CONSTRUCTION FOR PHASING.
 - REMOVE EXISTING TRANSFORMER, CONCRETE PAD AND ASSOCIATED UNDERGROUND FEEDER/CONDUIT. REFER TO SEQUENCE OF CONSTRUCTION FOR PHASING.
 - NEW EMERGENCY GENERATOR. REFER TO NEW WORK FLOOR PLANS FOR ADDITIONAL DETAILS.
 - NEW PAD MOUNTED TRANSFORMER. REFER TO NEW WORK FLOOR PLANS FOR ADDITIONAL DETAILS.
 - EXISTING PAD MOUNTED PRIMARY ELECTRIC SWITCH.
 - EXISTING UNDERGROUND STEAM LINES/TUNNEL TO REMAIN. PROVIDE REINFORCING OF DUCTBANK WHERE IT CROSSES STEAM LINE TUNNEL. COORDINATE REINFORCING MEANS WITH COTR PRIOR TO INSTALLATION.
 - EXISTING UNDERGROUND STORM PIPING TO REMAIN.
 - EXISTING UNDERGROUND SANITARY PIPING TO REMAIN.
 - EXISTING UNDERGROUND FIRE ALARM/DATA CONDUIT TO REMAIN.
 - EXISTING UNDERGROUND WATER PIPING TO REMAIN.
 - EXISTING UNDERGROUND ELECTRIC TO REMAIN.
 - REMOVE EXISTING UNDERGROUND FUEL STORAGE TANK (T17), FILL PIPE, FUEL LINES (BOTH SUPPLY & RETURN), FUEL GAUGE, ETC. BACKFILL EARTH AND RESTORE GRADE TO MATCH EXISTING CONDITIONS.
 - REMOVE SCHNEIDER ELECTRIC ATS/GENERATOR PT/CT PULLBOX AND ALL CONDUIT/CABLING.
 - SITE GRADING/RETAINING WALL WORK. REFER TO ARCHITECTURAL PLANS.
 - ELECTRICAL ROOM. REFER TO 1/8" PLANS FOR EQUIPMENT LOCATIONS.
 - RUN ELECTRICAL CONDUITS THRU BELOW STAIR CAVITY.
 - CORE DRILL EXISTING WALL, OR INSTALL BELOW FOOTER, FOR ENTRANCE INTO THE EXISTING ELECTRICAL ROOM. EXCAVATION OF EXISTING SOIL/ASPHALT WILL EXPOSE ELEVATION REQUIRED TO ENTER THE BUILDING.
 - SLOPE NEW FEEDERS AWAY FROM BUILDING. REFER TO SHEET 18ES01 FOR UNDERGROUND CONDUIT DETAILS.
 - INSTALL NEW PRIMARY FEEDER MINIMUM OF 30" BELOW GRADE (PER NEC 1300.50).
 - REMOVE EXISTING ABANDONED UNDERGROUND CONDUIT BACK TO MANHOLE AS INDICATED.
 - REMOVE EXISTING UNDERGROUND 5KV PRIMARY FEEDER, CONDUIT AND DUCTBANK. REFER TO SEQUENCE OF CONSTRUCTION.
 - REMOVE EXISTING GENERATOR FUEL MONITORING EQUIPMENT, CONDUIT, WIRING, WEATHERPROOF ENCLOSURE AND SUPPORT BRACING.
 - REMOVE EXISTING UNDERGROUND GENERATOR FEEDER. REFER TO SEQUENCE OF CONSTRUCTION FOR PROPER PHASING.
 - REMOVE UNDERGROUND 5KV PRIMARY FEEDER.
 - REMOVE UNDERGROUND FUEL PIPING.
 - PROVIDE ALL SAW CUTTING AND PATCHING OF EXISTING CONCRETE SIDEWALK. REMOVE AND REPLACE ENTIRE PADS.
 - PROVIDE ALL SAW CUTTING AND PATCHING OF EXISTING ASPHALT DRIVEWAY.
 - PROVIDE ALL SAW CUTTING AND PATCHING OF EXISTING CONCRETE CURBS.
 - REMOVE EXISTING UNDERGROUND SECONDARY FEEDER. REFER TO SEQUENCE OF CONSTRUCTION FOR PROPER PHASING.
- GENERAL NOTES**
- SEQUENCE OF CONSTRUCTION INDICATED BELOW IS ONE POSSIBLE SOLUTION TO MINIMIZE DOWNTIME OF THE BUILDING ELECTRICAL SYSTEM. CONTRACTOR IS REQUIRED TO SUBMIT A DETAILED SEQUENCE OF OPERATION TO THE COTR AT THE BEGINNING OF THE PROJECT. SEQUENCE MUST BE APPROVED BY THE COTR BEFORE THE CONTRACTORS ARE PERMITTED TO COMMENCE WORK. DEVIATIONS FROM THE FOLLOWING PROPOSED SEQUENCE OF CONSTRUCTION WILL BE REVIEWED, BUT WILL NOT BE GROUNDS FOR ADDITIONAL COST TO THE GOVERNMENT.
 - ALL CUT OVER WORK DOWNTIME SHALL BE DONE OUTSIDE OF NORMAL WORKING HOURS (NIGHTS AND WEEKENDS).
 - COORDINATE DOWNTIME SCHEDULES WITH COTR MINIMUM OF 30 DAYS IN ADVANCE FOR PROPER COORDINATION.
 - REFER TO FLOOR PLANS AND SINGLE LINE FOR ADDITIONAL INFORMATION.
 - CONTRACTOR SHALL FIELD VERIFY EXACT LOCATION OF ALL UNDERGROUND UTILITIES WITHIN AFFECTED AREAS/SCOPE OF WORK. THIS WORK SHALL BE PERFORMED PRIOR TO ANY EXCAVATION WORK. CONTRACTOR MUST USE A PROFESSIONAL UNDERGROUND UTILITY LOCATING SERVICE AND SUBMIT ALL FINDINGS TO THE COTR WITH DOCUMENTED SEQUENCE OF CONSTRUCTION FOR REVIEW.
 - ANY DAMAGE TO EXISTING UTILITIES SHALL BE REPAIRED BY THE CONTRACTOR AT NO ADDITIONAL COST TO THE GOVERNMENT.
 - RECOMMEND HYDRO-EXCAVATION TO MINIMIZE DAMAGE TO UNKNOWN UNDERGROUND UTILITIES NOT LOCATED DURING INVESTIGATION.
 - ALL CIRCUITRY IS SHOWN FROM AS-BUILT DRAWINGS. FOR REFERENCE ONLY. UPDATE ON AS BUILT DRAWINGS WHEN LOCATED.
 - PROVIDE ALL EXCAVATION, RIGGING, BACKFILL, GRADING, SEEDING, SURFACE RESTORATION, ETC. AS REQUIRED TO RETURN ALL WORK BACK TO ORIGINAL CONDITIONS.



PAD MOUNTED SWITCH PMSG25
SITE PHOTOGRAPH 1
SCALE: NONE
18ES101



TRANSFORMER PMT18A
SITE PHOTOGRAPH 2
SCALE: NONE
18ES101



NEW SERVICE ENTRANCE INTO BUILDING
SITE PHOTOGRAPH 3
SCALE: NONE
18ES101




SITE PLAN
SCALE: 1" = 10'-0"

PROJECT NO. 2012-04019
 HEAPY ENGINEERING
 DAYTON, COLUMBUS, OHIO & INDIANAPOLIS, INDIANA
 MECHANICAL ELECTRICAL COMMISSIONING TECHNOLOGY
 DATE: February 27, 2013

Revisions	Date

CONSULTANTS:

Heapy Engineering
Mechanical Electrical Commissioning Technology
Nationally Recognized Leader in Sustainability / LEED
1400 W Dorothy Lane, Dayton OH 45409-1310
Ph: 937-224-0861 Fax: 937-224-5777 www.heapy.com
Heapy Project Number: 2012-04019 Firm License: 01528

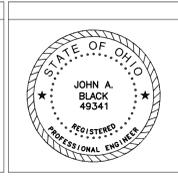

ARCHITECT/ENGINEERS:

RDC/JOHN POE ARCHITECTS

524 EBERHARD STREET
DAYTON, OHIO 45404
937-224-0861 PHONE
937-224-0861 FAX
jpo@rdcpoe.com

Drawing Title

**ELECTRICAL SITE PLAN
REMOVAL & NEW WORK**

Approved: Project Director

Project Title

**REHAB B18
MACHINE ROOM**

Location

Chillicothe, Ohio

Date

12/27/2012

Checked

MSG

Drawn

JAS

Project No.

VA Project No. 538-12-119
JPA Project No. 12022.00

Building Number

18

Drawing Number

18ES101

Dwg. of

**Office of
Construction
and Facilities
Management**

Department of
Veterans Affairs