


The floor plan illustrates the layout of the Operating Floor Level, featuring several key areas and dimensions:

- Rooms and Areas:** BOILER ROOM, PUMP ROOM, ELECTRICAL EQUIPMENT ROOM, VESTIBULE, STORAGE ROOM, LOCKER ROOM, OFFICE, TOILET, and a central area labeled "PIPE TUNNEL COVER & COVER".
- Dimensions:** The plan is heavily annotated with dimensions in feet and inches. Overall dimensions include 94'-0" by 94'-0" and 99'-0" by 99'-0". Room-specific dimensions range from 1'-0" to 10'-0".
- Plumbing Features:**
 - Stacks:** Multiple vertical stacks are shown, including a "STACK LADDER AND GUARD" and a "STACK 3/4\"
 - Fixtures:** Toilets are located in the TOILET room, and a "METAL ACCESS DOOR ABOVE" is noted near the 30 TON CAPACITY 14\"
 - Pipes:** Various pipe runs are indicated, such as "PIPE TUNNEL COVER & COVER" and "PIPE TUNNEL COVER & COVER".
- Other Details:**
 - Structural:** "STEEL STAIR", "STEEL LADDER", and "STEEL STAIR" are noted.
 - Equipment:** "ELECTRICAL EQUIPMENT ROOM" and "ELECTRICAL EQUIPMENT ROOM" are labeled.
 - Access:** "METAL ACCESS DOOR ABOVE" and "METAL ACCESS DOOR ABOVE" are noted.

NOTE: SEE PLUMBING DRAWINGS FOR FITTING BRANDS AND CONNECTION TO STORM DRAINAGE SYSTEM.

FLOOR PLAN AT OPERATING FLOOR LEVEL

CONTRACTOR TO VERIFY SITE CONDITIONS

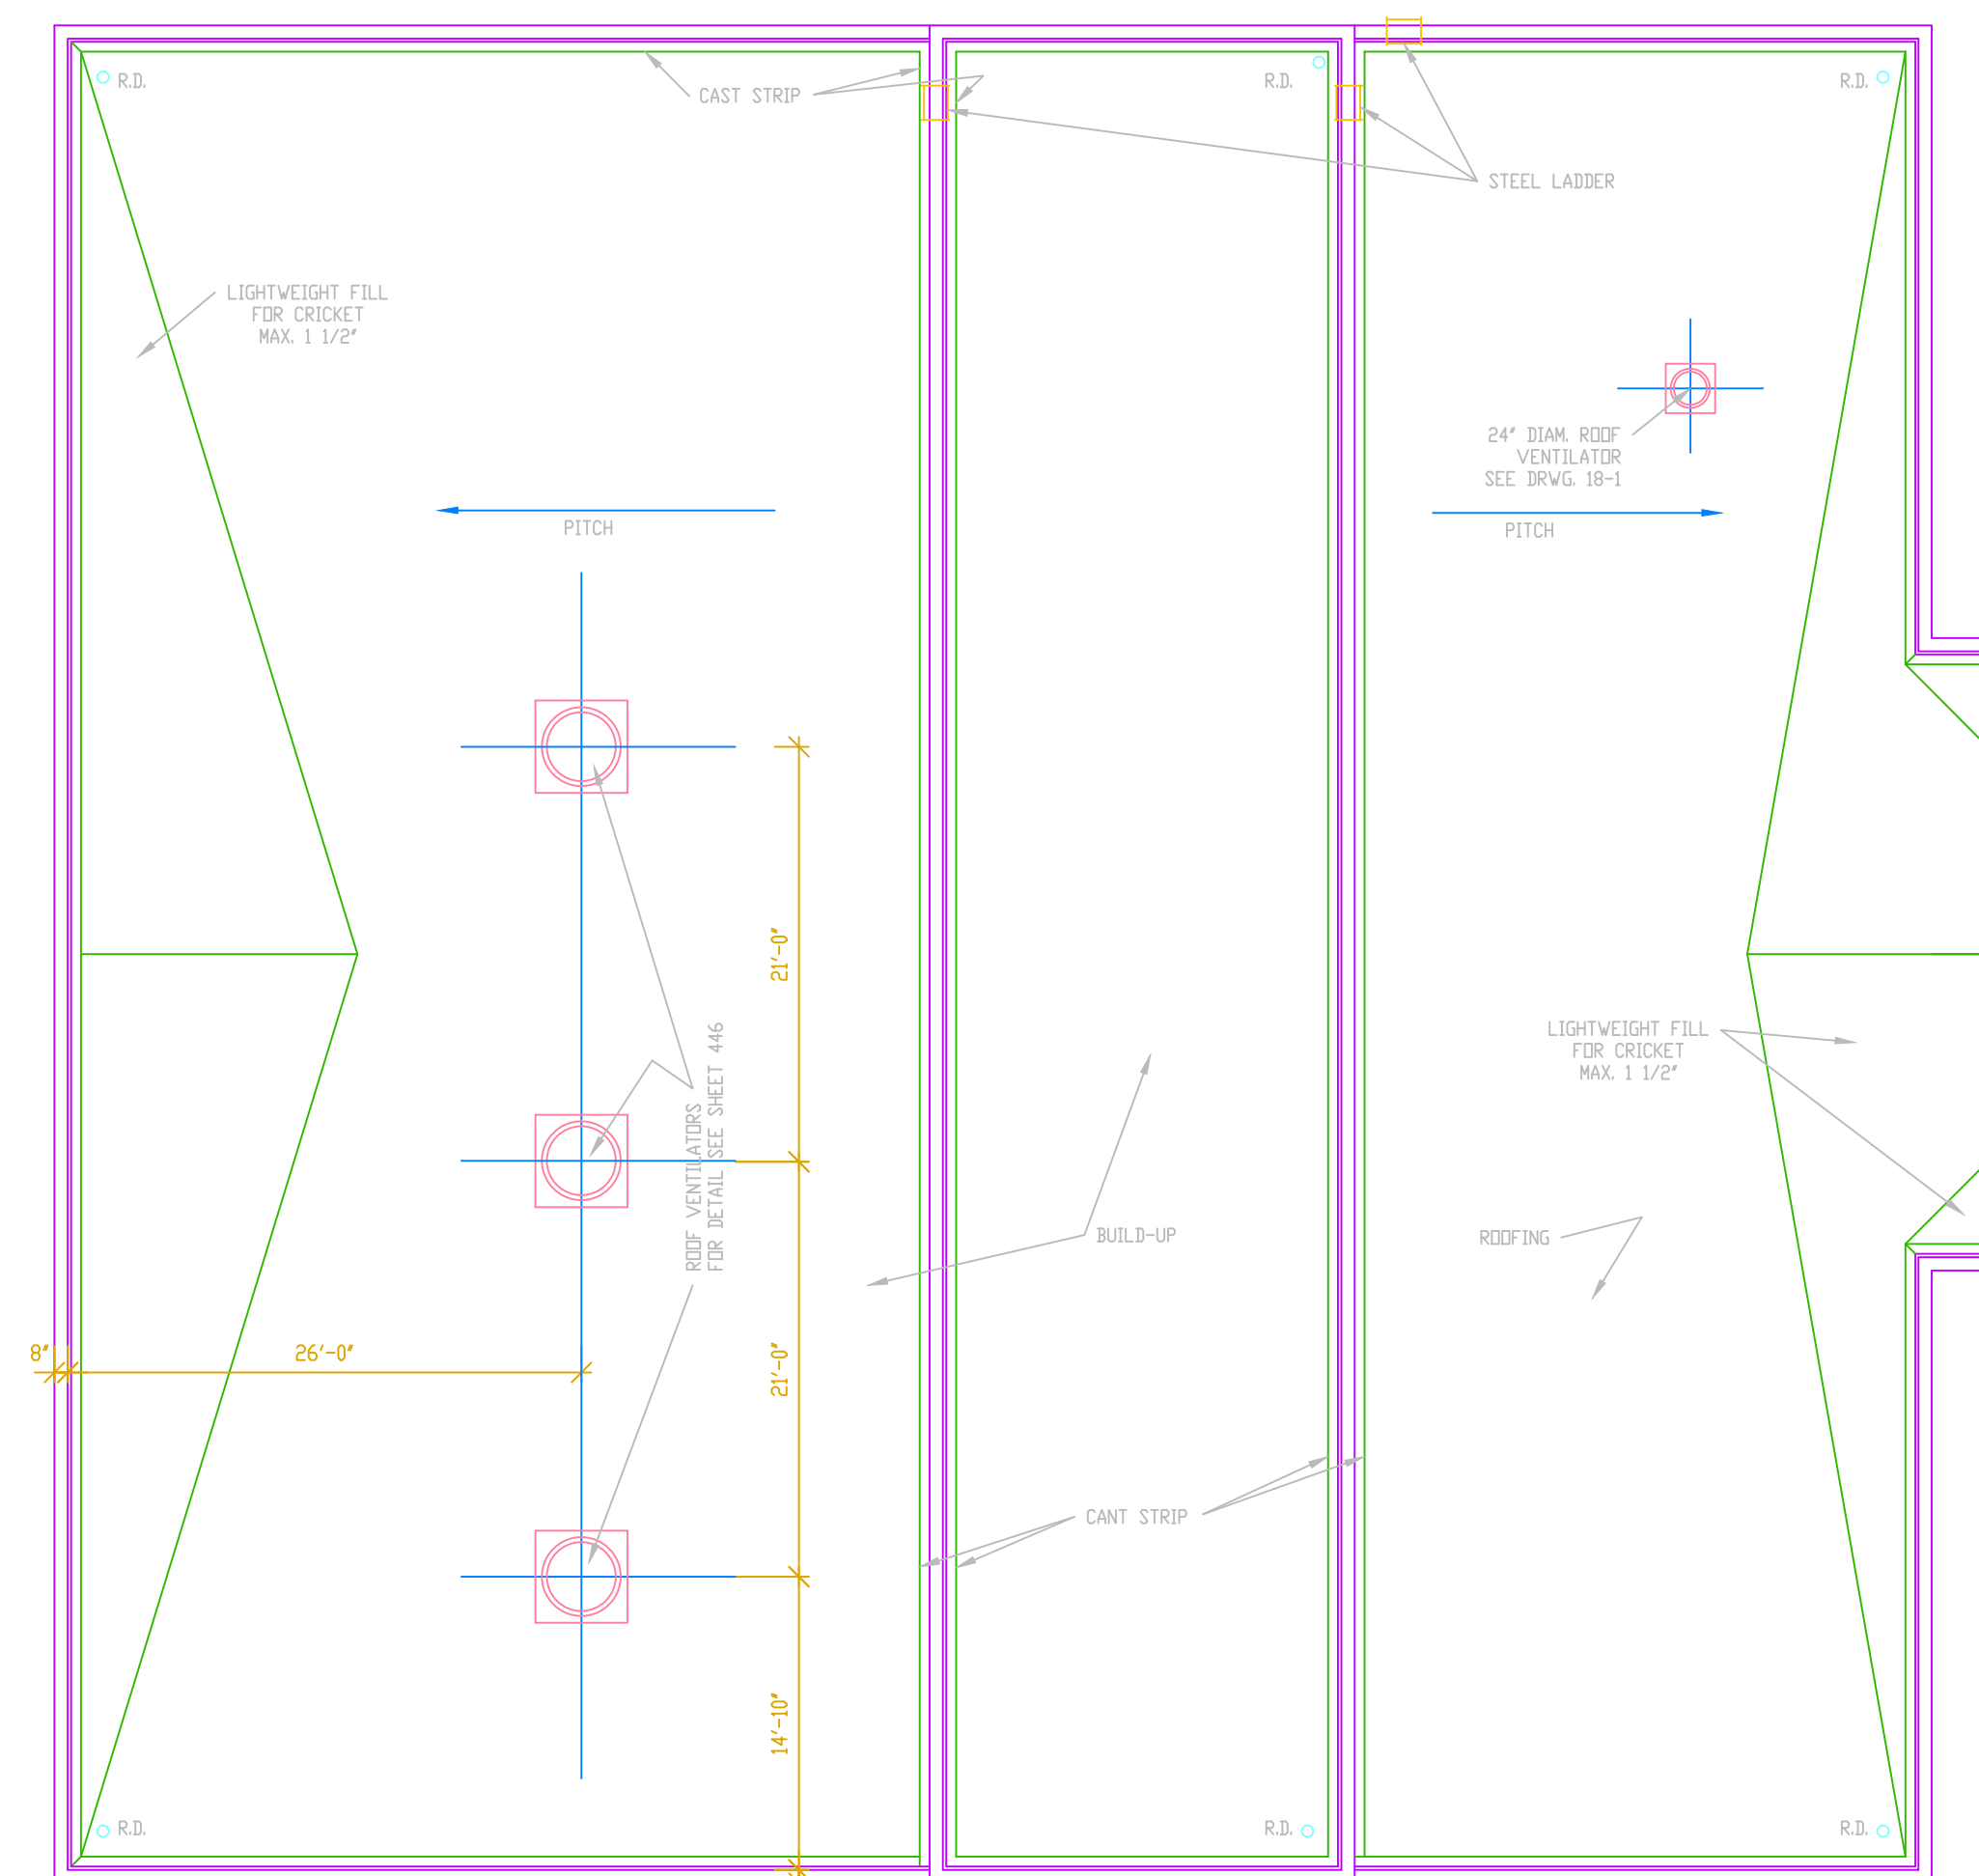

GRAPHIC SCALE



0 4' 8' 16' 24'

[illegible]

	Drawing Title
e	AS-BUILT FROM ORIGINAL DRAWINGS
e	Approved: Safety Manager/M&O Supervisor
e	Approved: Chief of Facilities Management Svr.

Project Title		
BOILER PLANT MODIFICATIONS		
Building Number BUILDING #18	Checked	Drawn BLF
Location W.G.(Bill) Hefner Medical Center 1501 Brenner Ave. Solisbury, NC 28144		

Date	15 JAN 2013
Project No.	659-13-310
DRAWING NO.	A-001
DWG. 4 OF 10	

