

# Amendment



Service Disabled Veteran Owned  
3815 N. 109<sup>th</sup> Plaza — Omaha, NE  
www.21deltaengineers.com  
Ph: (402) 496-4115

April 22, 2013

To: **VA Central Iowa Health Care System**  
Attn: **Greg Byrnes**  
3600 30th Street  
Des Moines, IA **50310-5885**

Re: Amendment #1  
Exterior Signage Project  
VA Project #636A6-12-101

Mr. Byrnes,

The following items should be included in the next amendment on the above referenced project:

**Item 1: Refer to Drawing Sheet AS-2:**

Modify this sheet as shown in the attached in order to correct several dimension conflicts and metric equivalents.

**Item 2: Refer to Drawing Sheet AS-3:**

Modify this sheet as shown in the attached in order to correct several dimension conflicts and metric equivalents.

**Item 3: Refer to Drawing Sheet AS-4:**

- A) Modify this sheet as shown in the attached in order to correct several dimension conflicts, correct several metric equivalents, and to modify the text for sign location 26.
- B) This sheet is also reissued in order to make much of the text that was unreadable more legible due to a plotting error.

**Item 4: Refer to Drawing Sheet AS-5:**

Modify the metric equivalent listed for the overall sign height of the sign at location 28 to be 1676 MM in lieu of 1981 MM.

**Item 5: Refer to Drawing Sheet AS-8:**

Modify this sheet as shown in the attached in order to delete the detail for sign EN-08.01 and to plot the text of the general notes larger to make them more legible.

**Item 6: Refer to Drawing Sheet CI-1:**

Add a general note "H" to read as follows:  
Directives or notes in these documents to remove a sign shall mean that the sign and any associated post(s) are both to be removed.

**Item 7: Refer to Drawing Sheet CI-2:**

Add a general note "H" to read as follows:  
Directives or notes in these documents to remove a sign shall mean that the sign and any associated post(s) are both to be removed.

April 22, 2013

**Item 8: Refer to Drawing Sheet CI-3:**

Add a general note "H" to read as follows:

Directives or notes in these documents to remove a sign shall mean that the sign and any associated post(s) are both to be removed.

**Item 9: Refer to Drawing Sheet CI-4:**

A) Add a general note "H" to read as follows:

Directives or notes in these documents to remove a sign shall mean that the sign and any associated post(s) are both to be removed.

B) Delete flag note #5 from the drawing area near grid 6B

C) Replace the text of flag note #5 in the note area with "Not Used"

D) Fill in the flag note with a "#" symbol in it in the drawing area near grid 3C with "25".

Please contact me if you have any questions regarding this information.

Todd Stahlnecker

file: 2013-04-22 Amendment #1.doc

**The following questions have been received on this project as of 4/19/2013:**

**Question:** Sheets CI-1 through CI-4. On the sheet notes some say remove and replace with new sign. Does that mean we have to remove the whole sign post and all? Or are we leaving the existing post and just replacing the sign on the existing post?

**Answer:** The post and sign should both be replaced. Amendment 1 adds a general note to each of these drawings to clarify that.

---

**Question:** What is the last day to submit questions on this project?

**Answer:** Close of business on Friday, April 19th

---

**Question:** What is the bid date?

**Answer:** Unless amended, the current bid date is 1:00 PM CST on May 1st. Monitor the solicitation page on [www.fbo.gov](http://www.fbo.gov) for any changes.

---

**Question:** Who do we submit bids to?

**Answer:** Refer to box #8 on the solicitation's first page. It has the address that the offers should be mailed to.

---

**Question:** In regards to details 12 on sheet AS-13 - is there a particular sign manufacturer called out as this is a very particular sign type detail.

**Answer:** No specific manufacture is being called for.

---

**Question:** We cannot read the dimensions on Sign 26 as the letters were blurry.

**Answer:** The "VA" logo letters are 2'-0" tall and the text below use 8" tall letters. Sheet AS-4 is reissued in the amendment to clarify all dimensions on this sheet.

---


**Question:** Note 5 on drawing number CI-4 states to install a new sign EN 08.02. There is a sign type EN 08.01 on drawing AS-8, but no illustration of a sign number EN 08.02. Is the EN 08.02 a typo (should it actually be EN 08.01)? If it is a different sign type, please provide the details.

**Answer:** Note 5 on sheet CI-4 is now removed in the amendment. The correct action at this location is covered by location 23A.


**PARKING COLOR CODE:**

- P Patient/Visitor Parking**  
COLOR OF CIRCLE = LIME PEEL - B3  
LETTER P - T-2 REFLECTIVE WHITE
- P General Parking**  
COLOR OF SQUARE = CLARET J16 - B1B  
LETTER P - T-2 REFLECTIVE WHITE
- P VOLUNTEER**  
COLOR OF SQUARE = BROWN COUNTY - B10 (VERIFY)  
LETTER P - T-2 REFLECTIVE WHITE
- P Government Vehicle Parking (GSA, DAV, Police)**  
COLOR OF SQUARE = WELLS FARGO BLACK - B2  
LETTER P - T-2 REFLECTIVE WHITE
- P Emergency Room Patient/ Visitor Parking**  
COLOR OF CIRCLE = RED (OSHA) - B1T  
LETTER P - T-2 REFLECTIVE WHITE


**EN-03.02** NON-ILLUMINATED EXTERIOR SIGN  
Primary Directional Post and Panel  
**LOC. 05** REF. PAGE: AS.6  
REF. PAGE: AS.9 - FOR SITE PLACEMENT

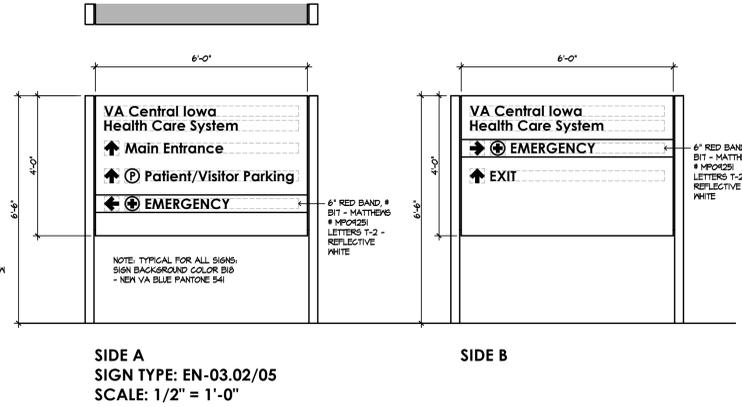


**EN-03.03** NON-ILLUMINATED EXTERIOR SIGN  
Secondary Post and Panel  
**LOC. 06A** REF. PAGE: AS.7  
REF. PAGE: AS.9 - FOR SITE PLACEMENT

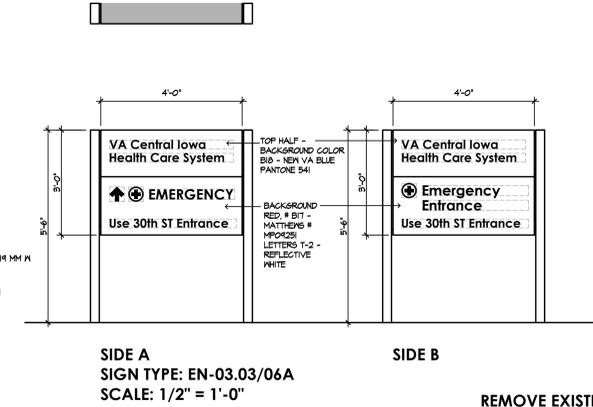


**EN-03.03A1** NON-ILLUMINATED EXTERIOR SIGN  
Secondary Post and Panel  
**LOC. 06B** REF. PAGE: AS.7  
REF. PAGE: AS.9 - FOR SITE PLACEMENT

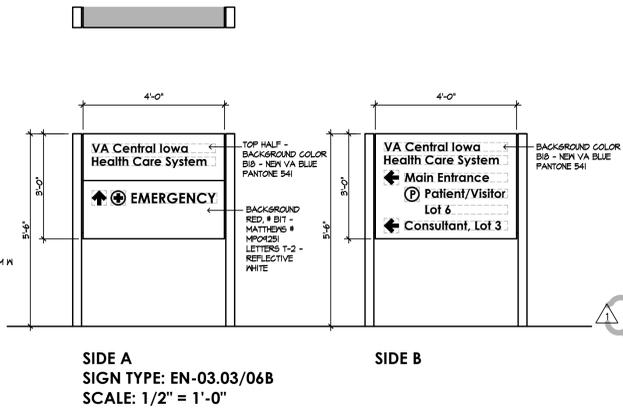

**EN-03.03A** NON-ILLUMINATED EXTERIOR SIGN  
Secondary Post and Panel  
**LOC. 07** REF. PAGE: AS.7  
REF. PAGE: AS.9 - FOR SITE PLACEMENT

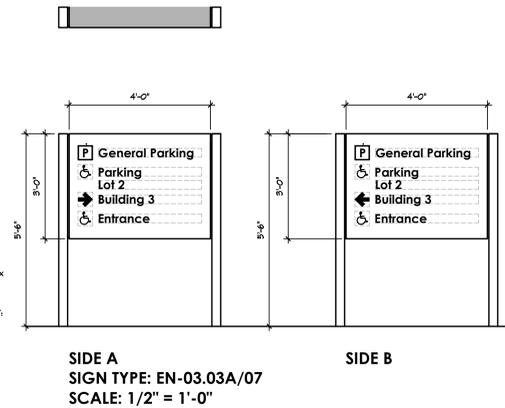

**EN-03.02B1** NON-ILLUMINATED EXTERIOR SIGN  
Primary Directional Post and Panel  
**LOC. 08** REF. PAGE: AS.6  
REF. PAGE: AS.9 - FOR SITE PLACEMENT

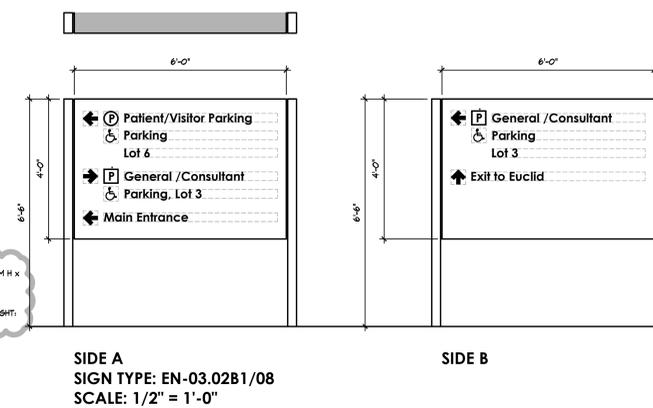


REMOVE EXISTING SIGNAGE  
**LOC. 9**



REMOVE EXISTING SIGNAGE  
**LOC. 10**




**EN-03.02B2** NON-ILLUMINATED EXTERIOR SIGN  
Primary Directional Post and Panel  
**LOC. 09** REF. PAGE: AS.6  
REF. PAGE: AS.9 - FOR SITE PLACEMENT

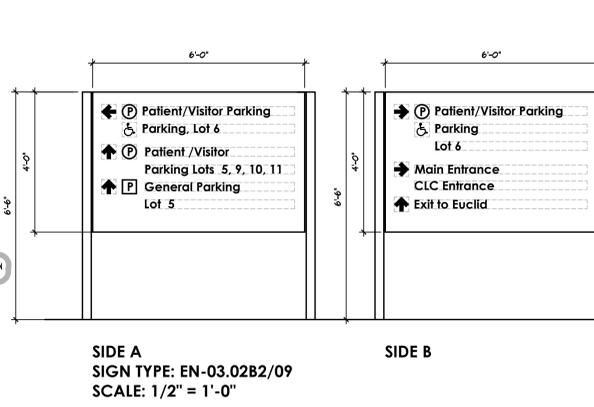


REMOVE EXISTING SIGNAGE LOC. 09

**EN-03.02A** NON-ILLUMINATED EXTERIOR SIGN  
Primary Directional Post and Panel  
**LOC. 10** REF. PAGE: AS.6  
REF. PAGE: AS.9 - FOR SITE PLACEMENT

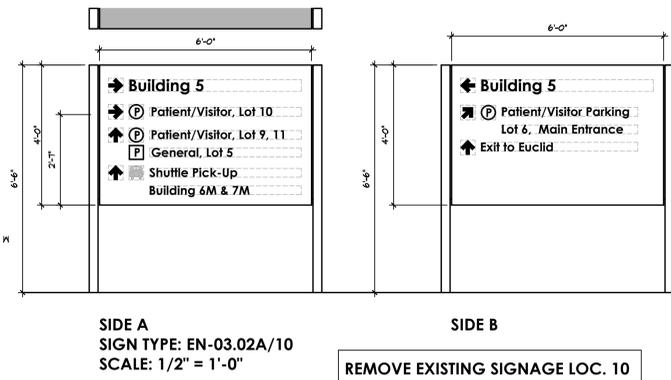

REMOVE EXISTING SIGNAGE LOC. 10

**EN-03.03B1** NON-ILLUMINATED EXTERIOR SIGN  
Secondary Post and Panel  
**LOC. 11** REF. PAGE: AS.6  
REF. PAGE: AS.10 - FOR SITE PLACEMENT

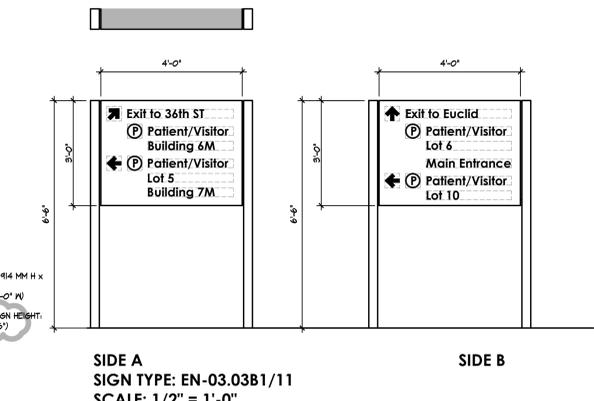

TYPICAL: GENERAL CONTRACTOR TO COORDINATE ALL SIGNS WITH EXISTING CONDITIONS, INCLUDING BUT NOT LIMITED TO ALL EXISTING IRRIGATION SYSTEMS, ELECTRICAL SERVICES AND UNDERGROUND UTILITIES PRIOR TO ANY CONSTRUCTION / DEMOLITION.

FOR BID

AMENDMENT #1	4/22/13	CONSULTANTS:	ARCHITECT/ENGINEERS:	Drawing Title	Project Title	Project Number
			21 Delta Engineers	SIGNAGE DETAILS	EXTERIOR SIGNAGE	636A6-12-101
			21 Delta Engineers, LLC 3824 North 108th Street Omaha, Nebraska 68164 PH: (402) 496-4115 Fax: (402) 493-2744		Location	Building Number
					DES MOINES VA MEDICAL CENTER	
					Date	Drawing Number
					FEBRUARY 22, 2013	AS-2
					Checked	Dwg. 3 of 19
					PJM	QL

VACIHCS  
3600 30th ST  
Des Moines, Iowa

three inches = one foot  
one and one half inches = one foot  
one inch = one foot  
three quarters inch = one foot  
one quarter inch = one foot  
one eighth inch = one foot  
one eighth inch = one foot





