
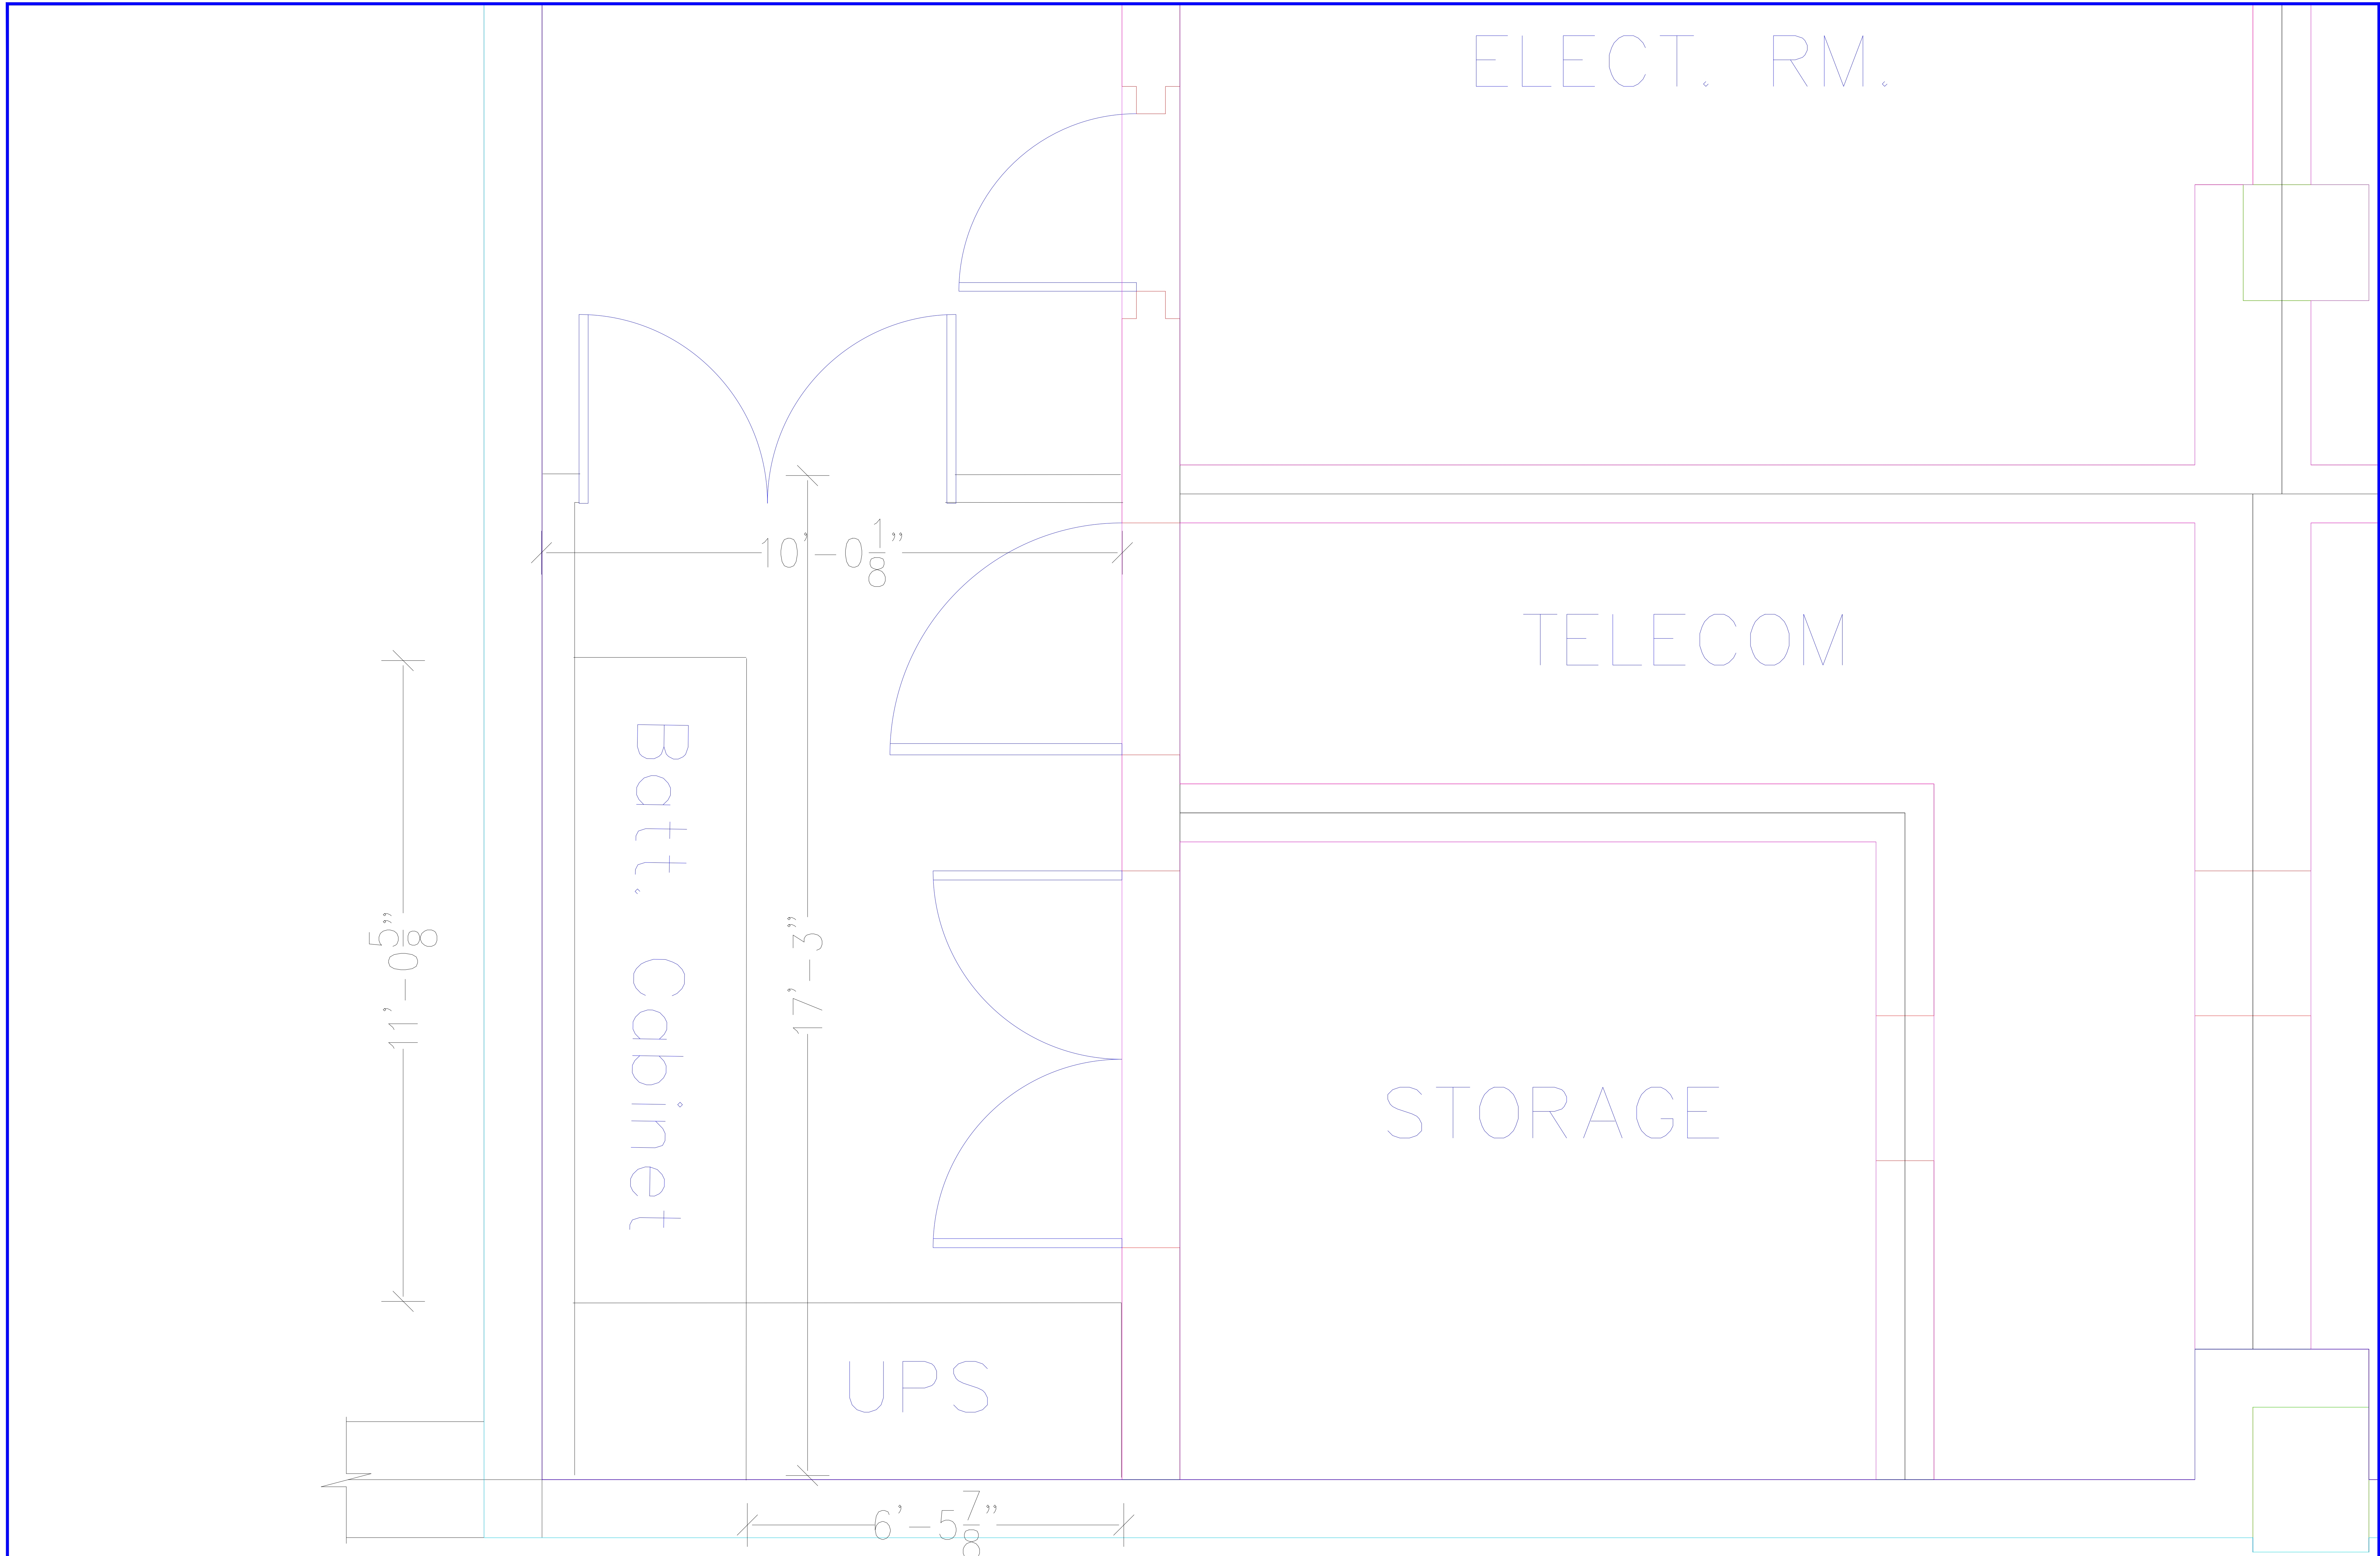
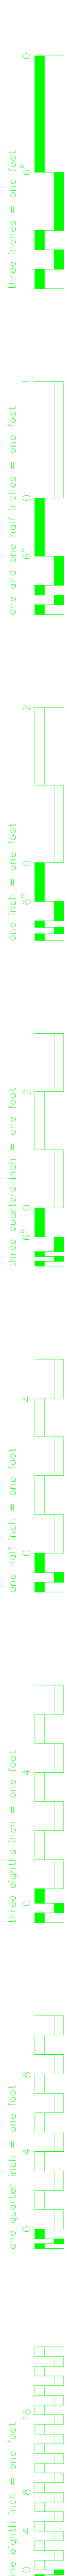
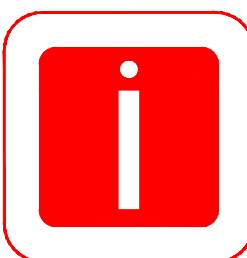


A
B
C
D
E
F

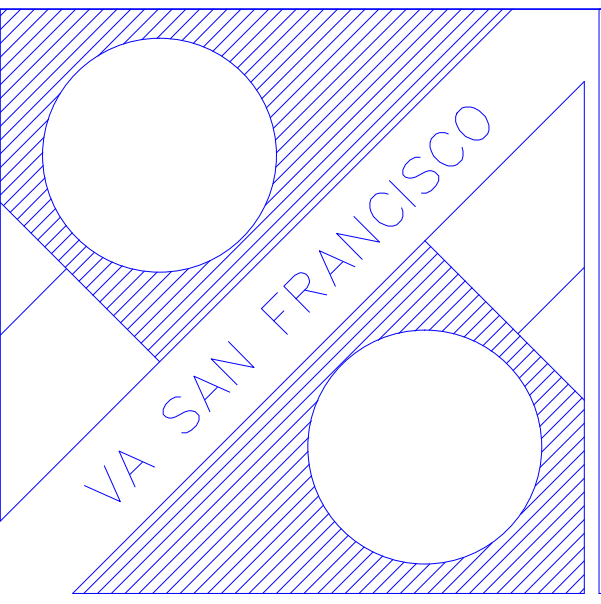

A
B
C
D
E
F

<div>Revisions</div>		<div>Date</div>		<div>Professional Seal</div>		<div><div>Indus Systems, Inc. 2352, Main Street, Concord MA 01742 Tel: 978-461-0555 www.indus-systems.com</div></div>		<div>Drawing Title</div> <div>BASEMENT FLOOR PLAN ARCHITECTURAL</div>		<div>Project Title</div> <div>AS-BUILT Drawings</div>		<div>Date</div> <div>04-17-2008</div>		<div>Project No.</div>		<div></div>		<div>Department of Veterans Affairs</div>	
								<div>Approved:</div>		<div>Building Number</div> <div>200</div>		<div>Checked</div>		<div>Drawn</div>		<div>Drawing No.</div>			
								<div>Approved:</div>		<div>Location</div> <div>VA SAN FRANCISCO</div>									

1 2 3 4 5 6 7 8 9