
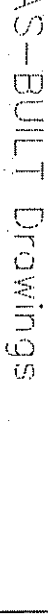
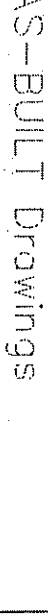



<div> <div>  <p> Indus Systems, Inc. 2352, Main Street, Concord MA 01742 Tel: 978-461-0555 www.indus-systems.com </p> </div> <div> <p> Drawing Title FIRST FLOOR PLAN FIRE PROTECTION </p> </div> </div>		<div> <div> <p> Project Title AS-BUILT Drawings </p> </div> <div> <p> Building Number 23 </p> </div> <div> <p> Checked <input type="checkbox"/> </p> </div> <div> <p> Drawn <input type="checkbox"/> </p> </div> </div>		<div> <div> <p> Date 05-06-2009 </p> </div> <div> <p> Project No. <input type="text"/> </p> </div> </div>		<div> <div> <p> Drawing No. <input type="text"/> </p> </div> </div>	
<div> <div> <p> Approved: <input type="text"/> </p> </div> </div>		<div> <div> <p> Location VAMC LEBANON P.A. </p> </div> </div>		<div> <div>  </div> </div>		<div> <div>  </div> </div>	
<div> <div> <p> Professional Seal <input type="text"/> </p> </div> </div>		<div> <div> <p> Revisions <input type="text"/> </p> </div> </div>		<div> <div> <p> Date <input type="text"/> </p> </div> </div>		<div> <div>  </div> </div>	