


# SHEET NOTES:

- DWH'S FURNISHED AS PART OF PLUMBING WORK (SHOWN FOR REFERENCE ONLY). SEE SHEET P3.1.1. MECH TO CONNECT & PIPE FOR STEAM & CONDENSATE.
- STEAM VALVE FURNISHED WITH DWH, MECH TO INSTALL, SEE 3/H9.1.5.
- STEAM TRAP OR ORIFICE UNION FURNISHED WITH DWH, MECH TO INSTALL, SEE 3/H9.1.5.
- EMD SET, SEE 11/H9.1.5.

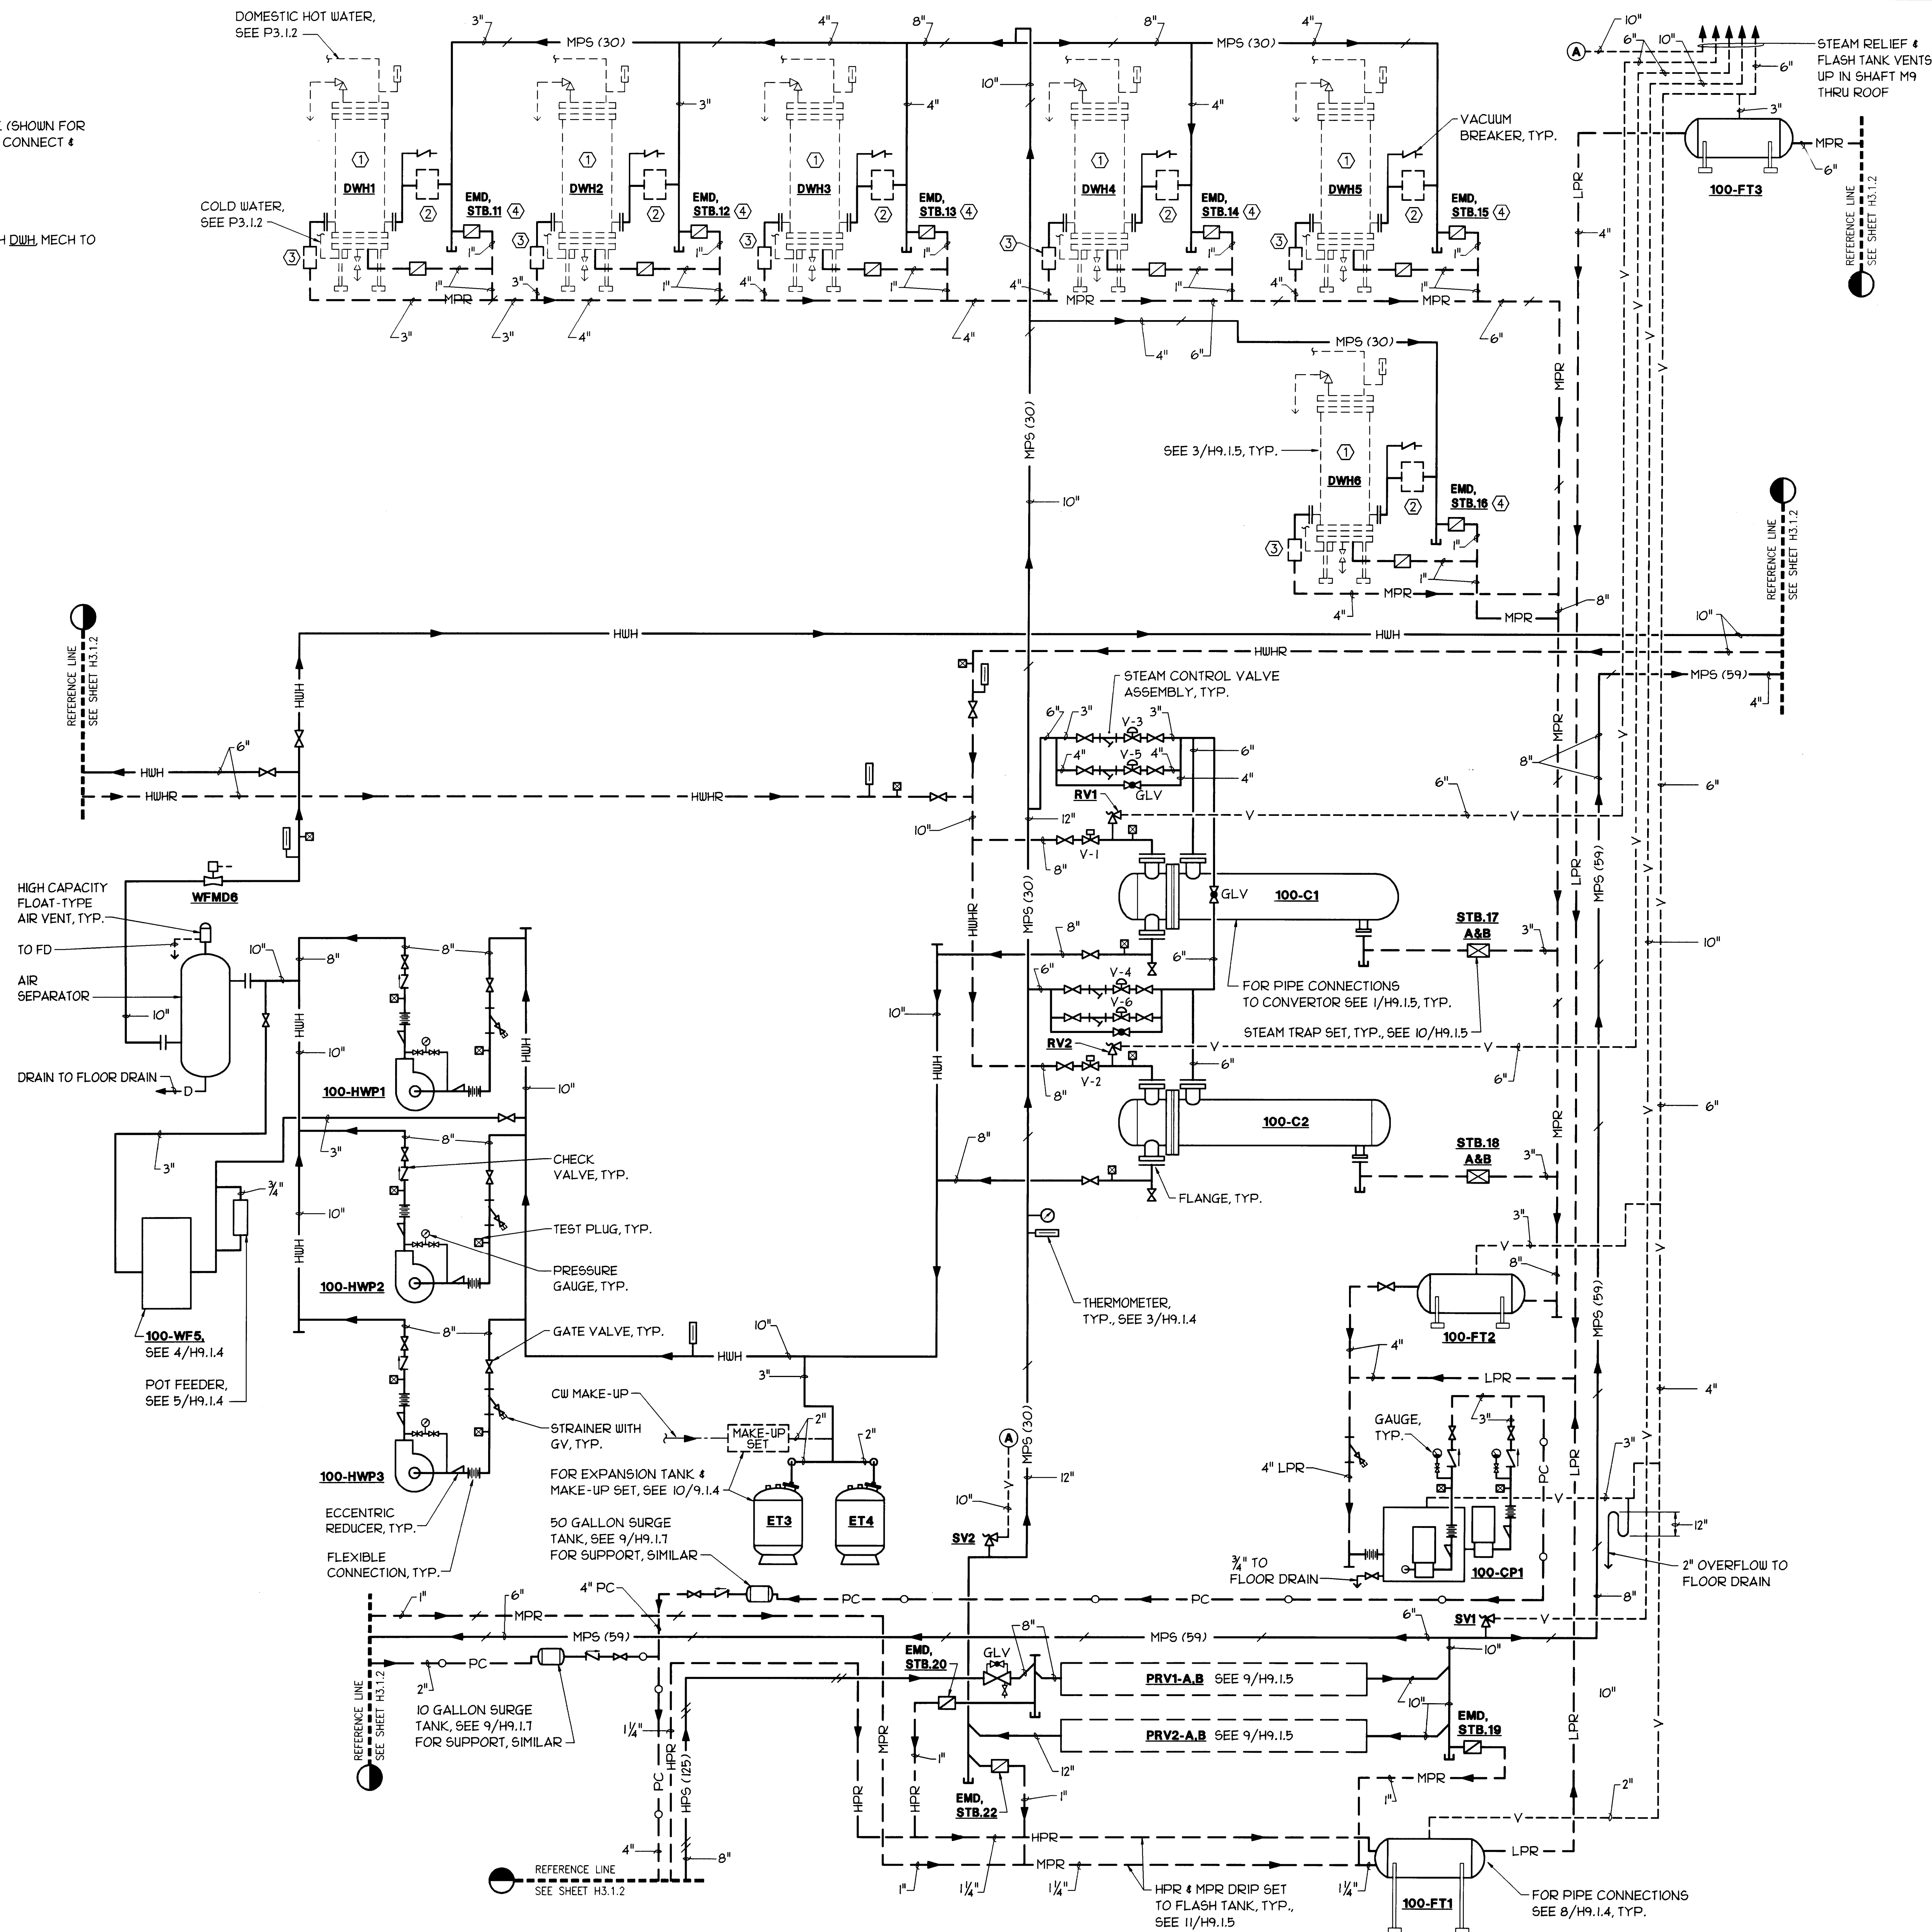

Western Team Director

Approved Project Director

**ARCHITECT**  
The Ratchiff Architects  
5556 Doyle Street  
Emeryville, CA 94608  
P.O. Box 1022  
Berkeley, CA 94701  
(510) 652-1972

**ASSOCIATE ARCHITECT**  
Stone, Marraocini and Patterson  
One Market Plaza  
Spear Street Tower, Suite 400  
San Francisco, CA 94105  
(415) 227-0100

**CONSULTANTS**  
**Structural Engineers**  
H.J. Degenkolb Associates  
**Mechanical Engineers**  
Capital Engineering Consultants, Inc.  
**Electrical Engineers**  
The Engineering Enterprise  
**Cost Estimator**  
Adamson Associates  
**Landscape Design/**  
**Land Planning**  
Orni Lang Associates, Inc.  
**Civil Engineer**  
Sandis and Associates, Inc.  
**Elevator Consultant**  
Syka and Hennessy  
**Fire Protection**  
Rolf Jensen and Associates  
**Food Service Consultant**  
Cini-Little International, Inc.

**Capital Engineering Consultants, Inc.**  
Berkeley, California 94701  
DESIGNER/DRAWER PROJECT NO.

**RECORD DRAWINGS** 8-14-98

Revisions Date

Location VA Medical Center Palo Alto, CA

Project Title  
**REPLACE CLINICAL/ BED TOWER FOR SEISMIC CORRECTIONS**

**FULLY SPRINKLERED**

TRA Project No. 93007 Checked TGI Drawn DA

Drawing Title  
**HEATING WATER & STEAM PIPING FLOW DIAGRAM**

Scale NONE

VA Project No. 640-042G Building Number 100

Date 14 AUG 1998 DRAWING NO. H7.3.1

Dwg of