


KEY PLAN  
SCALE 1"=100'-0"

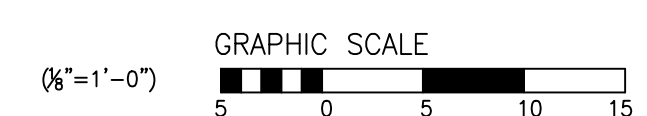

G.M. & S. BUILDING  
LEFT & CENTER WING FIRST FLOOR PLUMBING PLAN  
SCALE 1/8"=1'-0"

BLDG 2			
REVISION	DATE	DESCRIPTION	BY
1	8-14-75	STA LET "AS BUILT"	ERIN
DRAWN BY: C.C.I.-F.B.M.-C.H.		WALTER HOOK & ASSOCIATES, INC.	
CHECKED BY: C.C.I.-F.B.M.-C.H.		W.M. HENLEY DETTRICK, INC.	
SUBMITTED:		W.M. C. OLSEN	
APPROVED:		ARCHITECTS ENGINEERS	
CHIEF ENGINEER		IN ASSOCIATION WITH	
V.A. PROJECT NO.2448		NEERGAARD, CRAIG & McCAGG'	
		HOSPITAL CONSULTANTS-NEW YORK, N.Y.	
		VETERANS ADMINISTRATION HOSPITAL	
		SALISBURY, NORTH CAROLINA	
		960 BED NP HOSPITAL	
		G. M. & S. BUILDING, LEFT & CENTER	
		WINGS, FIRST FLOOR PLUMBING PLAN	
		DATE: DEC. 9, 1949	
		SCALE: AS NOTED	
		DRAWING NUMBER	
		VA44-32-05-P3	
		NUMBER OF SHEETS	
		186	
		471	