

1. E85 FUEL ONLY
2. OPERATOR TO DETERMINE AMOUNT OF FUEL NEEDED TO FILL TO 85% LEVEL.
3. ATTACH FUEL FILL HOSE TO FILL ADAPTOR. ATTACH VAPOR RECOVERY HOSE.
4. COMMENCE FILLING. AT 85% FILLED: OVERFILL PREVENTION VALVE CLOSSES, ALARM SOUNDS / LIGHT FLASHES - **STOP FILLING!** PRESS SILENCE BUTTON.
5. AT 90% FILLED: ALARM SOUNDS, LIGHT FLASHES. **STOP FILLING!** OVERFILL CONDITION EXISTS, CONTACT FACILITY MANAGER.
6. REMOVE FUEL HOSE FROM ADAPTOR AND REPLACE CAP. REMOVE VAPOR RECOVERY HOSE AND REPLACE CAP.
7. CLEAN FILL PORT.

NOTES:

1. BLACK TEXT .50" HIGH. WHITE BACKGROUND 1.0" BEYOND TEXT.
2. FILL INTRUCTIONS TO BE PLACED AT FILL PORT LIP AND OVERFILL ALARM PANEL.

6

DFS 4.0

MAIN TANK FILL INSTRUCTIONS

SCALE: NONE

VEHICLE FUELING INSTRUCTIONS

1. BE SURE VEHICLE IS E85 FUEL COMPATIBLE. REMOVE TANK CAP.
2. UNLOCK NOZZLE. REMOVE FROM DESPENSER.
3. TURN ON DISPENSER. START FILLING.
4. WHEN DISPENSER STOPS PUMPING, STOP. **DO NOT TOP OF TANK!** TANK WILL BE OVER FILLED!
5. TURN OFF DISPENSER.
6. REMOVE FUEL HOSE, REPLACE TANK CAP. RETURN HOSE TO DISPENSER AND LOCK IT.
7. RE MOVE LOG SHEET FROM CABINET, FILLOUT LOG SHEET. RETURN SHEET TO CABINET AND LOCK CABINET.

NOTES:

1. BLACK TEXT .50" HIGH. WHITE BACKGROUND 1.0" BEYOND TEXT.
2. FILL INTRUCTIONS TO BE PLACED ON DISPENSER FACING FUELING AREA


(5201.6.3)

7

DFS 4.0

VEHICLE FUELING INSTRUCTIONS

SCALE: NONE

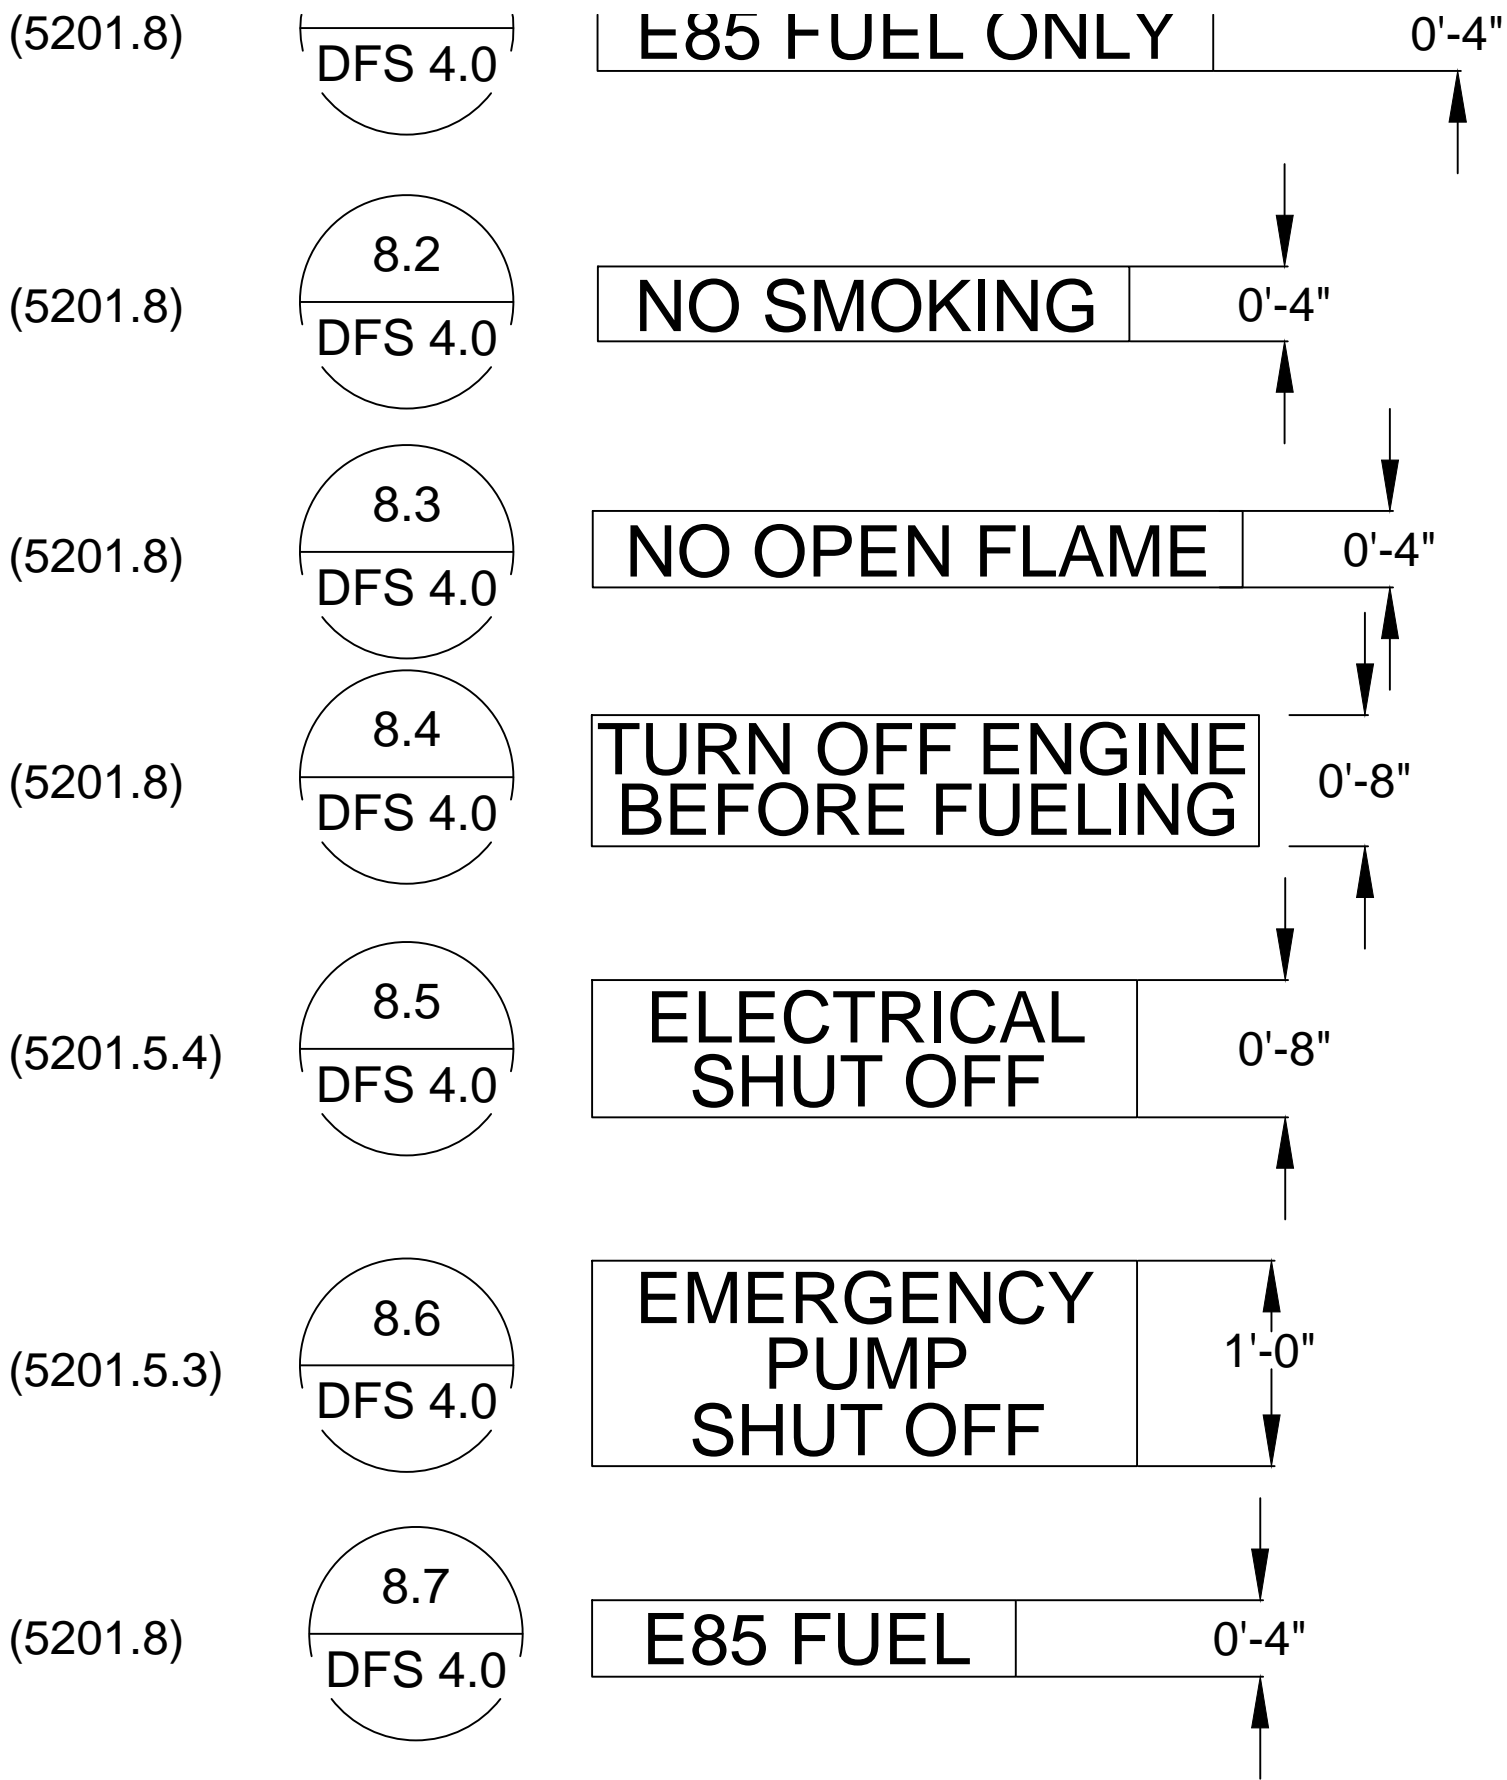

NOTES: 3" HIGH BLACK LETTERS  
BACKGROUND: WHITE, HEGHT AS INDICATED,  
EXTEND 2.0" BEYOND END OF TEXT

8.X

DFS 4.0

LETTER SIGN

SCALE: NONE

AS BUILT

09/17/08

FUEL OIL SYSTEMS

1558 "B" STREET HAYWARD CALIFORNIA  
PH 510 727 6701 FAX 510 888 1755  
WWW.FUELOILSYSTEMS.NET, EMAIL: INFO@FUELOILSYSTEMS.NET

E85 DISPENSING SYSTEM  
SIGNAGE DETAILS

REVISION: 0

SPEC:

SHT 2 OF 2

SUBMITTAL:

JOB.: SAN FRANCISCO VA E85

REF DWG.:

SCALE: NONE

APPROVED: CA HASKINS