


1 PARTIAL ELEVENTH FLOOR PLAN - DUCTWORK DEMOLITION
SCALE: 1/8" = 1'-0"

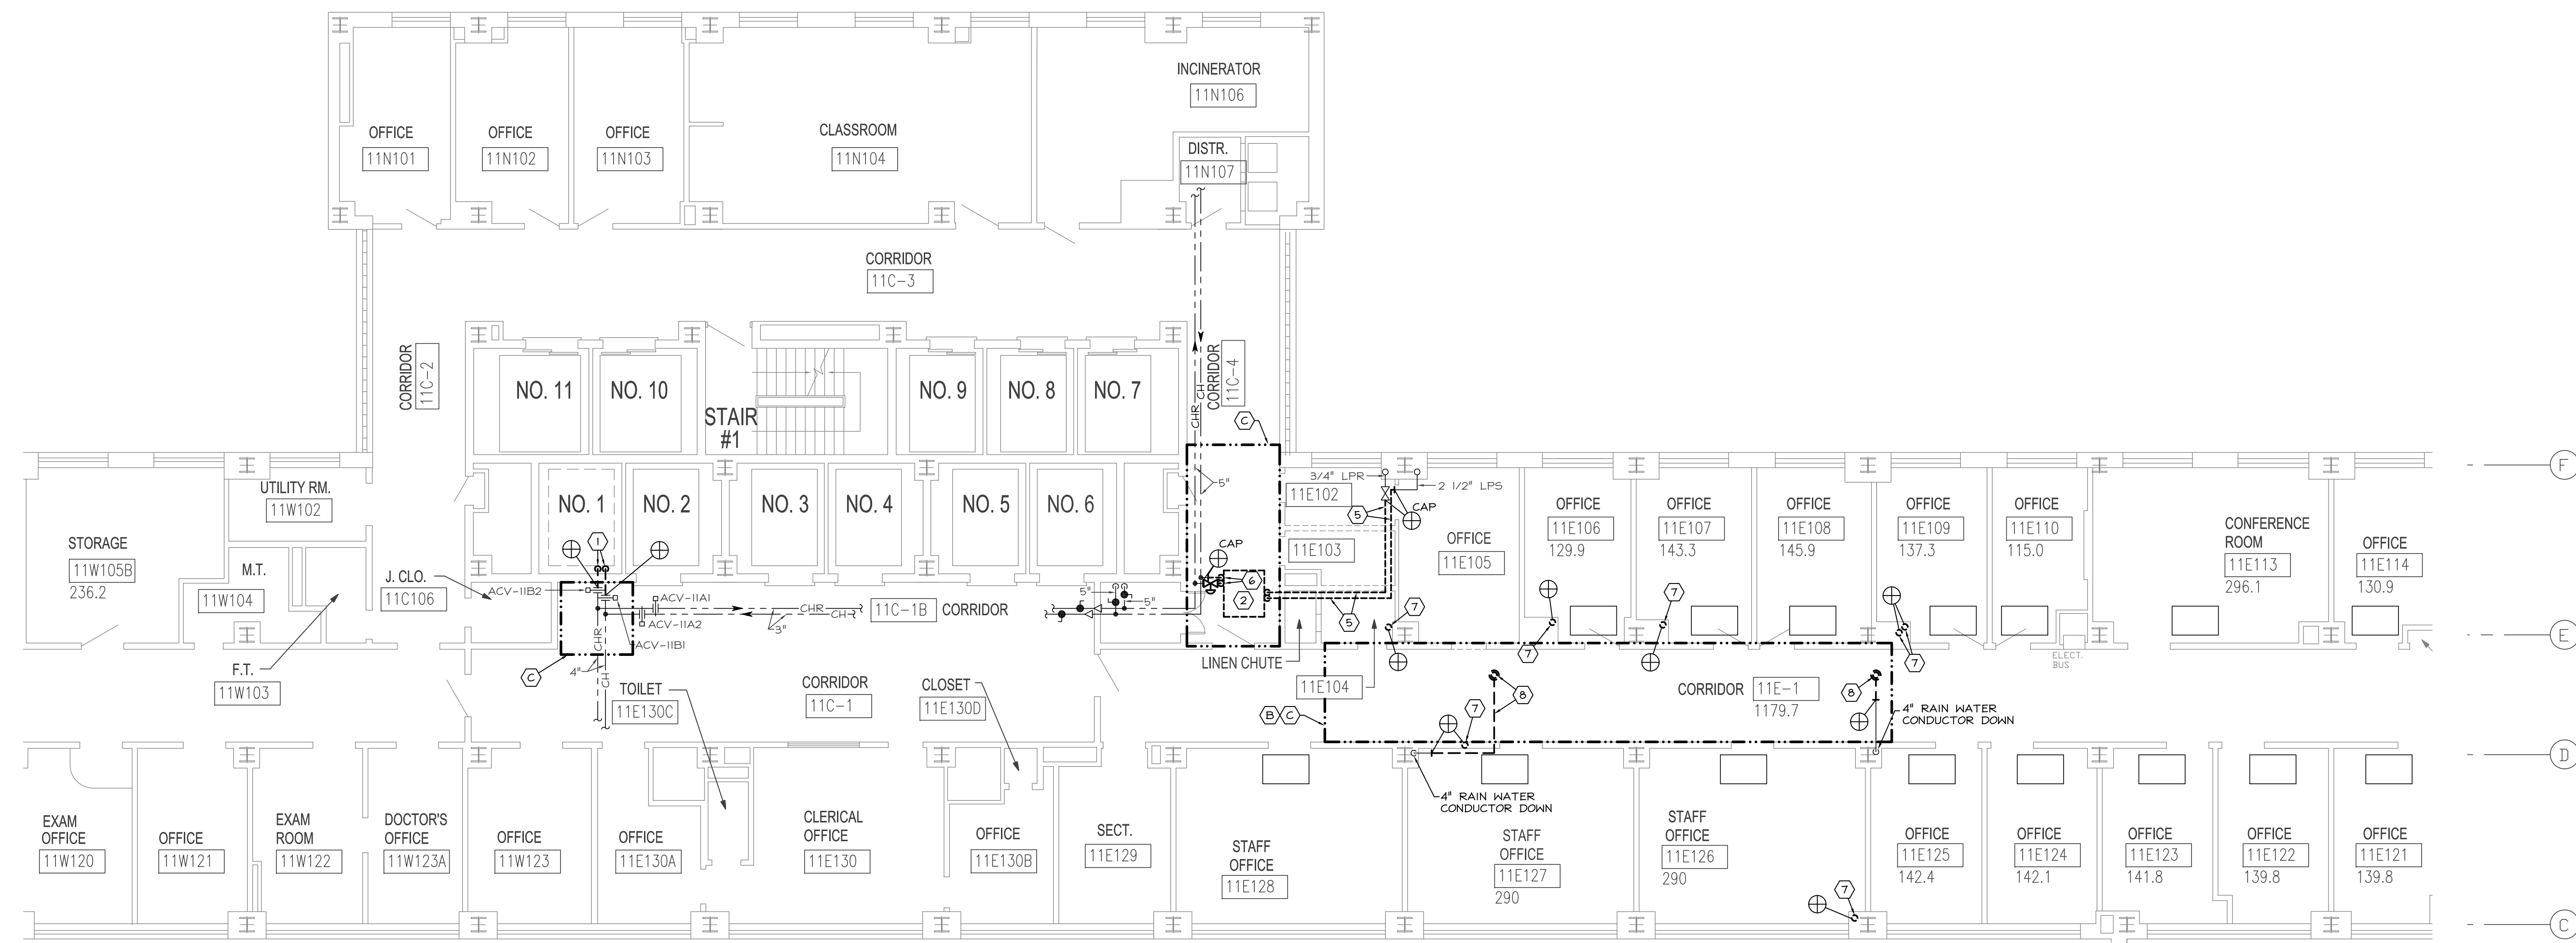


2 PARTIAL ELEVENTH FLOOR PLAN - PIPING DEMOLITION
SCALE: 1/8" = 1'-0"


PHASING AND GENERAL NOTES:

- REMOVE TOP SECTION OF WALL AS REQUIRED FOR INSTALLATION OF NEW SUPPLY AND RETURN DUCTWORK RISERS. FINISH CUT OPENINGS IN ORDER TO PROVIDE A CLEAN AND COMPLETE INSTALLATION. NEW CONSTRUCTION AND FINISHES SHALL MATCH EXISTING.
- ALL WORK IN THIS AREA SHALL BE DONE DURING SECOND SHIFT. CONTRACTOR SHALL SCHEDULE UNOCCUPIED TIMES WITH THE VA.
- PROVIDE LEVEL 2 I.C.R.A. BARRIER IN THIS AREA TO CONTAIN DUST AS REQUIRED.
- REMOVE CEILING IN ITS ENTIRETY IN ORDER TO FACILITATE INSTALLATION OF NEW SUPPLY AND RETURN DUCTWORK RISERS. DISCONNECT EXISTING SPRINKLER AND LIGHTING FIXTURES AND RELOCATE AS NEEDED FOR DUCTWORK INSTALLATION.
- CUT OPENING IN WALL FOR NEW DOOR AND ASSOCIATED HARDWARE. DOOR AND HARDWARE SHALL MATCH EXISTING.

DEMOLITION NOTES:

- REMOVE ALL EXISTING 4" CHILLED WATER PIPING FROM POINT OF DISCONNECT INDICATED ON THIS FLOOR BACK TO 4" RISERS IN 10TH FLOOR CEILING. EXTEND 4" RISERS UP THROUGH ROOF. REFER TO PIPING PLANS ON DRAWINGS H-3 & H-4 FOR ADDITIONAL INFORMATION.
- REMOVE EXISTING AIR HANDLING UNIT IN ITS ENTIRETY INCLUDING ALL HANGERS, POWER AND CONTROL WIRING BACK TO POINT OF ORIGIN.
- DISCONNECT AND REMOVE SECTION OF SUPPLY AIR DUCTWORK IN ITS ENTIRETY BACK TO POINT OF DISCONNECT. FOR RELATED NEW WORK IN THIS AREA, SEE PLAN H-3.
- DISCONNECT AND REMOVE OUTSIDE AIR DUCTWORK IN ITS ENTIRETY.
- DISCONNECT AND REMOVE STEAM PIPING ASSOCIATED WITH DEPOLISHED AIR HANDLING UNIT BACK TO POINT OF DISCONNECT. REMOVE ALL ASSOCIATED HANGERS, SUPPORTS, AND VALVES.
- DISCONNECT AND REMOVE CHILLED WATER PIPING ASSOCIATED WITH DEPOLISHED AIR HANDLING UNIT BACK TO POINT OF DISCONNECT. REMOVE ALL ASSOCIATED HANGERS, SUPPORTS, AND VALVES.
- DISCONNECT VENT PIPING BELOW ROOF AND REMOVE VENT UP THROUGH ROOF. RELOCATE VENT PIPING AS SHOWN ON DRAWING H-3. PATCH AND SEAL EXISTING ROOF OPENING.
- DISCONNECT RAIN CONDUCTOR PIPING AND REMOVE ASSOCIATED ROOF DRAIN AS SHOWN. RELOCATE ROOF DRAIN AND EXTEND RAIN CONDUCTOR PIPING AS SHOWN ON DRAWING H-3. PATCH AND SEAL EXISTING ROOF OPENING.

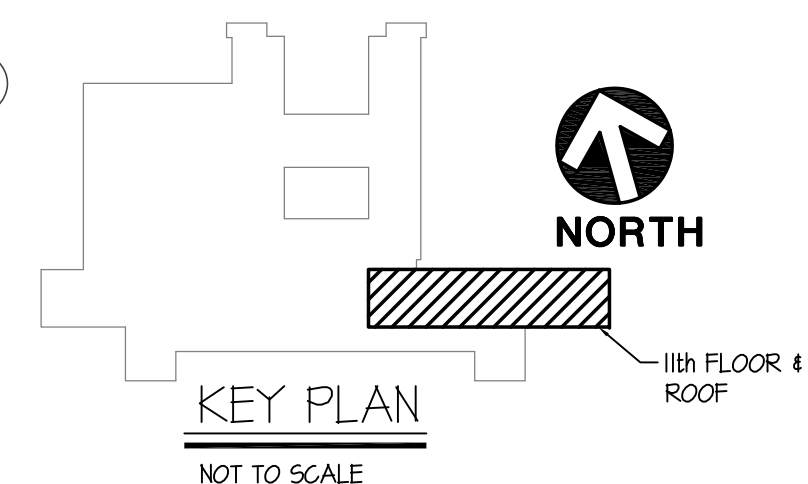

REVISIONS:		DATE	
RECORD DRAWINGS		12/15/08	
		<div>VAPHS · UD</div> <div>University Drive</div> <div>Pittsburgh, PA 15240</div>	
