




1 PARTIAL ROOF PLAN - HVAC NEW WORK - DUCTWORK
SCALE: 1/8" = 1'-0"

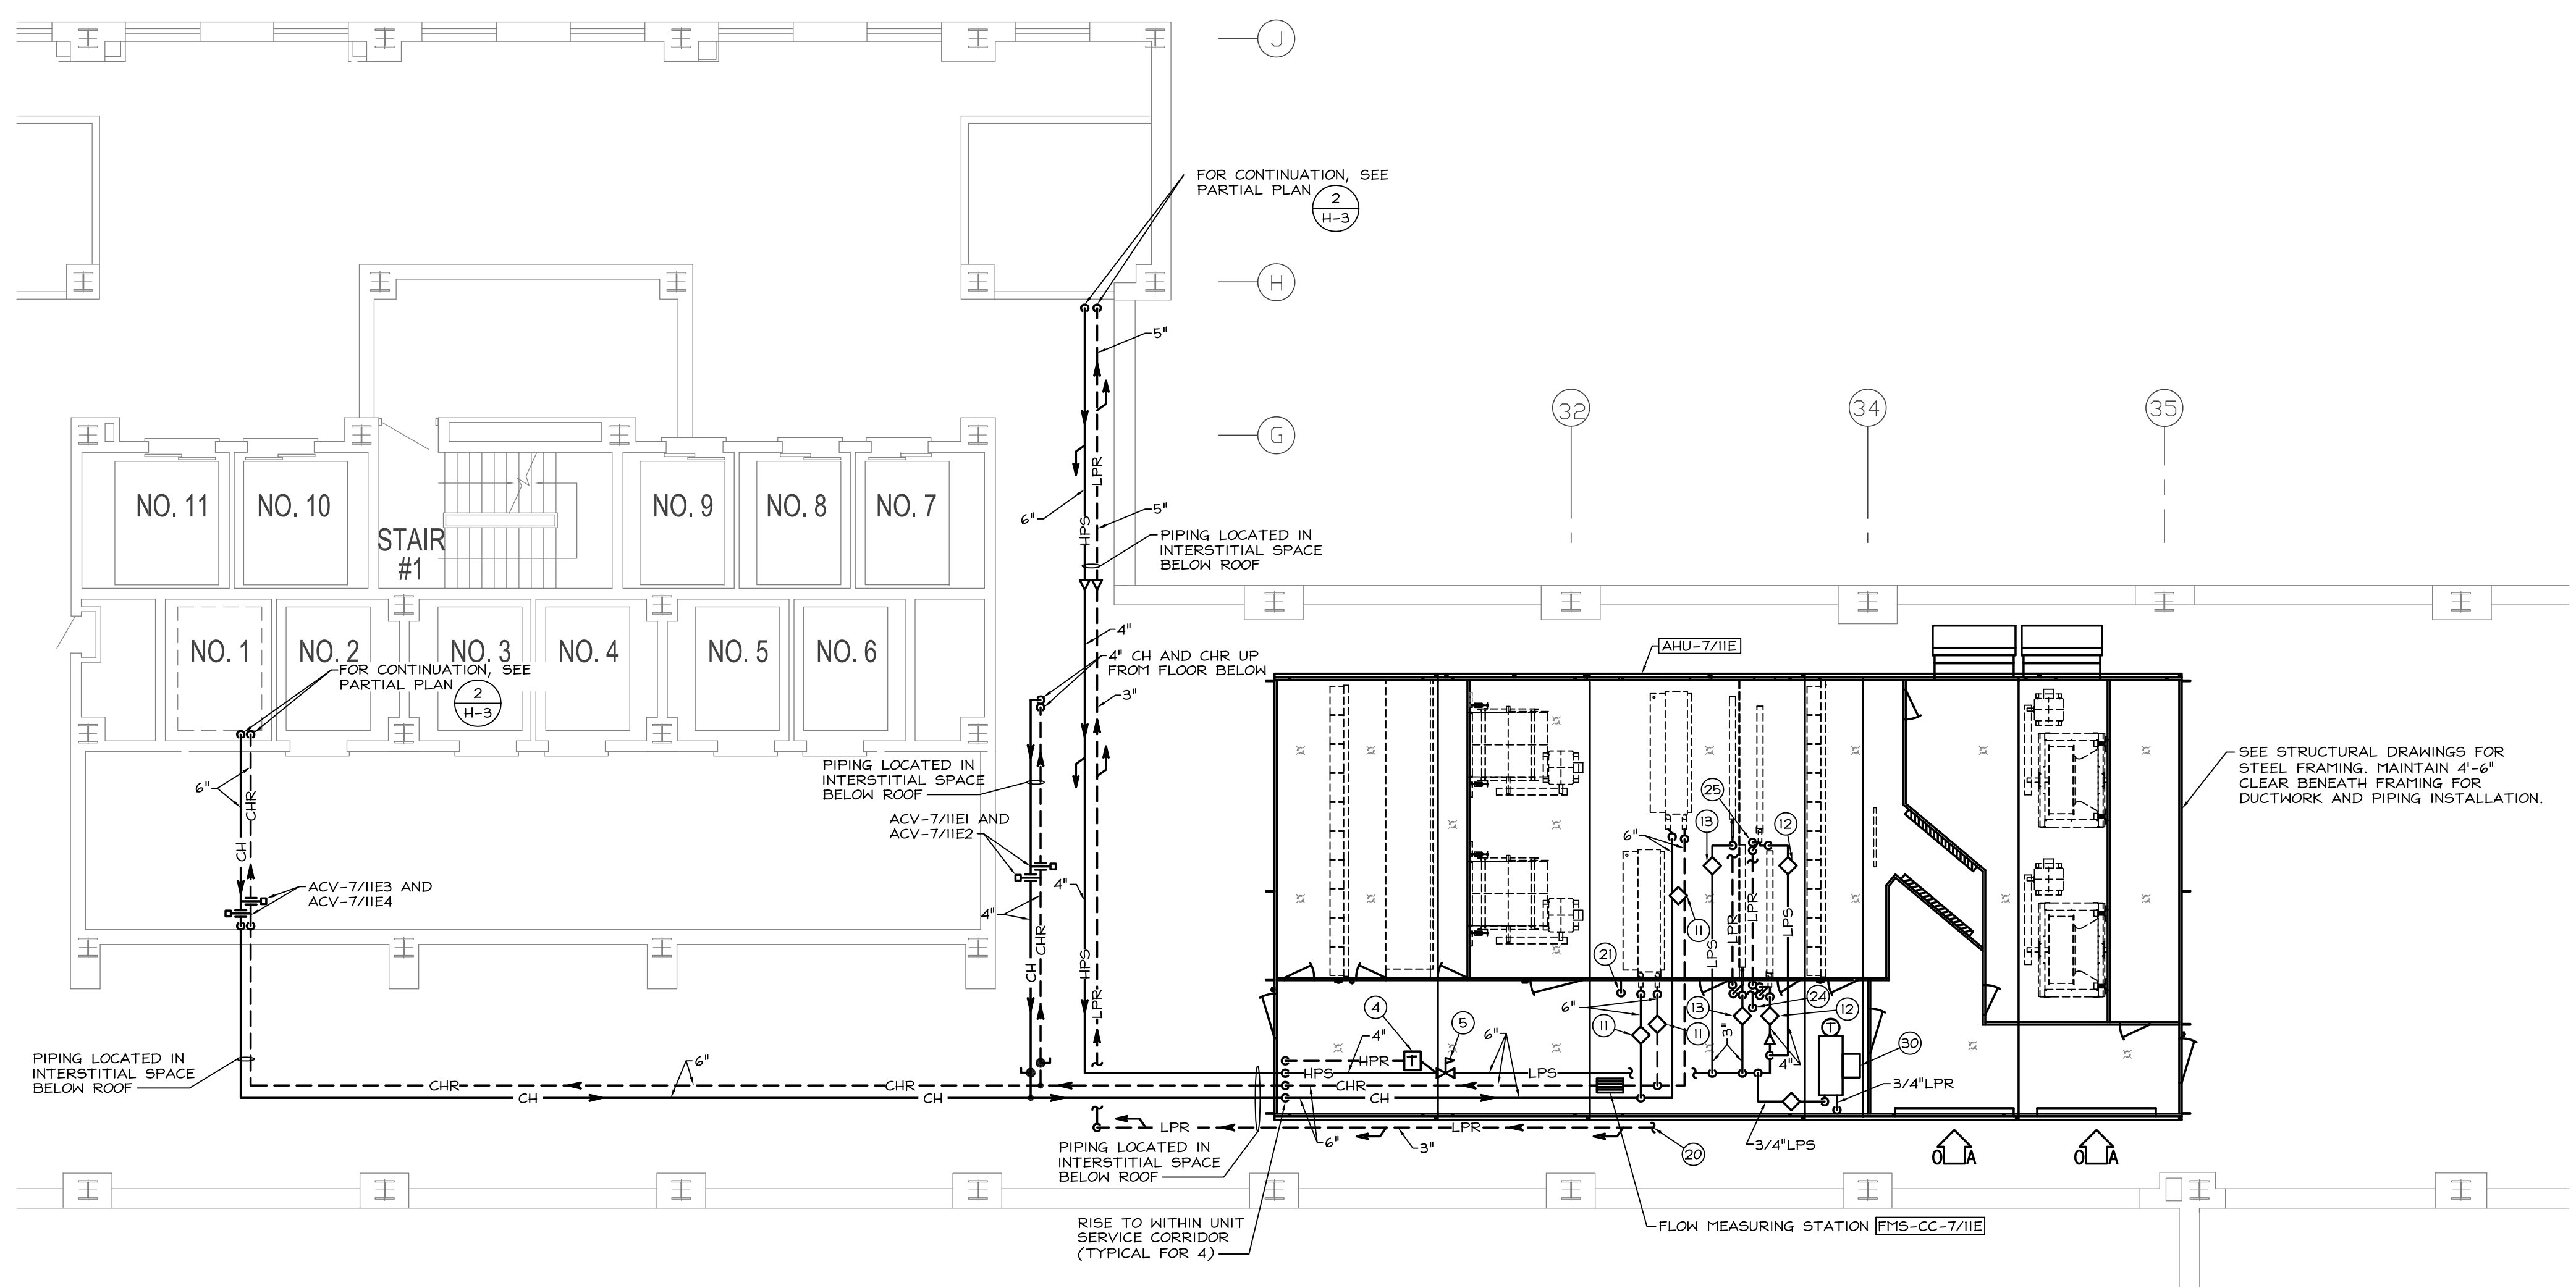

2 PARTIAL ROOF PLAN - HVAC NEW WORK - UPPER PIPING
SCALE: 1/8" = 1'-0"

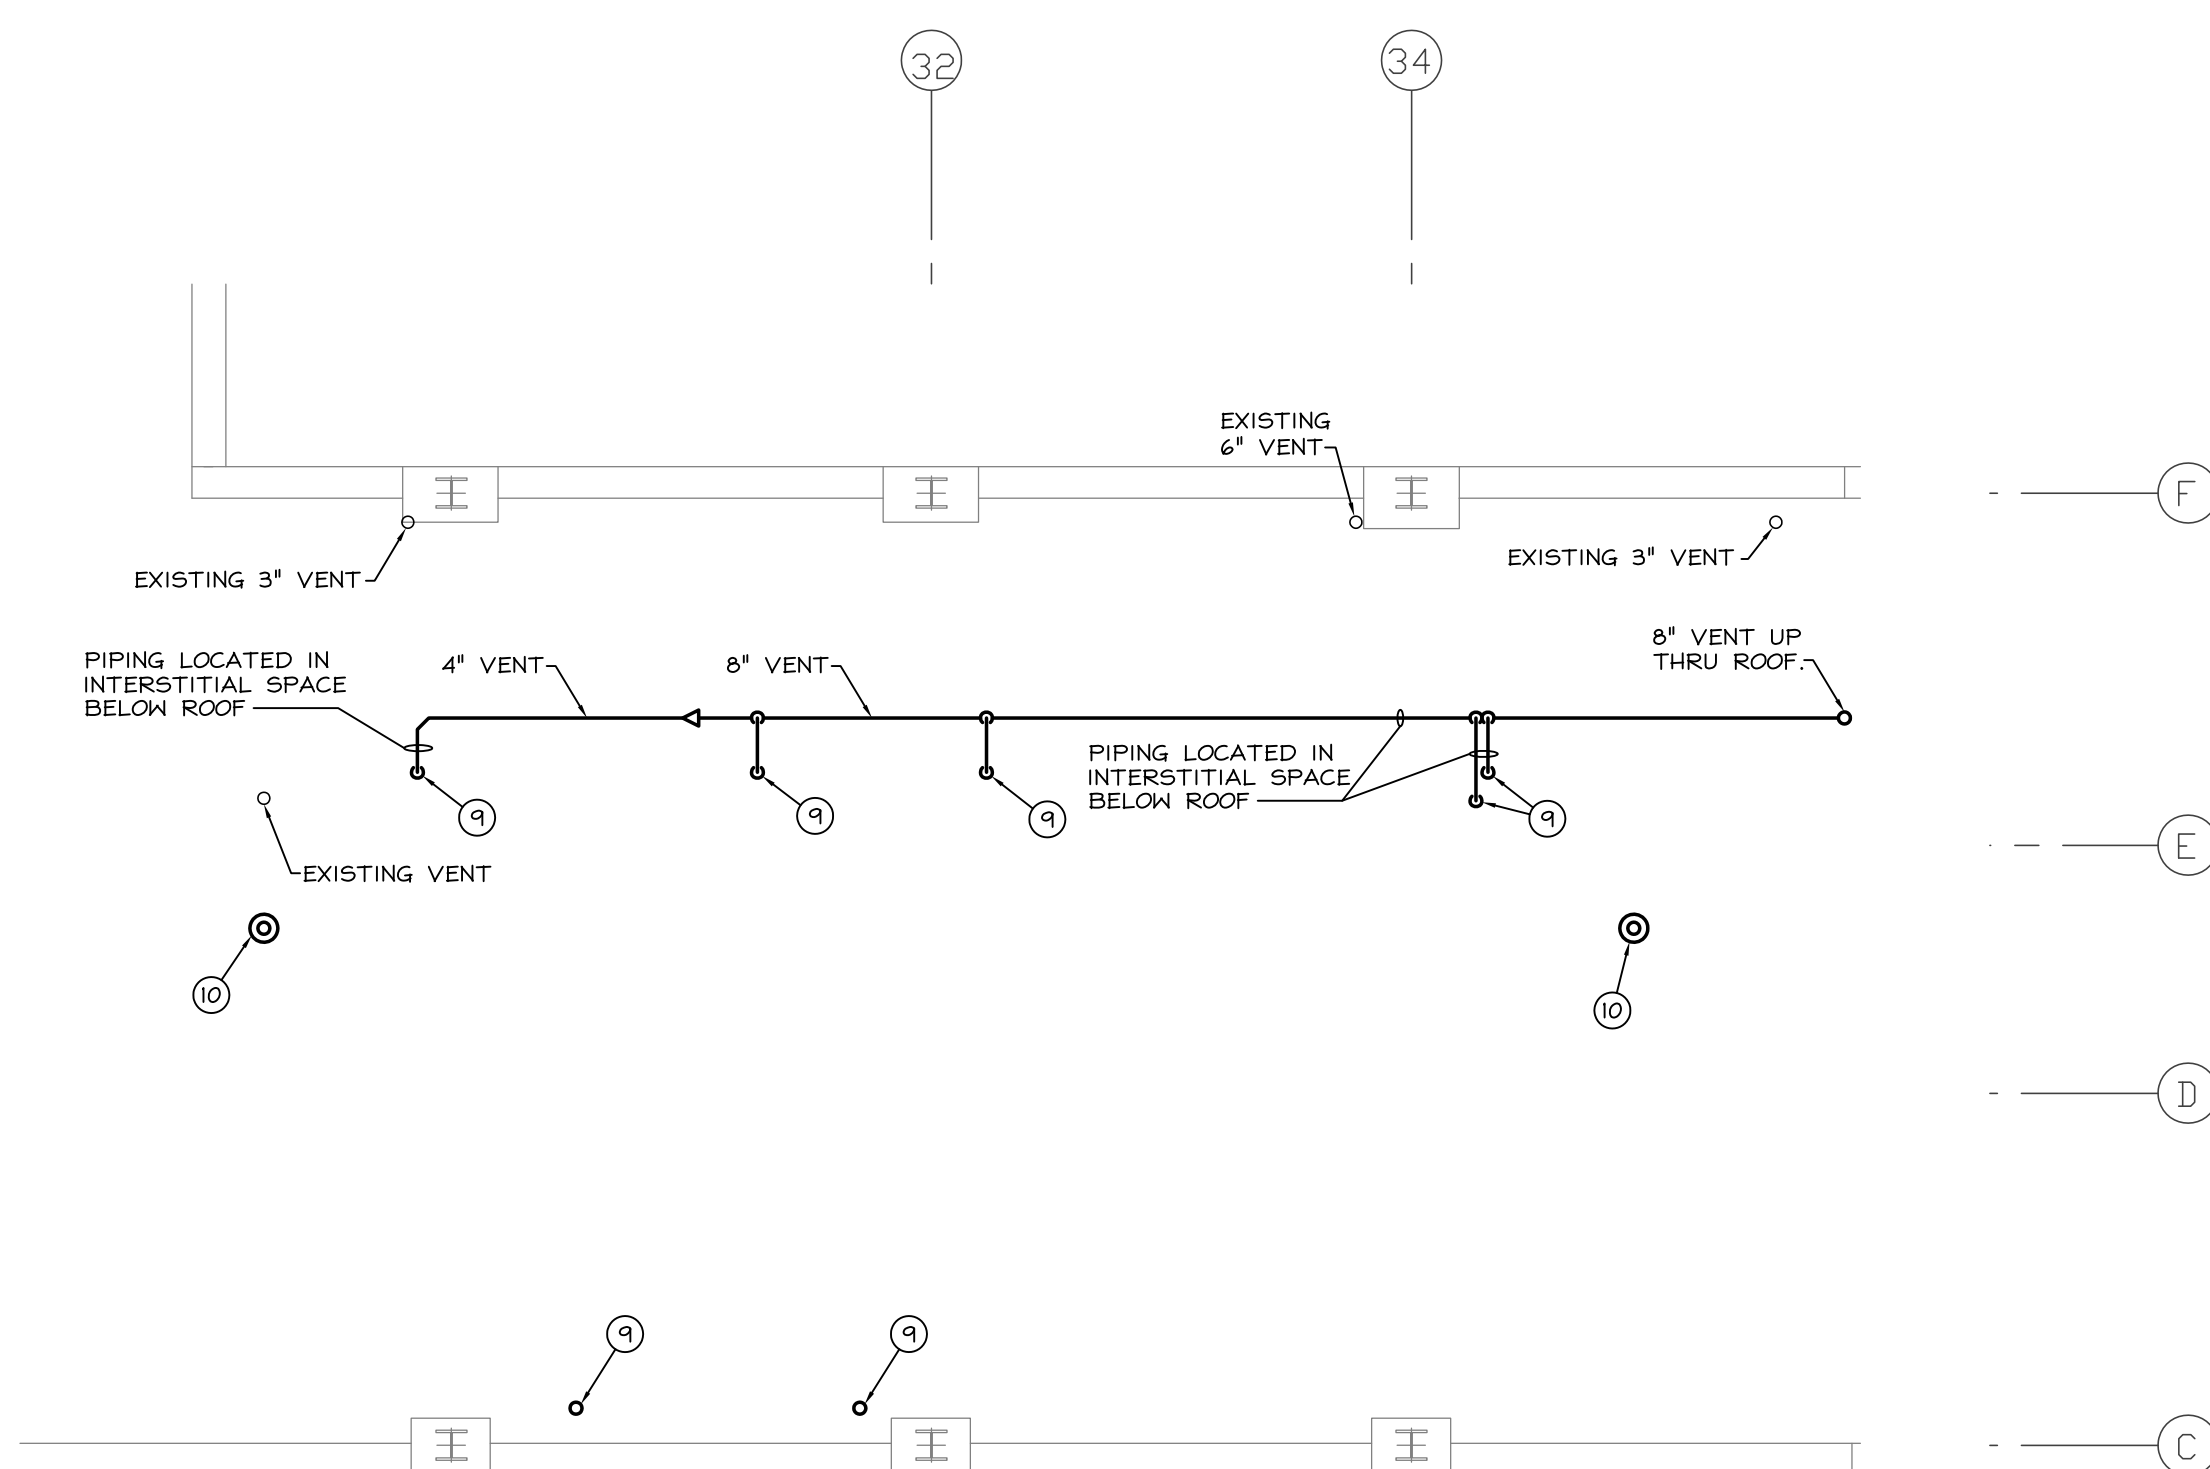

3 PARTIAL ROOF PLAN - PLUMBING NEW WORK
SCALE: 1/8" = 1'-0"

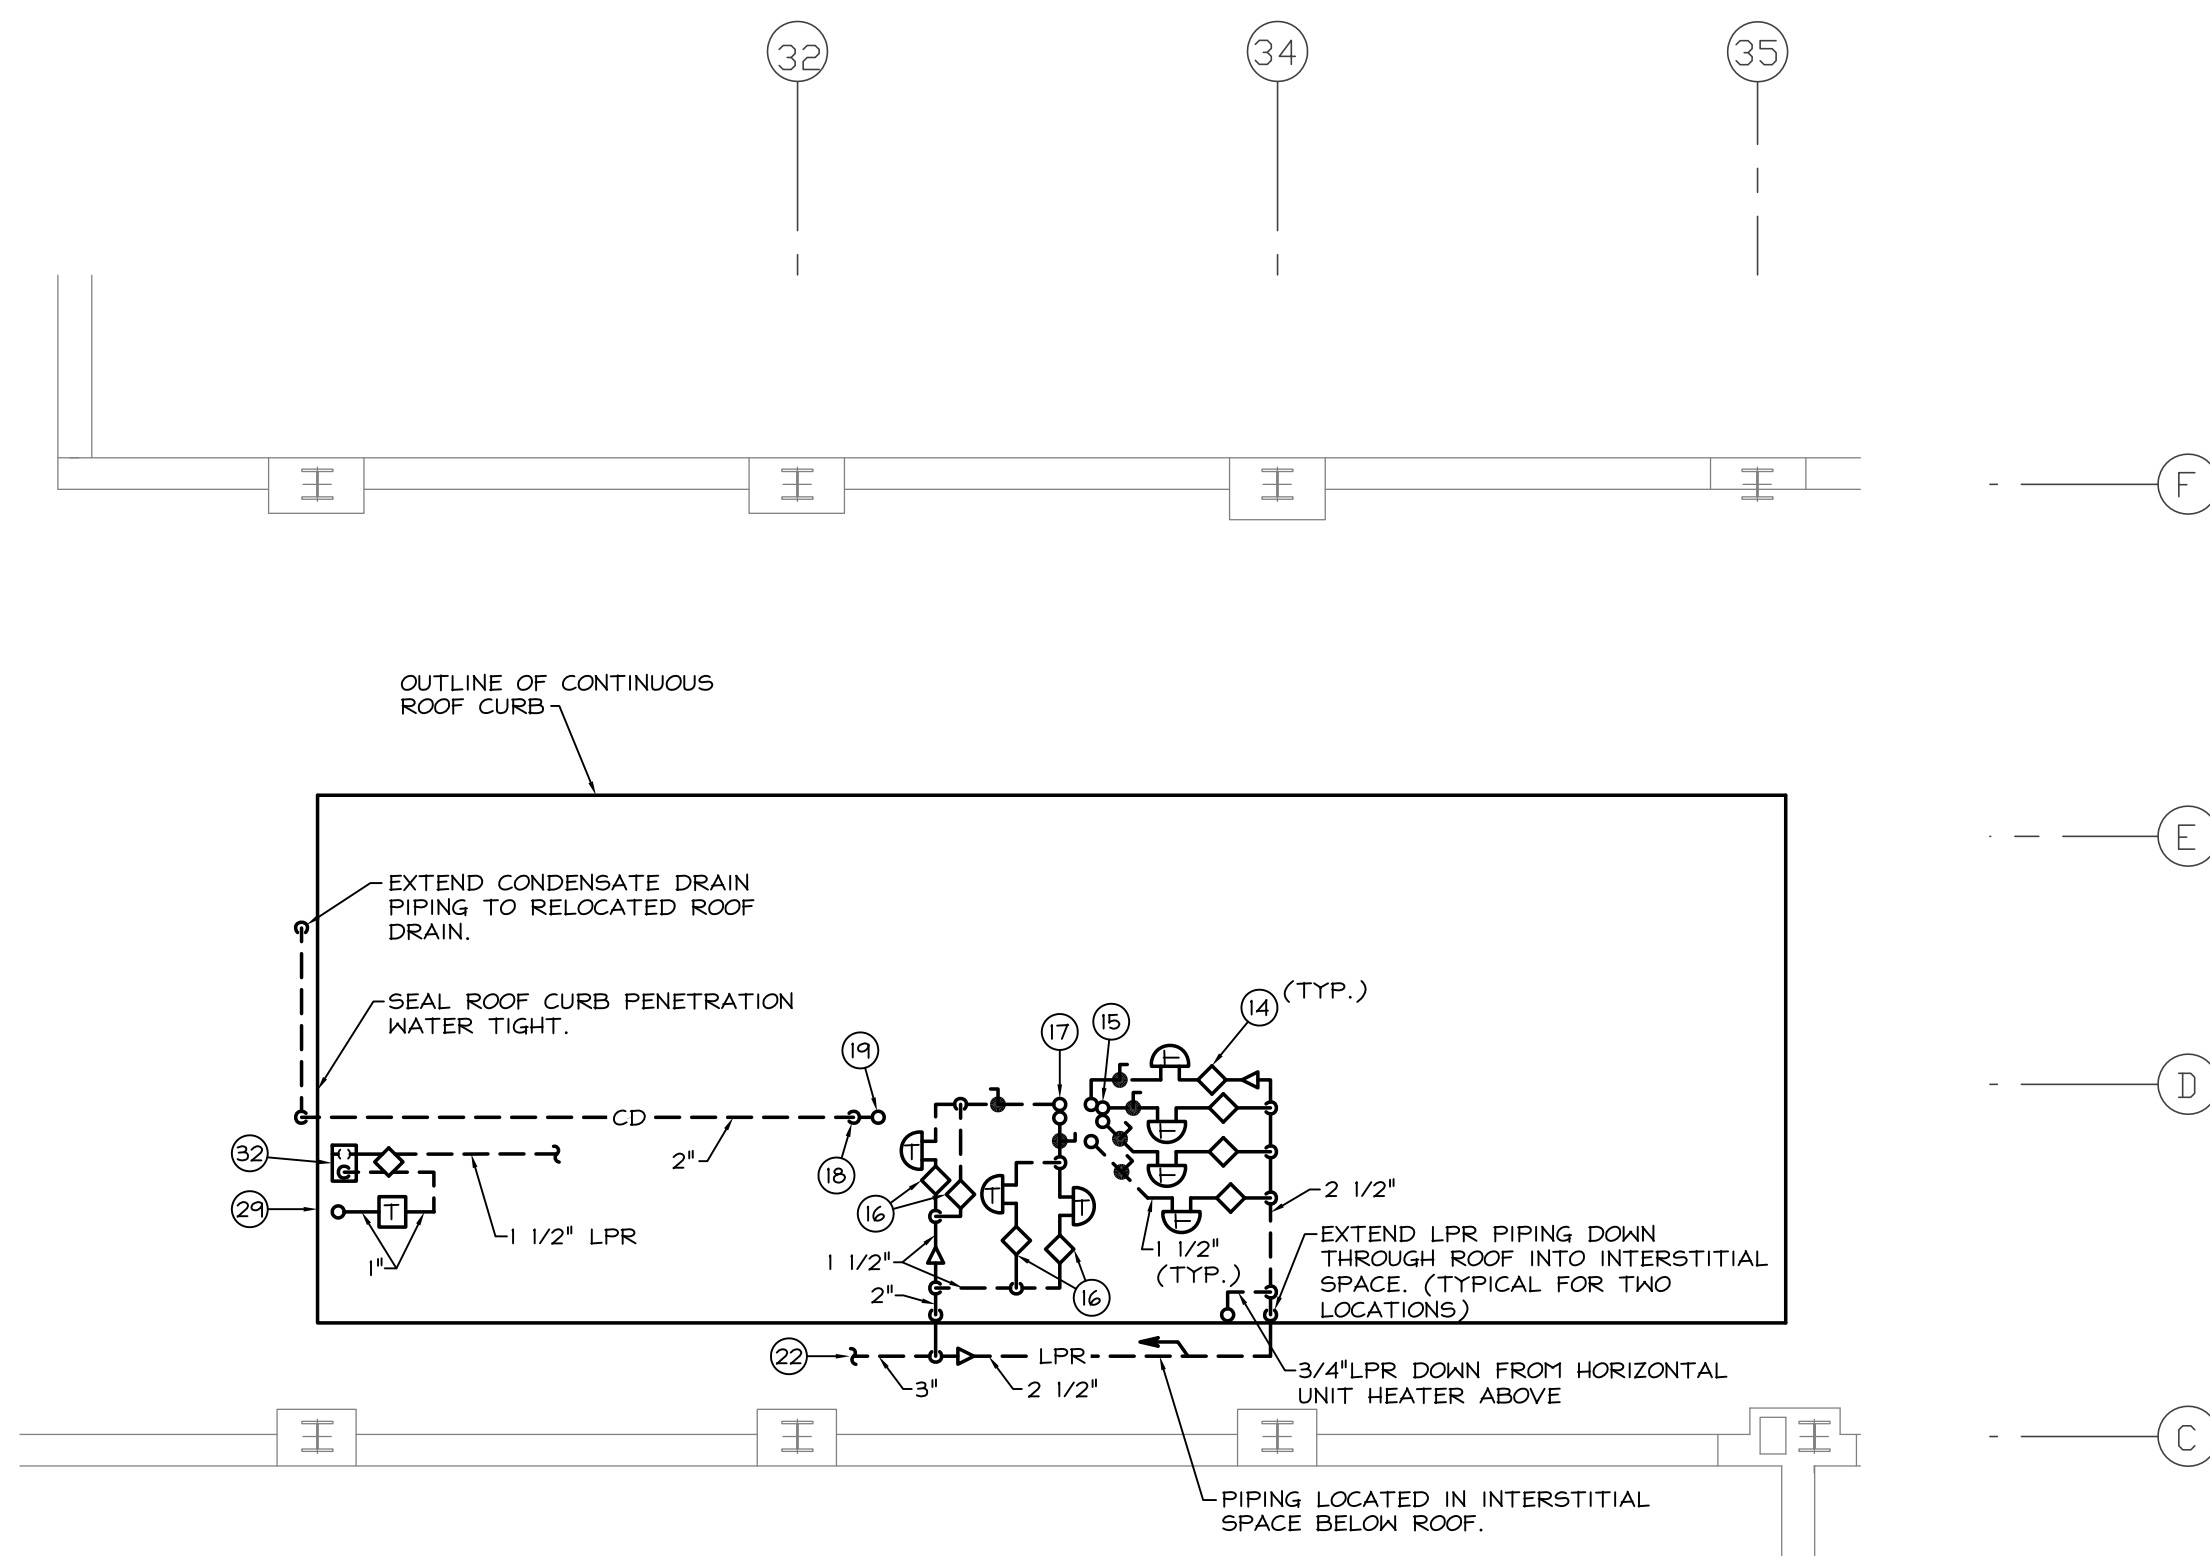

4 PARTIAL ROOF PLAN - HVAC NEW WORK - LOWER PIPING (WITHIN ROOF CURB)
SCALE: 1/8" = 1'-0"

DRAWING NOTES:

- 1 50x22\"/>

REVISIONS	DATE
RECORD DRAWINGS	12/15/08



VAPHS · UD
University Drive
Pittsburgh, PA 15240



A full service design/build construction company
436 Butler St. Pittsburgh, PA 15223 Ph: (412) 781-0119 Fax: (412) 781-2160

DRAWING TITLE PARTIAL ROOF PLAN - HVAC AND PLUMBING NEW WORK		PROJECT TITLE DESIGN BUILD - REPLACE AHU 11E, 10E, 9E, 8E & 7E		DATE 11/12/07
PROJECT NO. 646-06-112	CONTRACT NO. V244C-0017	DESIGNED BY: JVL	DRAWN BY: DRS/MJK	CHECKED BY: CEM
BUILDING NO. 1	JOB NO. XXXXX TUBE NO. XXXXX	LOCATION VAMC UNIVERSITY DR. PITTSBURGH, PA		DRAWING NO. H-4

FIRSCHING, MARSTILLER, RUSBAESKY AND WOLF
ENGINEERING, INC.
2030 ARDMORE BOULEVARD, SUITE 250
PITTSBURGH, PA 15221
(412) 271-5090 PHONE (412) 271-5193 FAX
FILE NO. 07058

