


- LEGEND**
- ⊕ WORKING POINT:
BASELINE STA 0+0
 - B-7 BORING NUMBER & LOCATION
(SEE DWG 135-52 FOR LOGS)
 - TP-8 TEST PIT NUMBER & LOCATION
(SEE DWGS 135-53 & 135-54 FOR LOGS)
 - SUBSURFACE SECTION LINE
(SEE DWG 135-54)

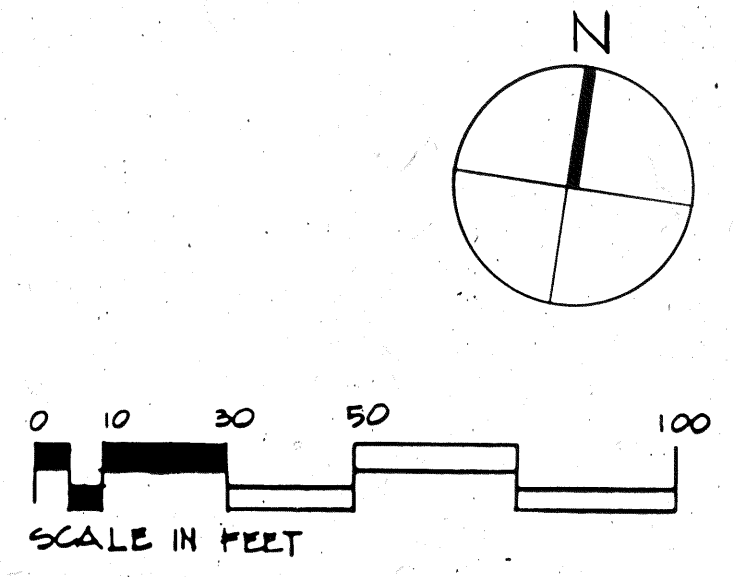

RECORD DRAWINGS Revisions 11/5/88 Date	PAULUS, SOKOLOWSKI & SARTOR Consulting Site & Structural Engineers PO Box 4039 Warren, NJ 07060 (201) 560-9700 <i>David R. Antes, PE</i> DAVID R. ANTES, PE GE 28844	KALLEN & LEMELSON Consulting Mechanical & Electrical Engineers Princeton Station Office Park 14 Washington Road Princeton Junction, NJ 08550 (609) 799-8336	The Hillier Group Architecture, Planning, Interior Design CN 23 777 Alexander Road Princeton, NJ 08540 (609) 452-8888	Drawing Title BORING AND TEST PIT LOCATION PLAN SCALE: 1"=30'	Project Title 240 Bed Nursing Home Care Unit	Date 16 JULY 1985
				Approved Project Director <i>[Signature]</i>	Building Number 135 Checked TRH Location VAMC Lyons, New Jersey	Project No. 604-064 DRAWING NO. 135-B1 Dwg. Of

Veterans Administration