
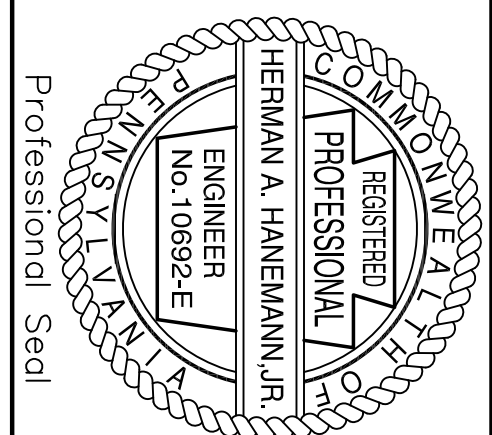


1. FOR SYMBOL AND ABBREVIATIONS, REFER TO DRAWING EO 0.
 2. EACH UNDER-CURRENT PROTECTION DEVICE INDICATED IS BASED SOLELY ON DATA ACCUMULATED DURING SURVEY. CONNECTED LOADS HAVE NOT BEEN CONFIRMED DUE TO SCOPE OF WORK LIMITATIONS, TYPICAL FOR EACH.
 3. ALL ELECTRICAL EQUIPMENT AND WIRING SHOWN IN A LIGHT LINE IS EXISTING TO REMAIN, UNDER THIS CONTRACT.
 4. ALL ELECTRICAL EQUIPMENT AND WIRING SHOWN IN A DARK, SOLID LINE IS NEW WORK UNDER THIS CONTRACT.
 5. JUNCTION AND PULL BOXES ARE NOT NECESSARILY SHOWN ON THIS DRAWING AND SHALL BE PROVIDED WHEN NECESSARY AND SIZED IN ACCORDANCE WITH THE NATIONAL ELECTRIC CODE AND INSTALLED WHERE REQUIRED.
- UNLESS OTHERWISE NOTED ALL DEVICES ARE THREE (3) PHASE.

AS-BUILT SET

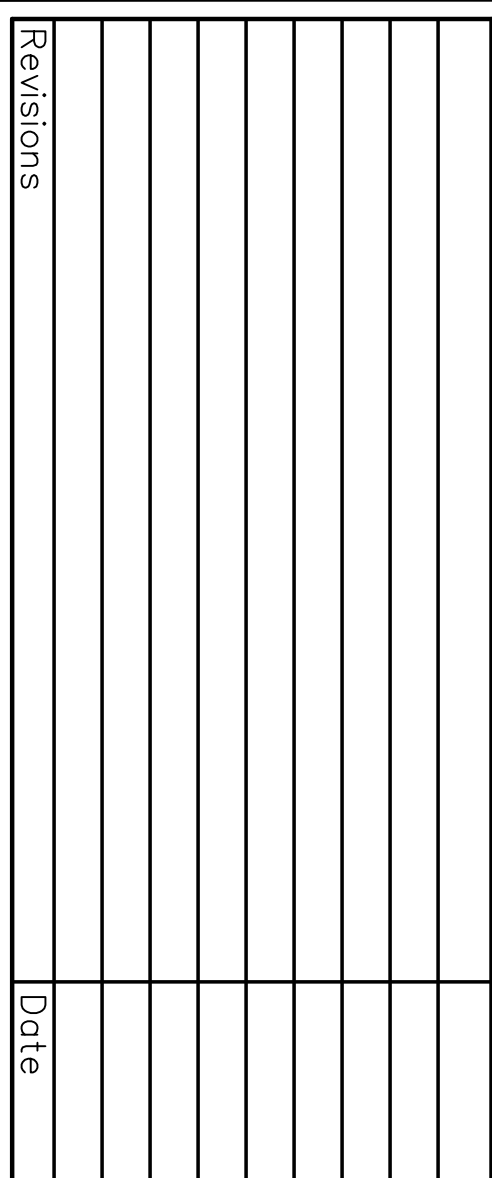

ENGINEER:

GARY TRAVINSKI ASSOCIATES



94 BOSTON HILL - LARKSVILLE, PENNSYLVANIA 18651 - Telephone: (570) 779-7843 - WWW.GTAENGCS.COM

the

SLD-NEW/EXIST.
ELECTRICAL DISTR.


REPLACE ELECTRICAL SWITCHES AND

Date 01-28-11

-07-101

三

Dwg. - of -

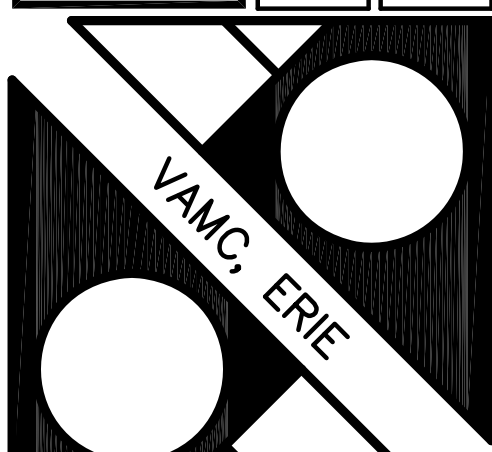

Department of
Veterans Affairs