


DRAWING NOTES:

1. LAYOUT SHOWN IS FOR SCHEMATIC PURPOSES ONLY. FINAL FRAMING LAYOUT IS THE RESPONSIBILITY OF THE CFMF FABRICATOR.



2. SIZES AND GAGES SHOWN ARE MINIMUM REQUIRED FOR THE SCHEMATIC LAYOUT SHOWN. FINAL SIZES AND GAGES TO BE PROVIDED BY CFMF FABRICATOR.

3. CFMF FABRICATOR TO DESIGN ALL CONNECTIONS. REFER TO ARCHITECTURAL DRAWINGS FOR WORK POINT AND ROOF SLOPE INFORMATION AND FOR EXTENT OF EXISTING ROOFING DEMOLITION AND REMO



- CFMF ROOF FRAMING KEY NOTES:** (X)
1. EXISTING ROOF TO REMAIN.
2. 10" 14 GA. MINIMUM CFMF RAFTERS AT 24" O.C. PROVIDE BRIDGING AS REQUIRED.
3. CFMF TRUSSES AT 24" O.C. PROVIDE BRIDGING AS REQUIRED.
4. CFMF TRUSS TO SUPPORT GABLE RIDGE.
5. 16" 12 GA. MINIMUM I OR BOXED SHAPED CFMF RIDGE MEMBER.
6. 16" 12 GA. MINIMUM I OR BOXED SHAPED CFMF VALLEY MEMBER.
7. CFMF WALL WITH 6" 16 GA. MINIMUM STUDS AT 24" O.C. PROVIDE STRAP BRACING AS REQUIRED.
8. PROVIDE BOXED HEADER AT WALL OPENING. COORDINATE OPENING SIZE AND LOCATION WITH MECHANICAL EQUIPMENT AND DUCTWORK.
9. EXPANSION JOINT. REFER TO ARCH.
10. CUT THROUGH EXISTING ROOF SHEATHING TO ALLOW ANCHORAGE OF WALL STUDS TO TRACK ALONG EXISTING CONCRETE SLAB.
11. REFER TO S/S301 FOR FRAMING AT LOUVER.

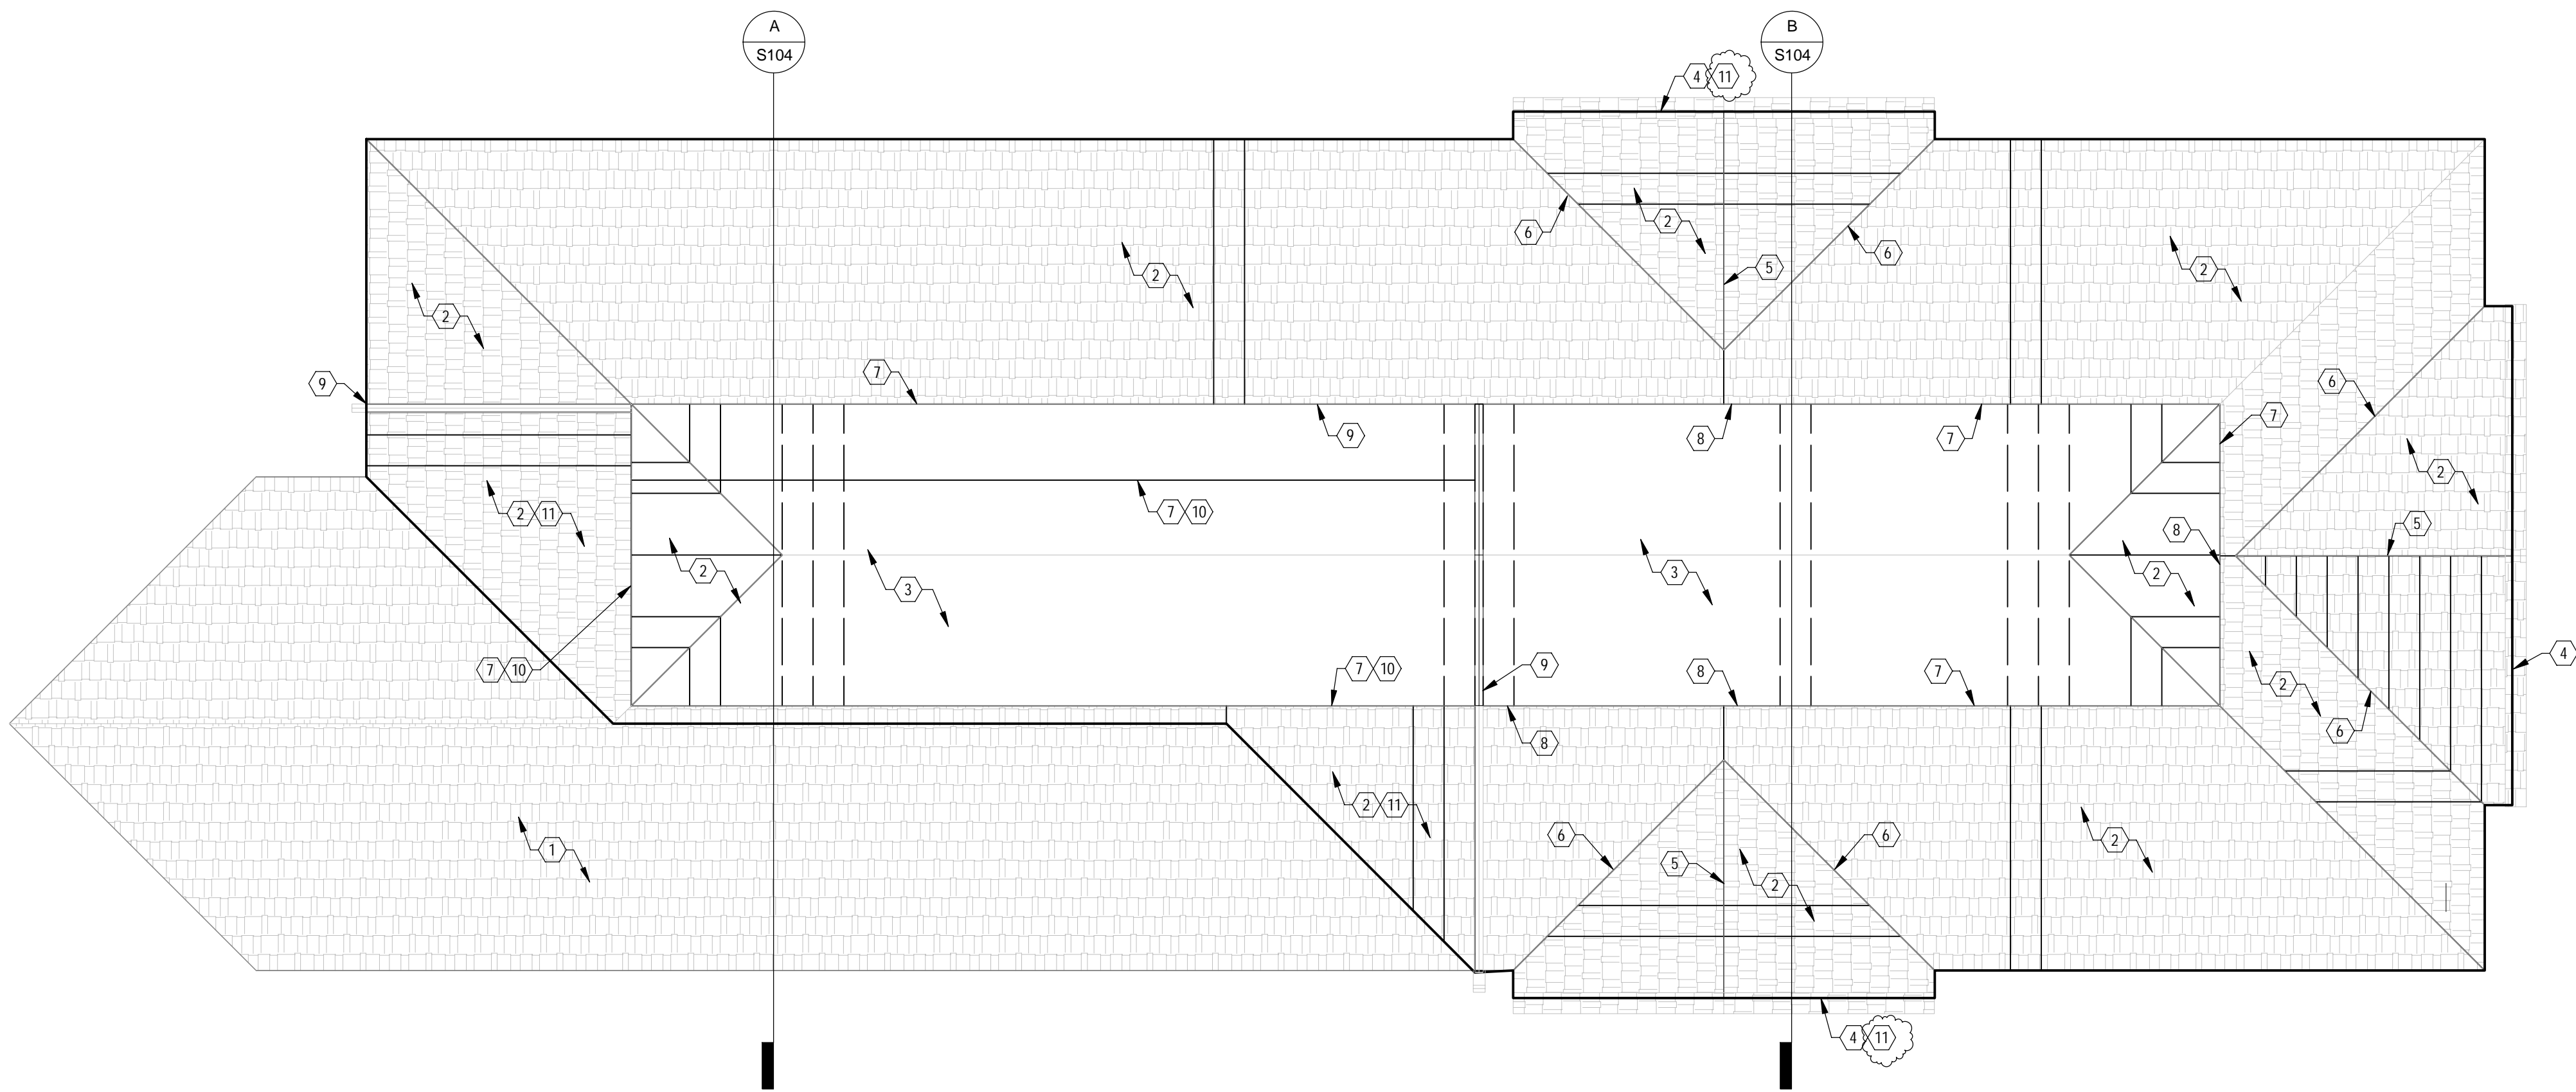


1 SCHEMATIC ROOF FRAMING PLAN
1/8" = 1'-0"

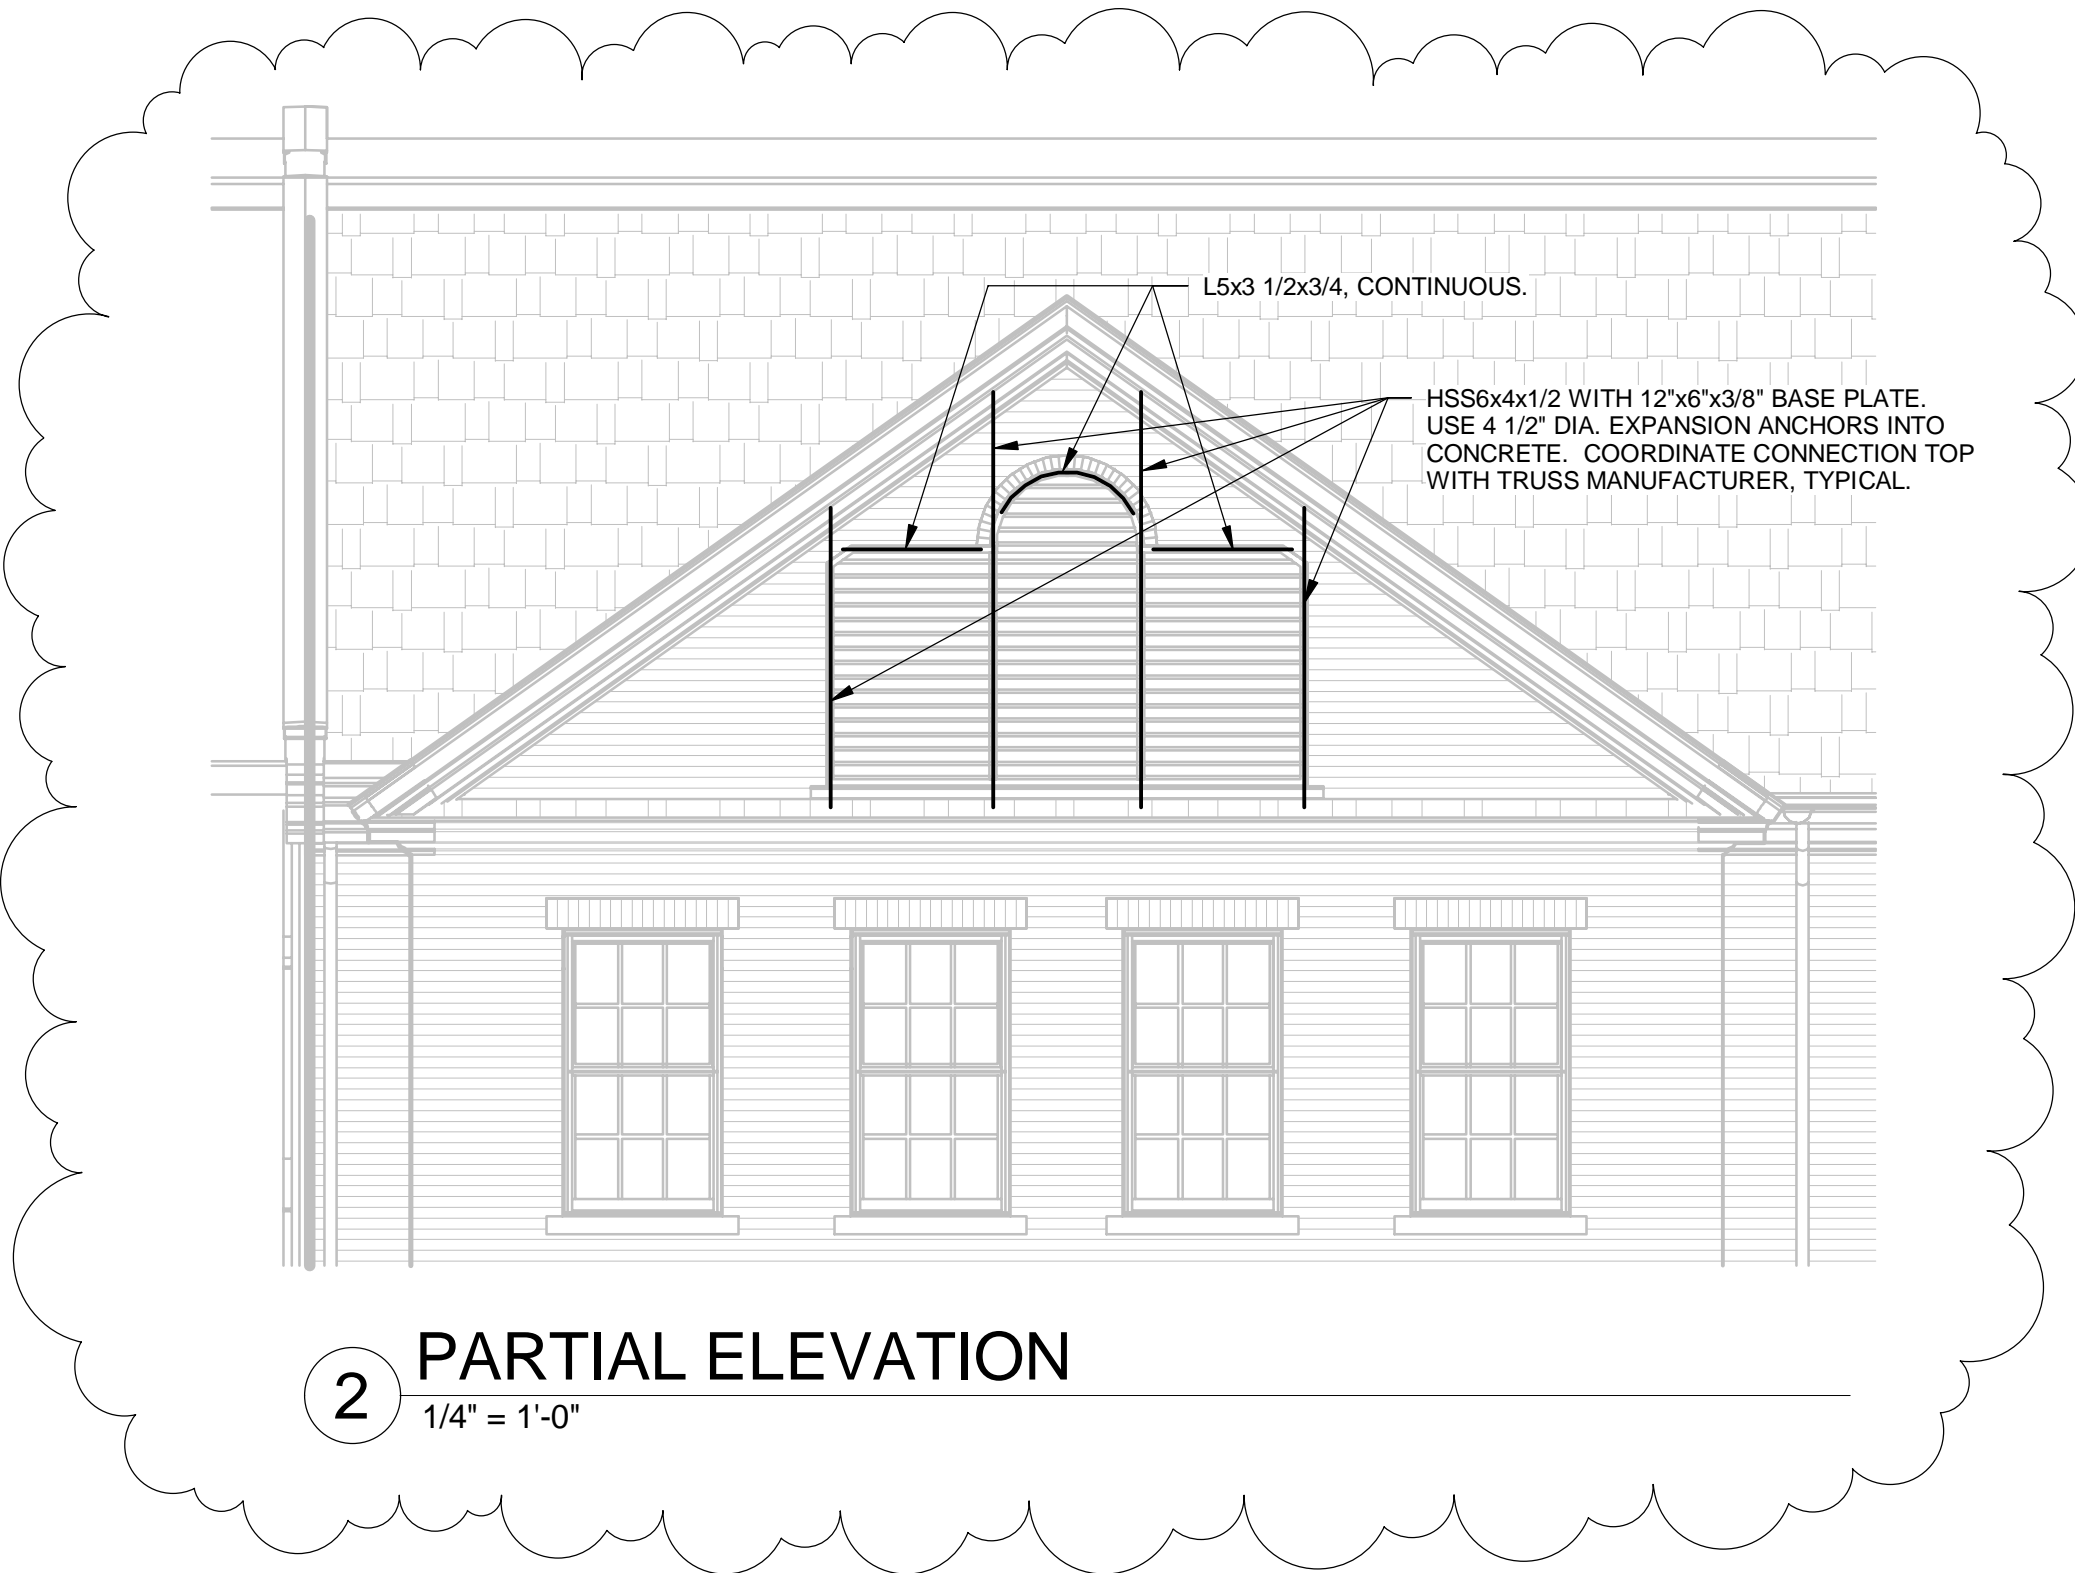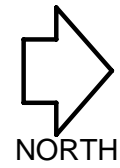


2 PARTIAL ELEVATION
1/4" = 1'-0"

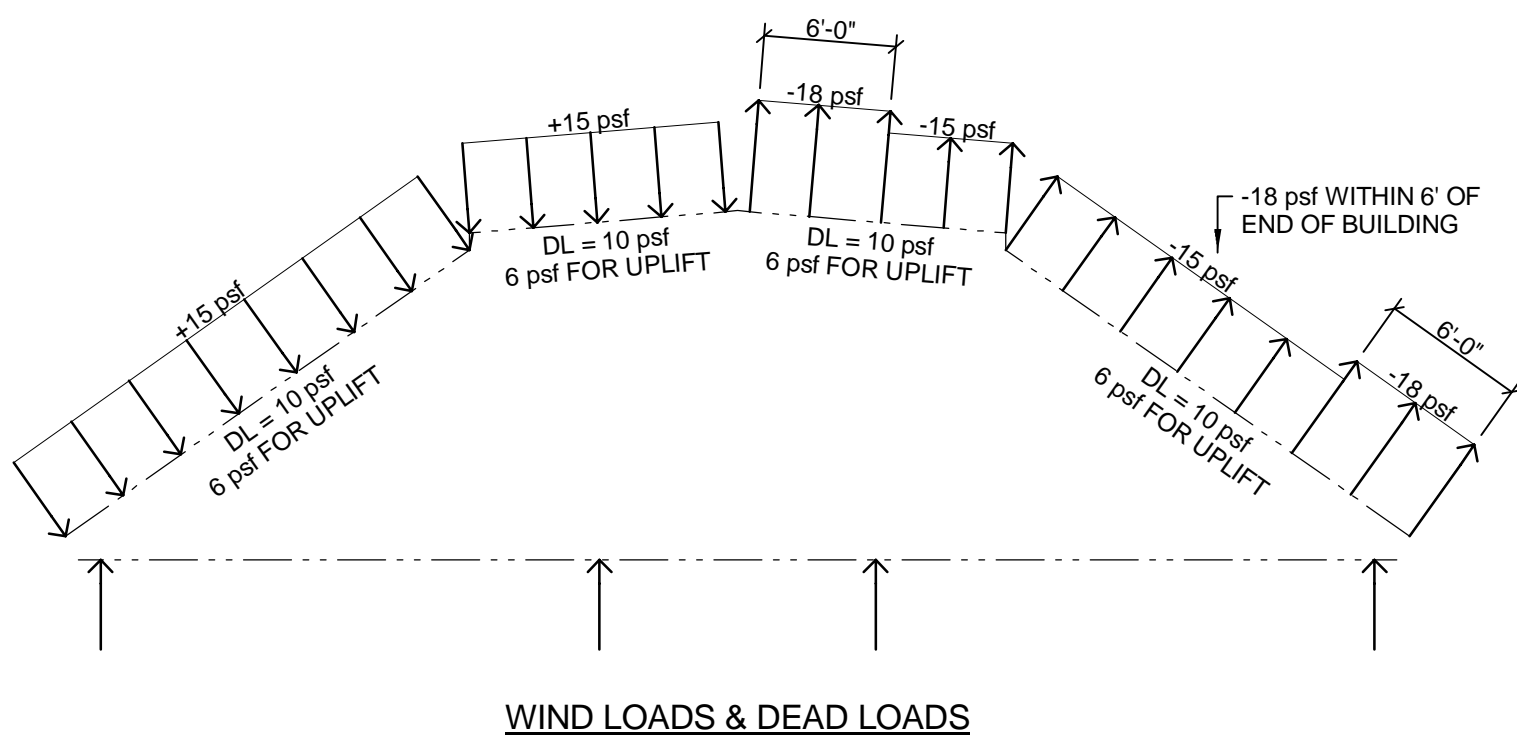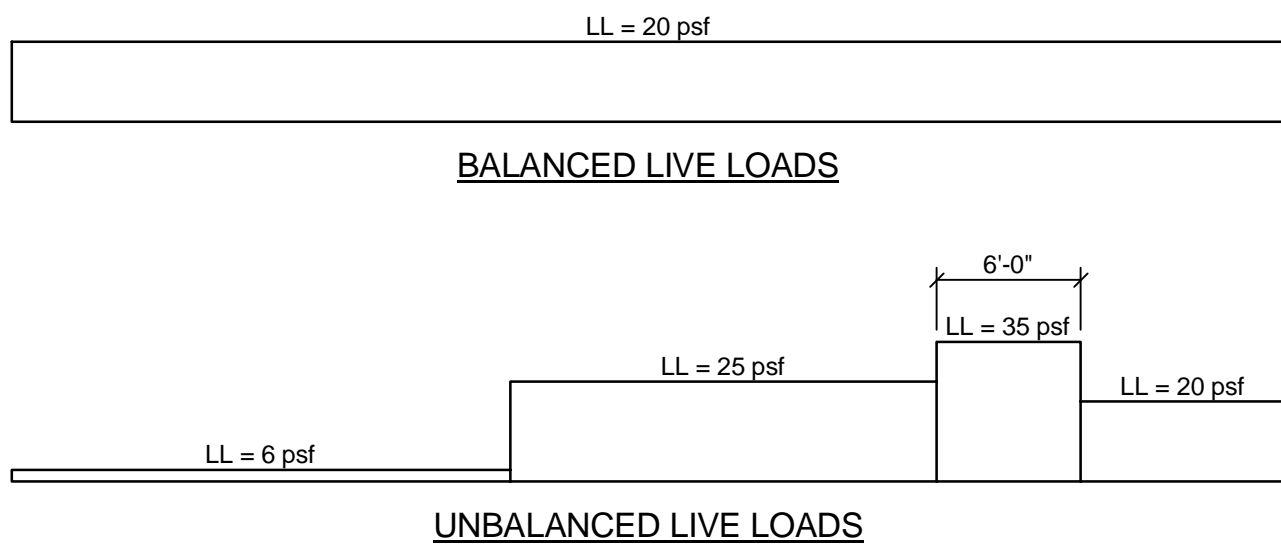



WIND LOADS & DEAD LOADS

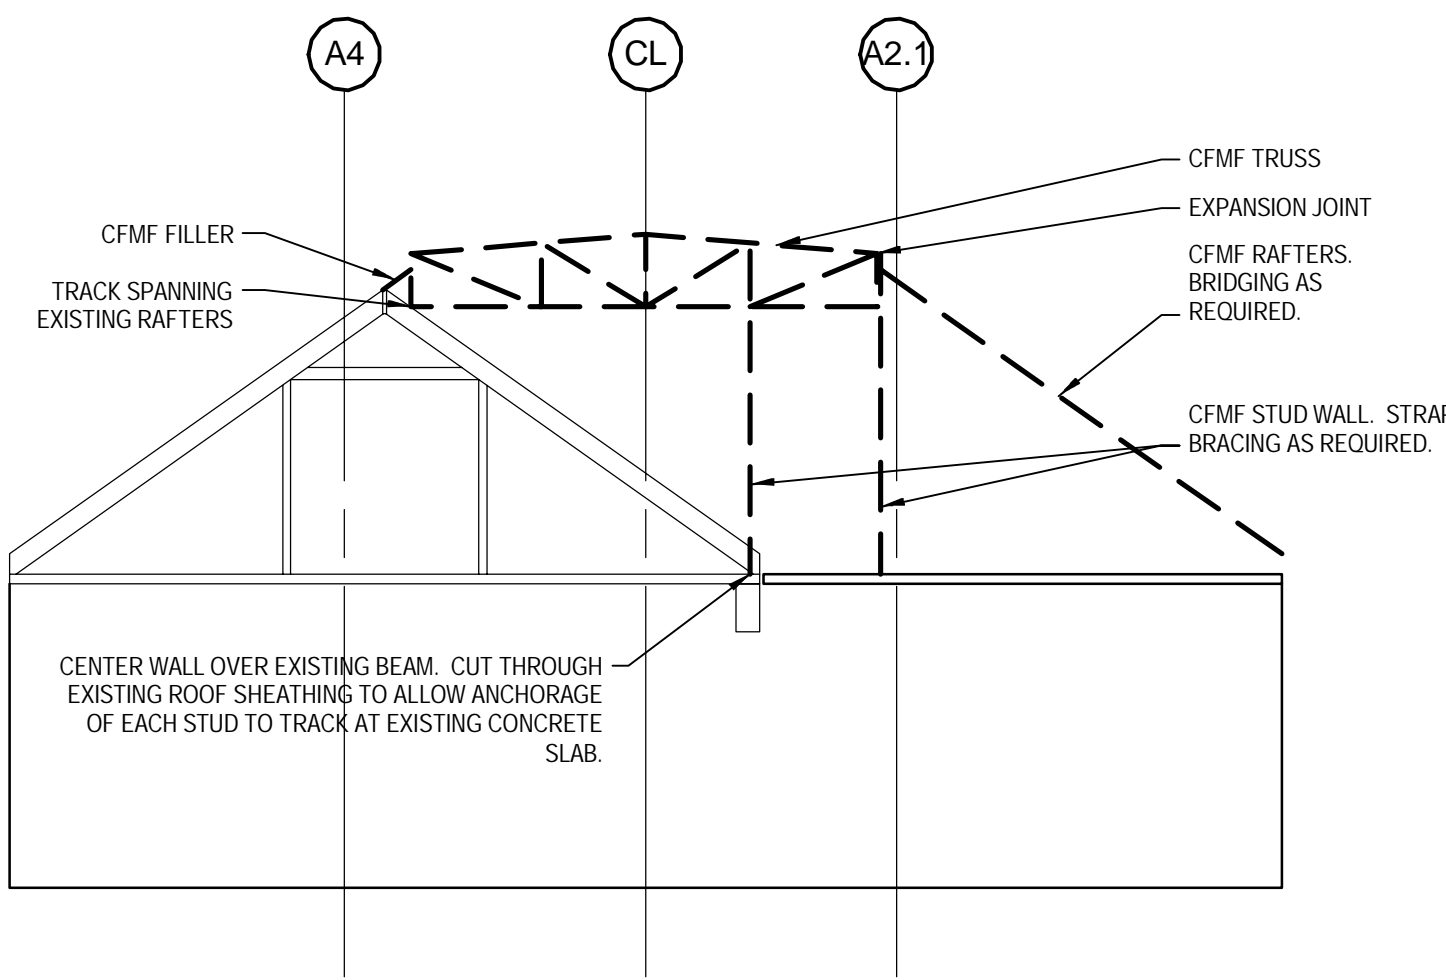

A DETAIL
1/8" = 1'-0"

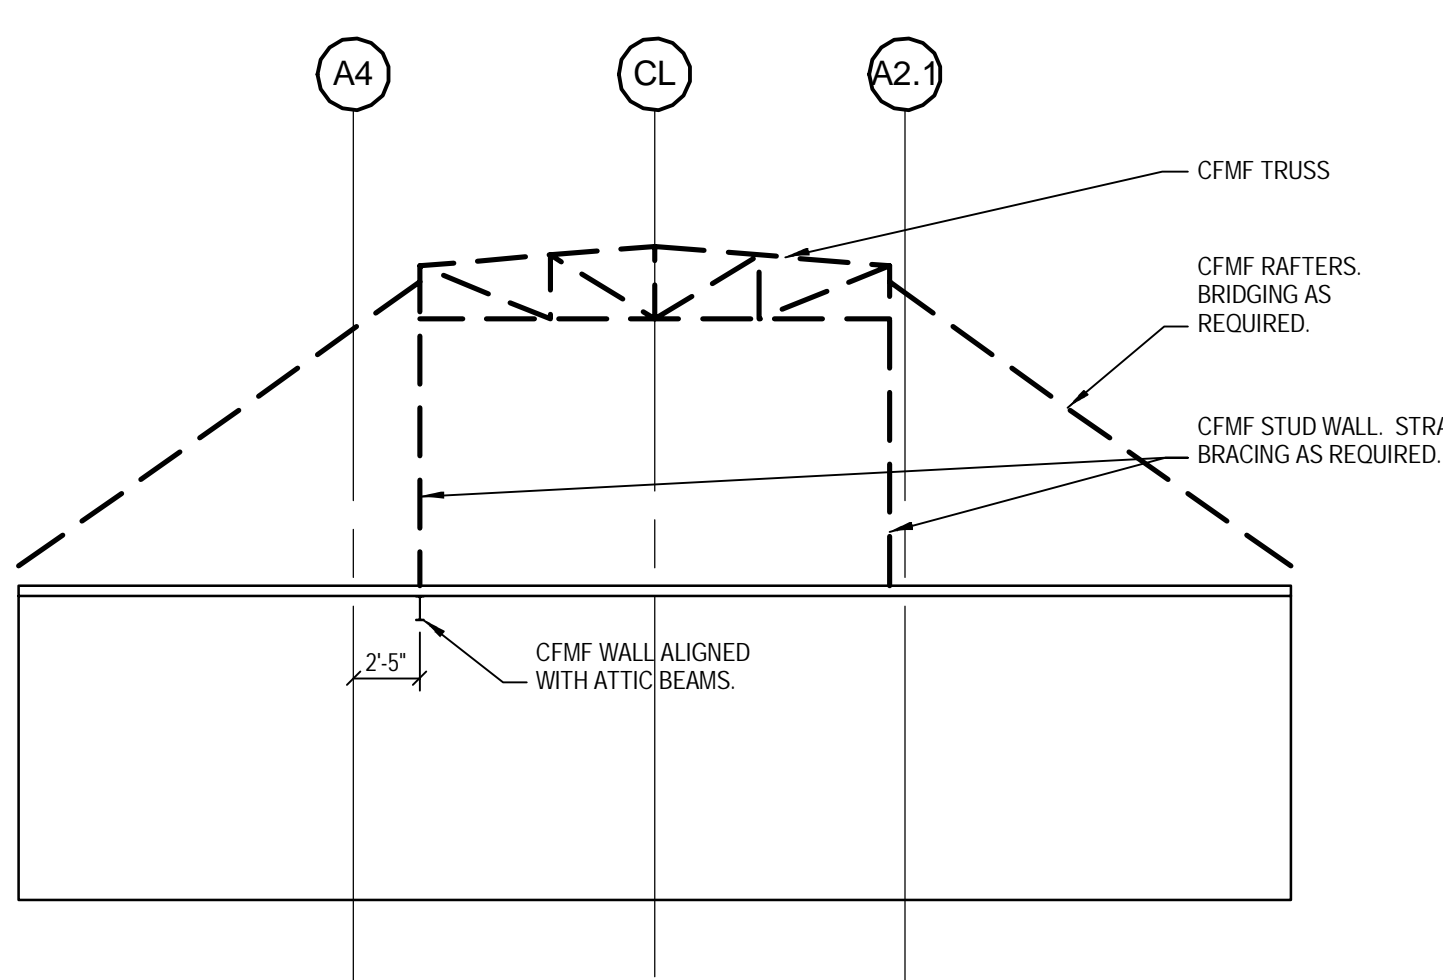

B DETAIL
1/8" = 1'-0"

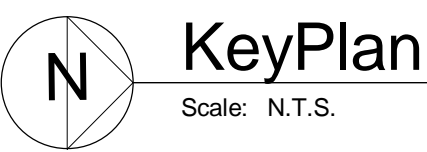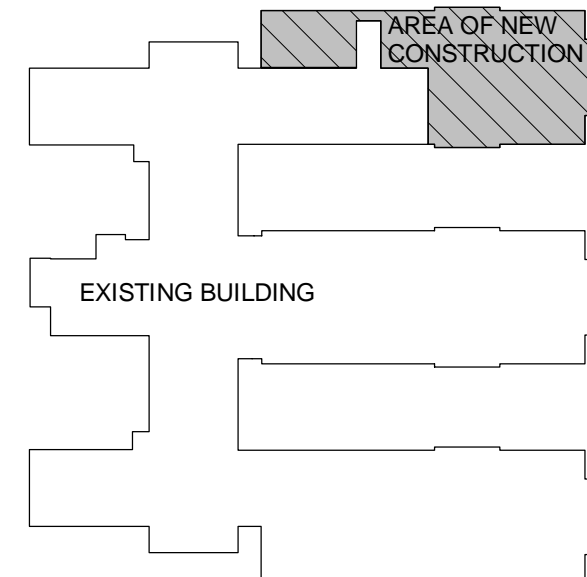

KeyPlan
Scale: N.T.S.

1	Bid Documents	9/6/13
2	Addendum #1	9/11/13
Revisions		Date

CONSULTANTS:

THP

THP Limited, Inc.
100 East Eighth Street
Cincinnati, Ohio 45202
Phone: 513.241.3222
Fax: 513.241.2981
www.thpltd.com

ARCHITECT/ENGINEERS:

JOHN POE ARCHITECTS

116 EAST THIRD STREET
DAYTON, OHIO
45402-2130

937 461 3280 PHONE
937 461 0280 FAX
jpa@johnpoe.com

Drawing Title

ROOF FRAMING PLAN

Approved: Project Director

Project Title

**Renovate CLC
Building 211 West**

Location
Chillicothe, Ohio

Date
Sept. 6, 2013

Checked
MCC

Drawn
MRB

Project No.
VA Project No. 538-107
JPA Project No. 11001.00

Building Number
211

Drawing Number
S104

Dwg. 52 of 132

**Office of
Construction
and Facilities
Management**

**Department of
Veterans Affairs**