


IF THIS SHEET IS NOT 30" x 42" FULL SIZE, USE GRAPHIC SCALES







one inch = one foot
 three-quarter inch = one foot
 one-half inch = one foot
 three-eighths inch = one foot
 one-quarter inch = one foot
 one-eighth inch = one foot

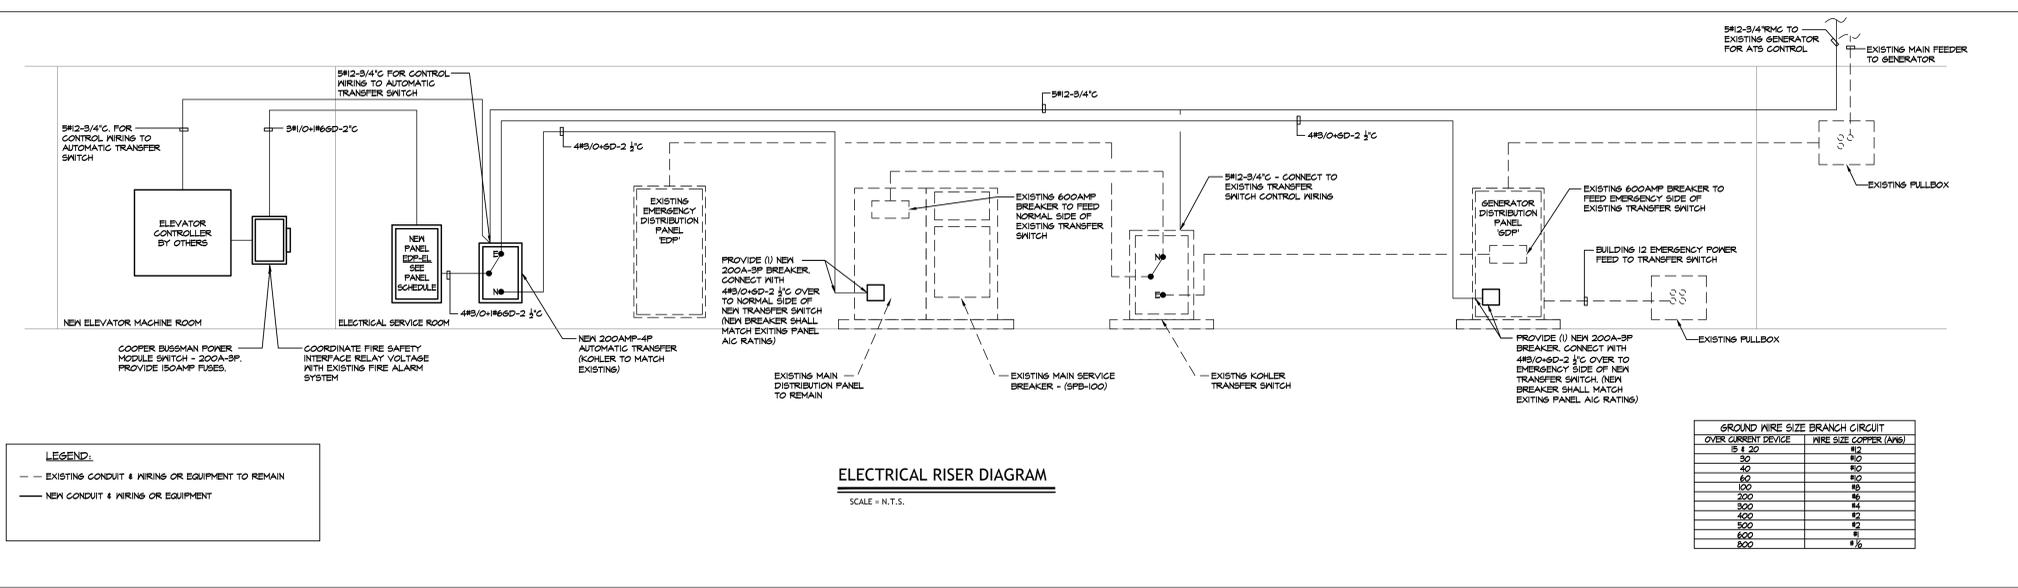

LEGEND:
 --- EXISTING CONDUIT & WIRING OR EQUIPMENT TO REMAIN
 ——— NEW CONDUIT & WIRING OR EQUIPMENT


NO.	CIRCUIT	PH	LOAD (VA)	WIRE (AWG)	CONDUIT (IN)	TRIP (AMP)	TYPE	LOC.	DESCRIPTION
1	ELEVATOR			2# 10/0-SD-2/C	20	2# 20A-SD-3/4/C			CAR LTO & FAN
2				2# 20-SD-3/4/C	20	2# 20A-SD-3/4/C			HEAT EXCHANGER
3	ACCU-G-1			2# 20-SD-3/4/C	20	2# 20A-SD-3/4/C			RECEPTACLE
4	ACCU-H			2# 20-SD-3/4/C	20	2# 20A-SD-3/4/C			DOOR OPERATOR
5	SPACE								SPACE

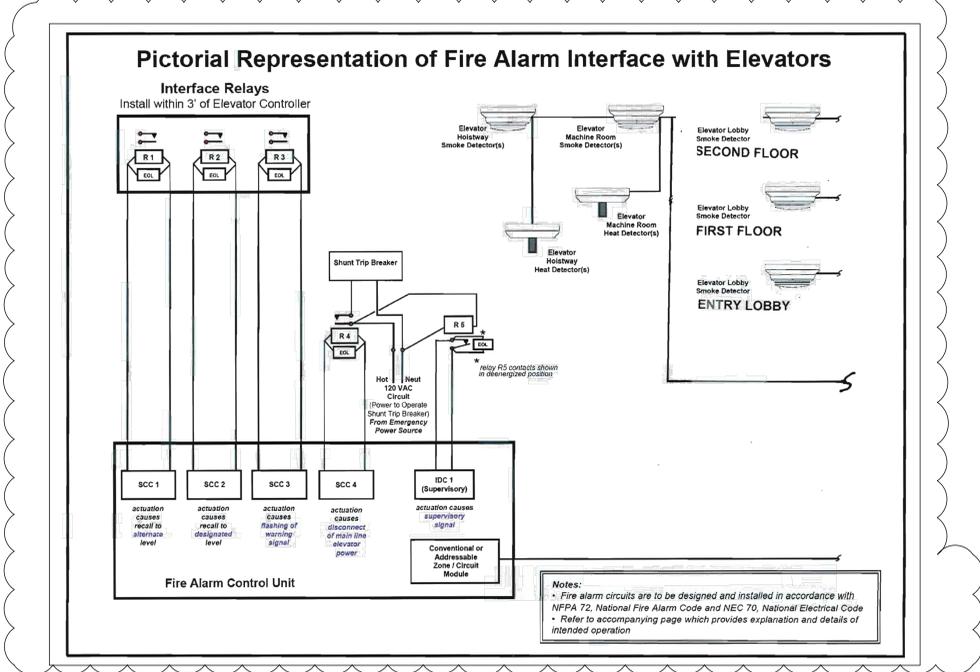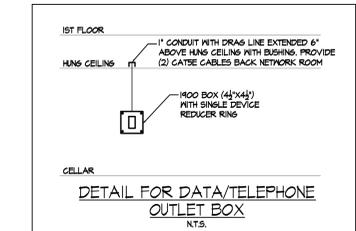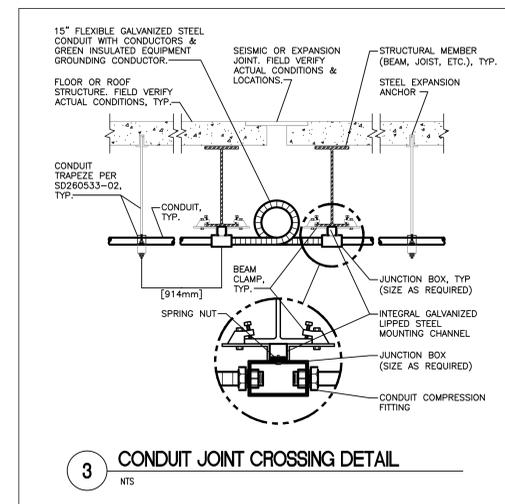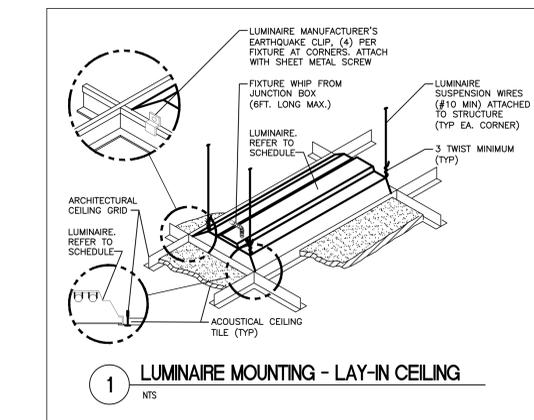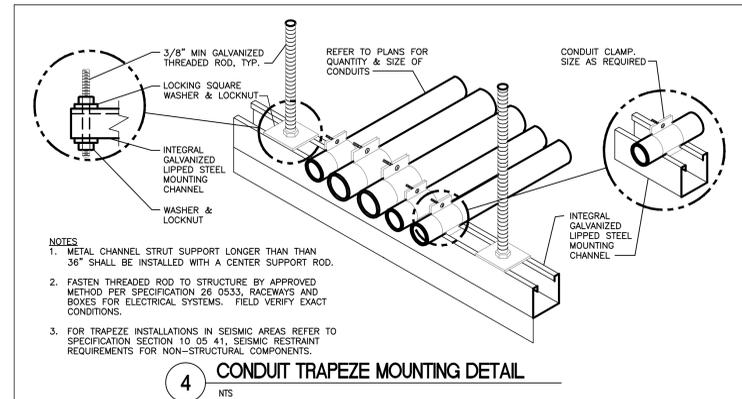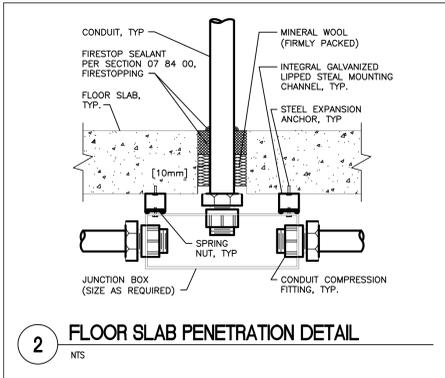

EMTG Consulting Engineers
 EMTGENGINEERS.COM
 TEL: 212-268-6465 FAX: 212-268-6467
 115 WEST 30TH ST. SUITE 202, NEW YORK, NY 10001


NOTE AND READ CAREFULLY:
 The Contractor shall consult and study the requirements of each and every drawing and each specification section of this contract so that he/she may become acquainted with the project as a whole in order to determine how the work of his/hers subcontractor or vendor may affect the work required under this contract.
 Written Specifications are part of this contract.

Drawing Title
ELECTRICAL RISER DIAGRAMS AND DETAILS
 Approved: Division Chief
 Approved: Service Director

Project Title
PROVIDE HANDICAP ACCESS BUILDING 10 VANJHCS LYONS CAMPUS Lyons, NJ. 07939
 Building Number: 10
 Location: Lyons, New Jersey

Date: 4/5/2013
 Project No.: 561A4-10-102
 DRAWING NO.: EP103
 Dwg. 24 Of 24

