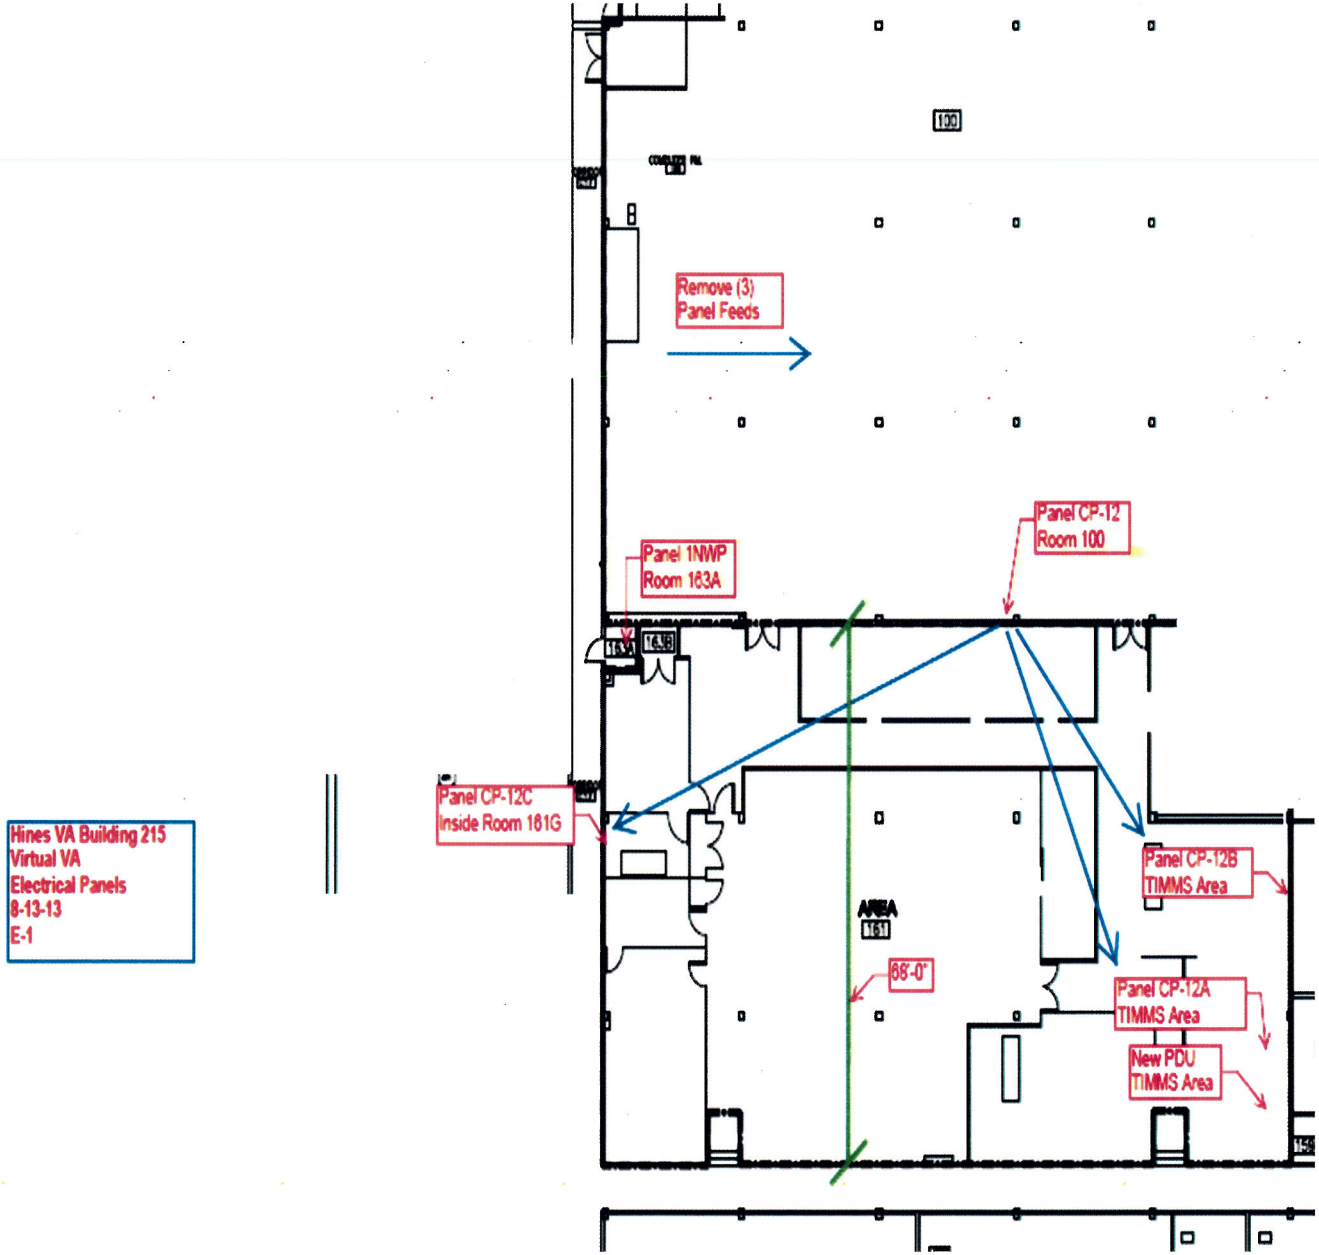Attachment D: Electrical Panels Layout Existing Feeds